P.I. STA. 78+08.43 ℄ A=
269°29'28" RT.
B.O.L. STA. 10+00.00 ℄ M
89°14'30" RT.

MH. #70
~~STA. 78+00,~~
~~3'~~ LT. ℄ A

P.O.T. STA. 78+20.80 ℄ A=
180°00'00" RT.
B.O.L. STA. 10+00.00 ℄ L
89°48'13" RT.

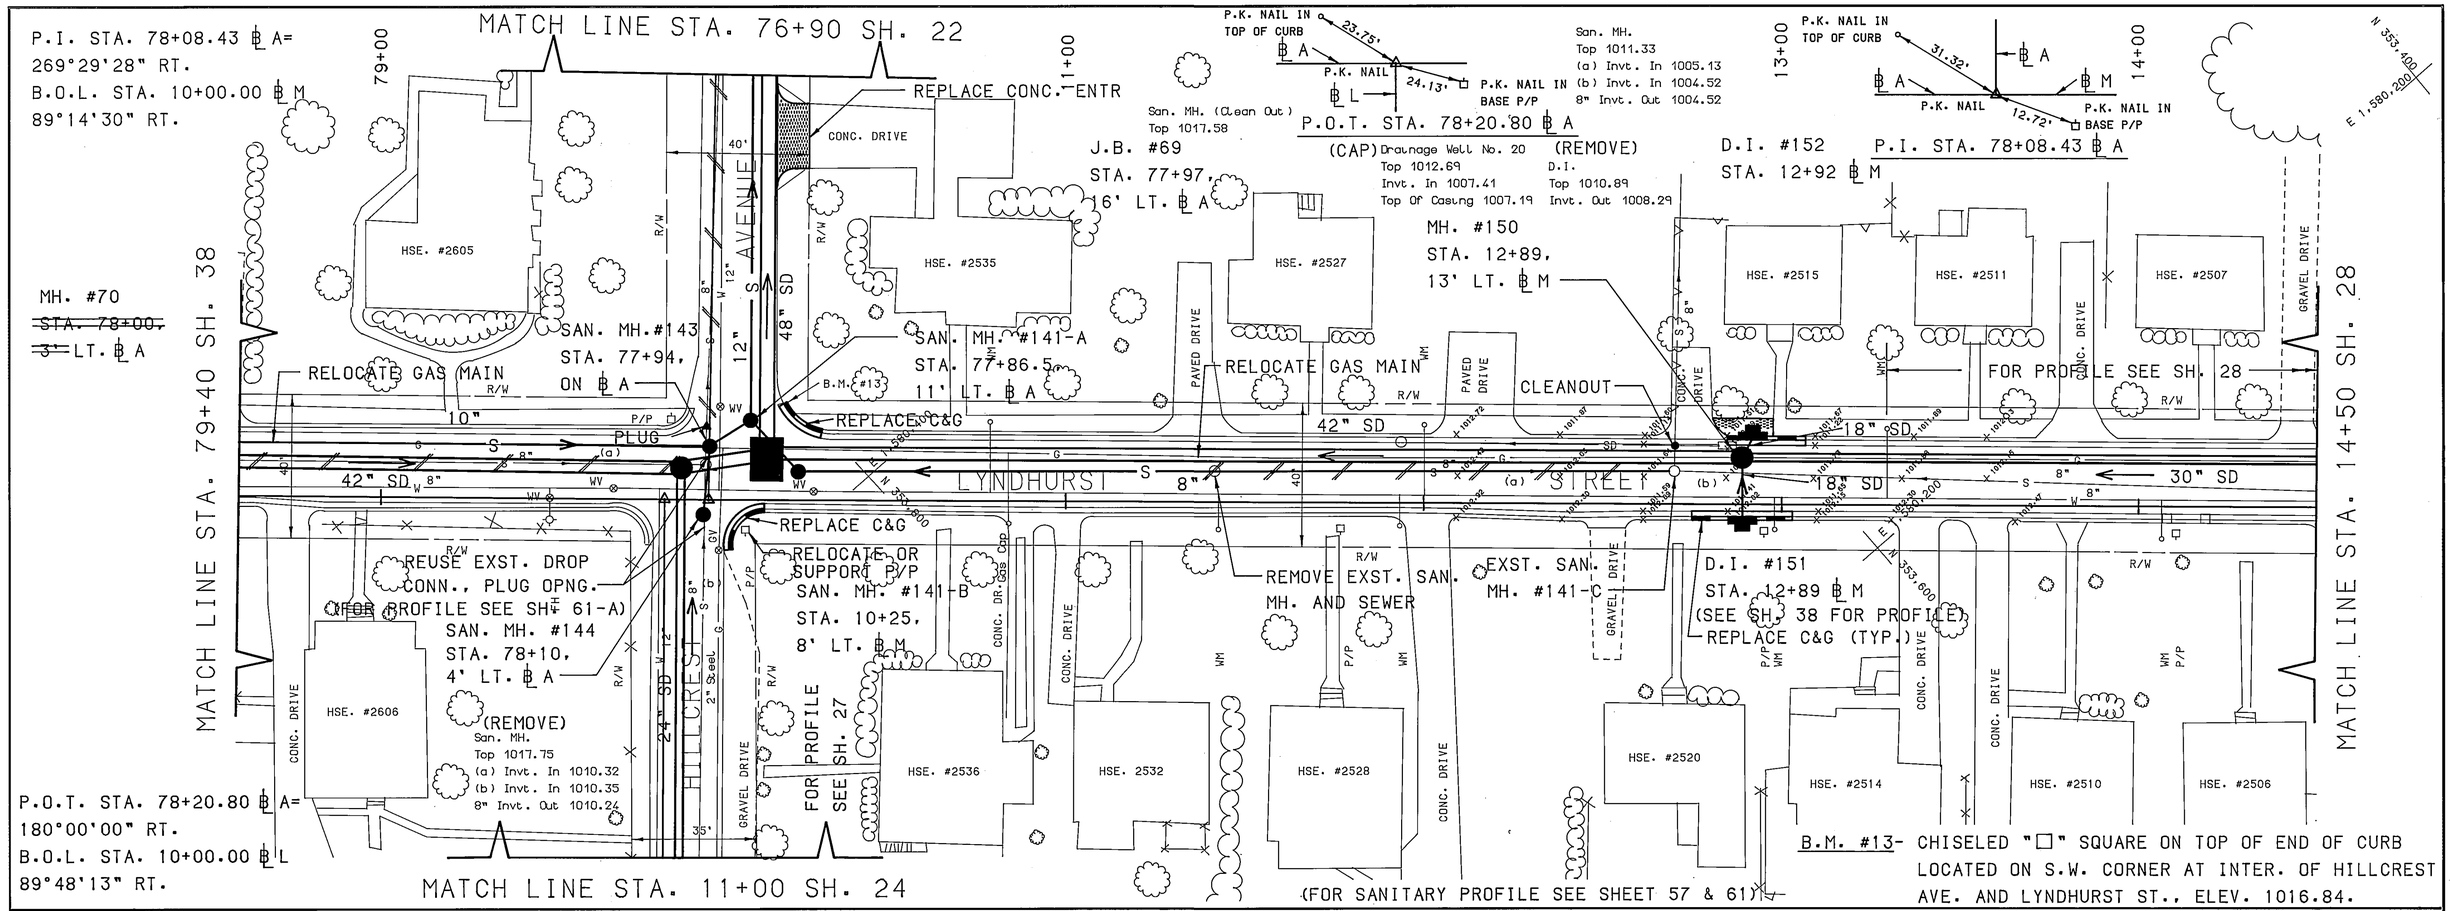

B.M. #13- CHISELED "□" SQUARE ON TOP OF END OF CURB LOCATED ON S.W. CORNER AT INTER. OF HILLCREST AVE. AND LYNDHURST ST., ELEV. 1016.84.

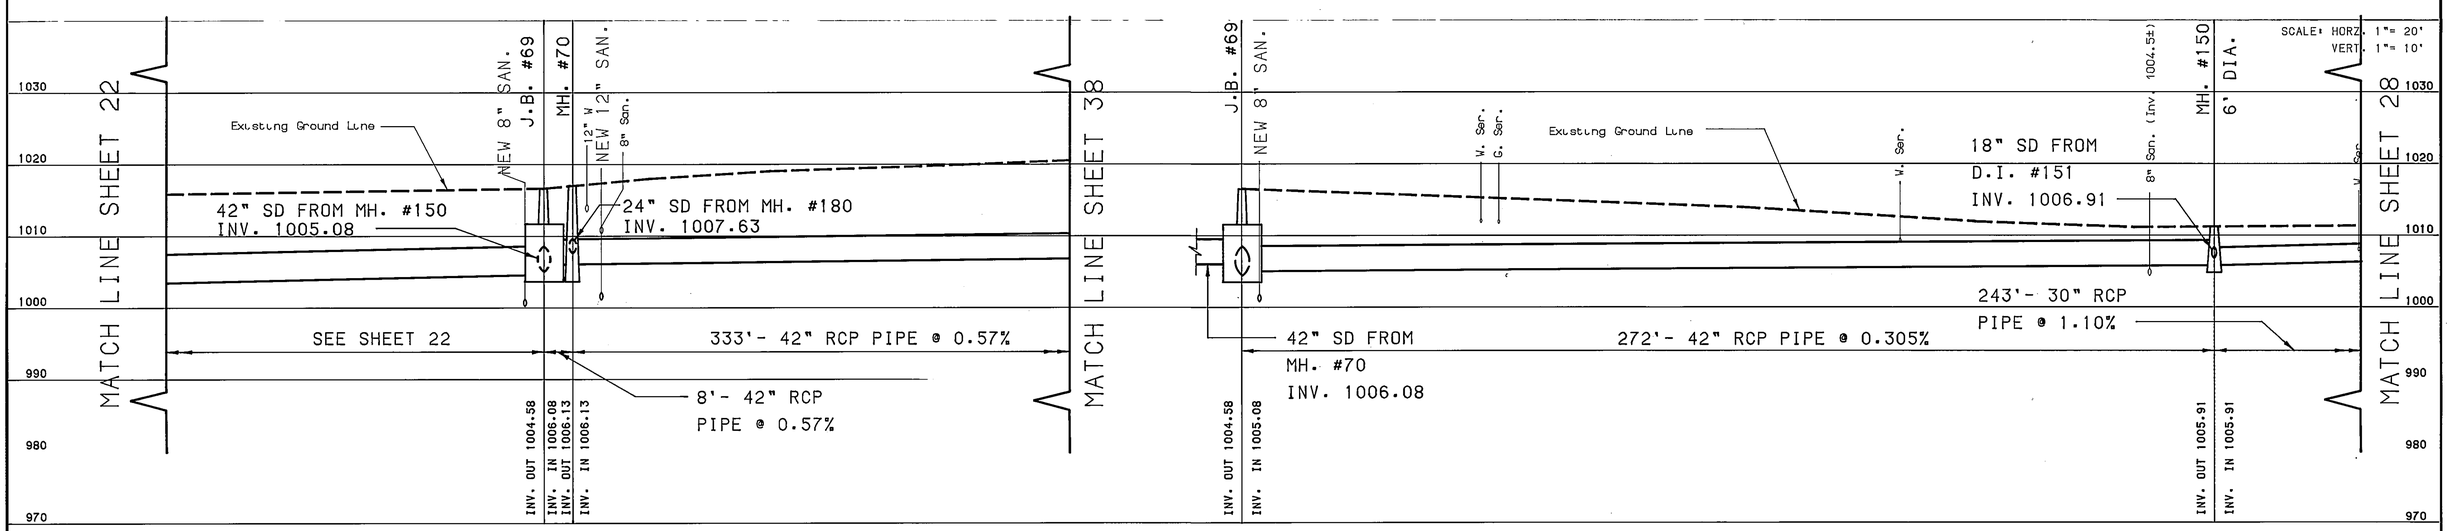

Mattern & Craig
CONSULTING ENGINEERS - SURVEYORS
701 FIRST STREET, ROANOKE, VIRGINIA 24016, (703) 345-9342

DESIGNED: ARB/SWH
CHECKED: GRN
APPROVED:

COMMONWEALTH OF VIRGINIA
STEWART W. HUBBELL
No. 07420
PROFESSIONAL ENGINEER

NORTH

REVISION	DATE	DESCRIPTION	BY	APP.
1	DEC. 89	RECORD DRAWING	JLJ	SWH

DATE
JULY 1987
COMM.
580/581

WILLIAMSON ROAD STORM DRAIN- PHASE 2
CONTRACT II-A
ROANOKE, VIRGINIA

PLAN AND PROFILE

SHEET 23

PLAN NO. 5828