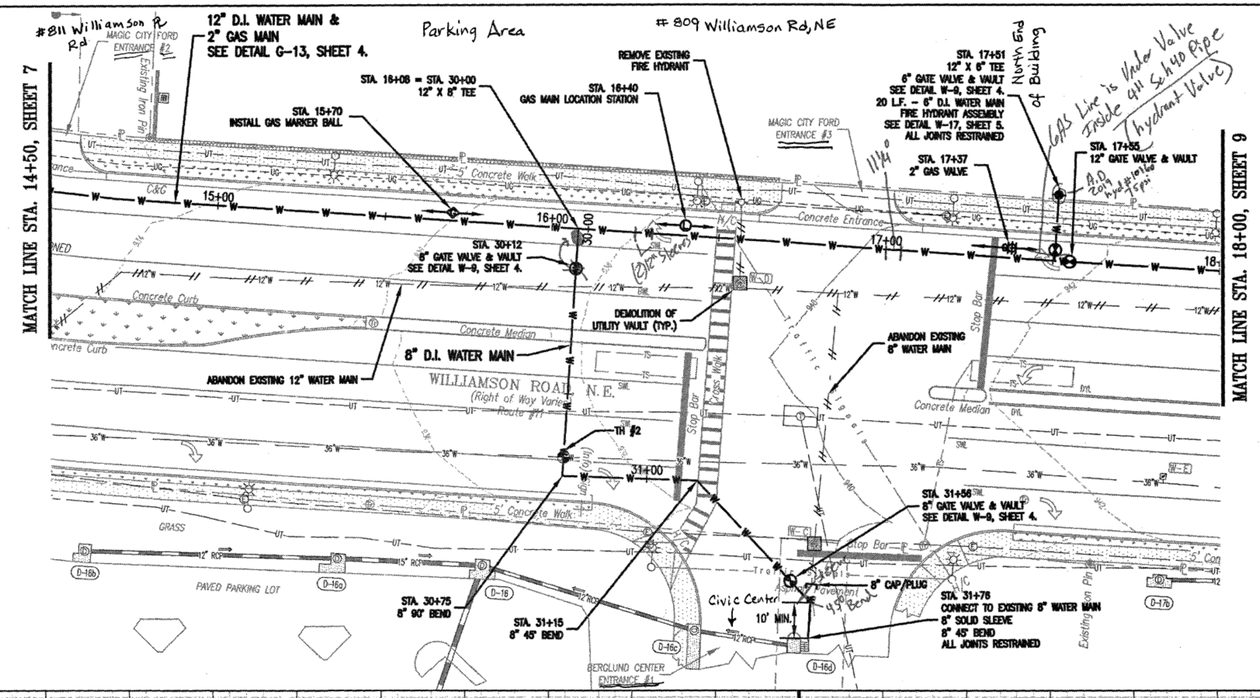

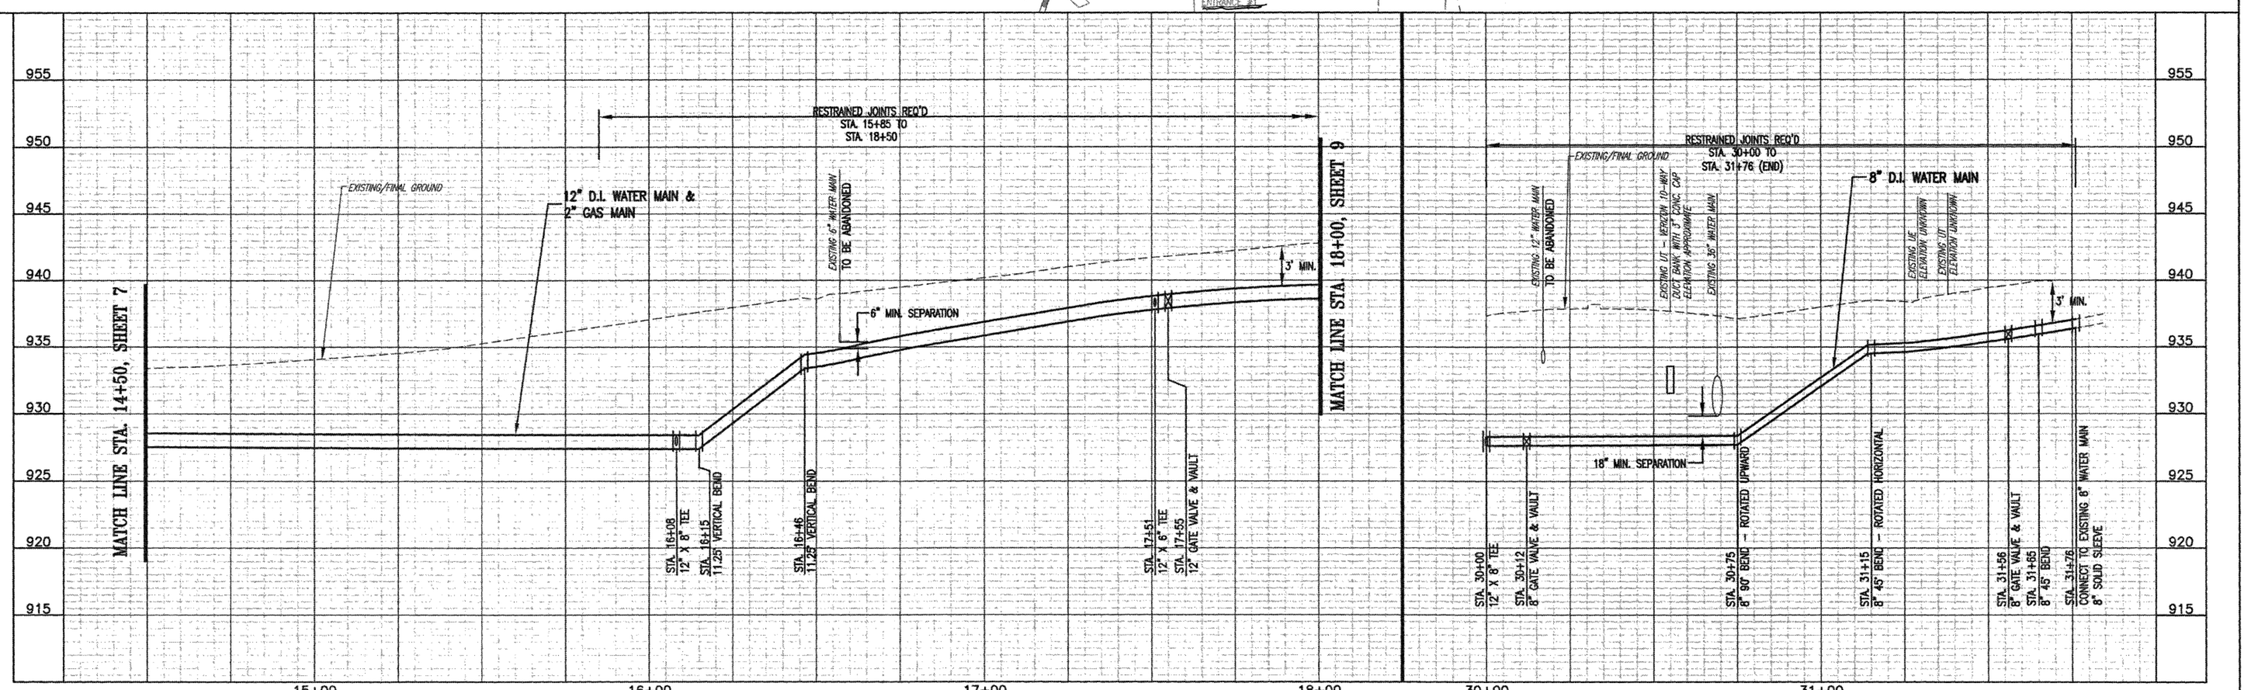

GRAPHIC SCALES

(IN FEET) HORIZ. 1 inch = 20 feet

(IN FEET) VERT: 1 inch = 5 feet

COMMONWEALTH OF VIRGINIA
PAULA J. MOORE
Lic. No. 035821
09/02/2020
PROFESSIONAL ENGINEER

Whitman, Requardt & Associates, LLP
1700 Kraft Dr, Suite 1200, Blacksburg, VA 24060

WESTERN VIRGINIA WATER AUTHORITY
601 South Jefferson Street, Suite 300
Roanoke, Virginia 24011

DES: PJM	SCALE: AS SHOWN
DRAWN: JES	HORIZ: 1" = 20'
CHECK: PJM	VERT: 1" = 5'
DATE: 9/02/2020	

WILLIAMSON ROAD
WATER MAIN REPLACEMENT &
ROANOKE GAS COMPANY GAS MAIN REPLACEMENT

12" WATER MAIN PLAN - PROFILE
STA. 14+50 TO STA. 18+00

REV	DATE	DESCRIPTION

DRAWING	SHEET
–	8