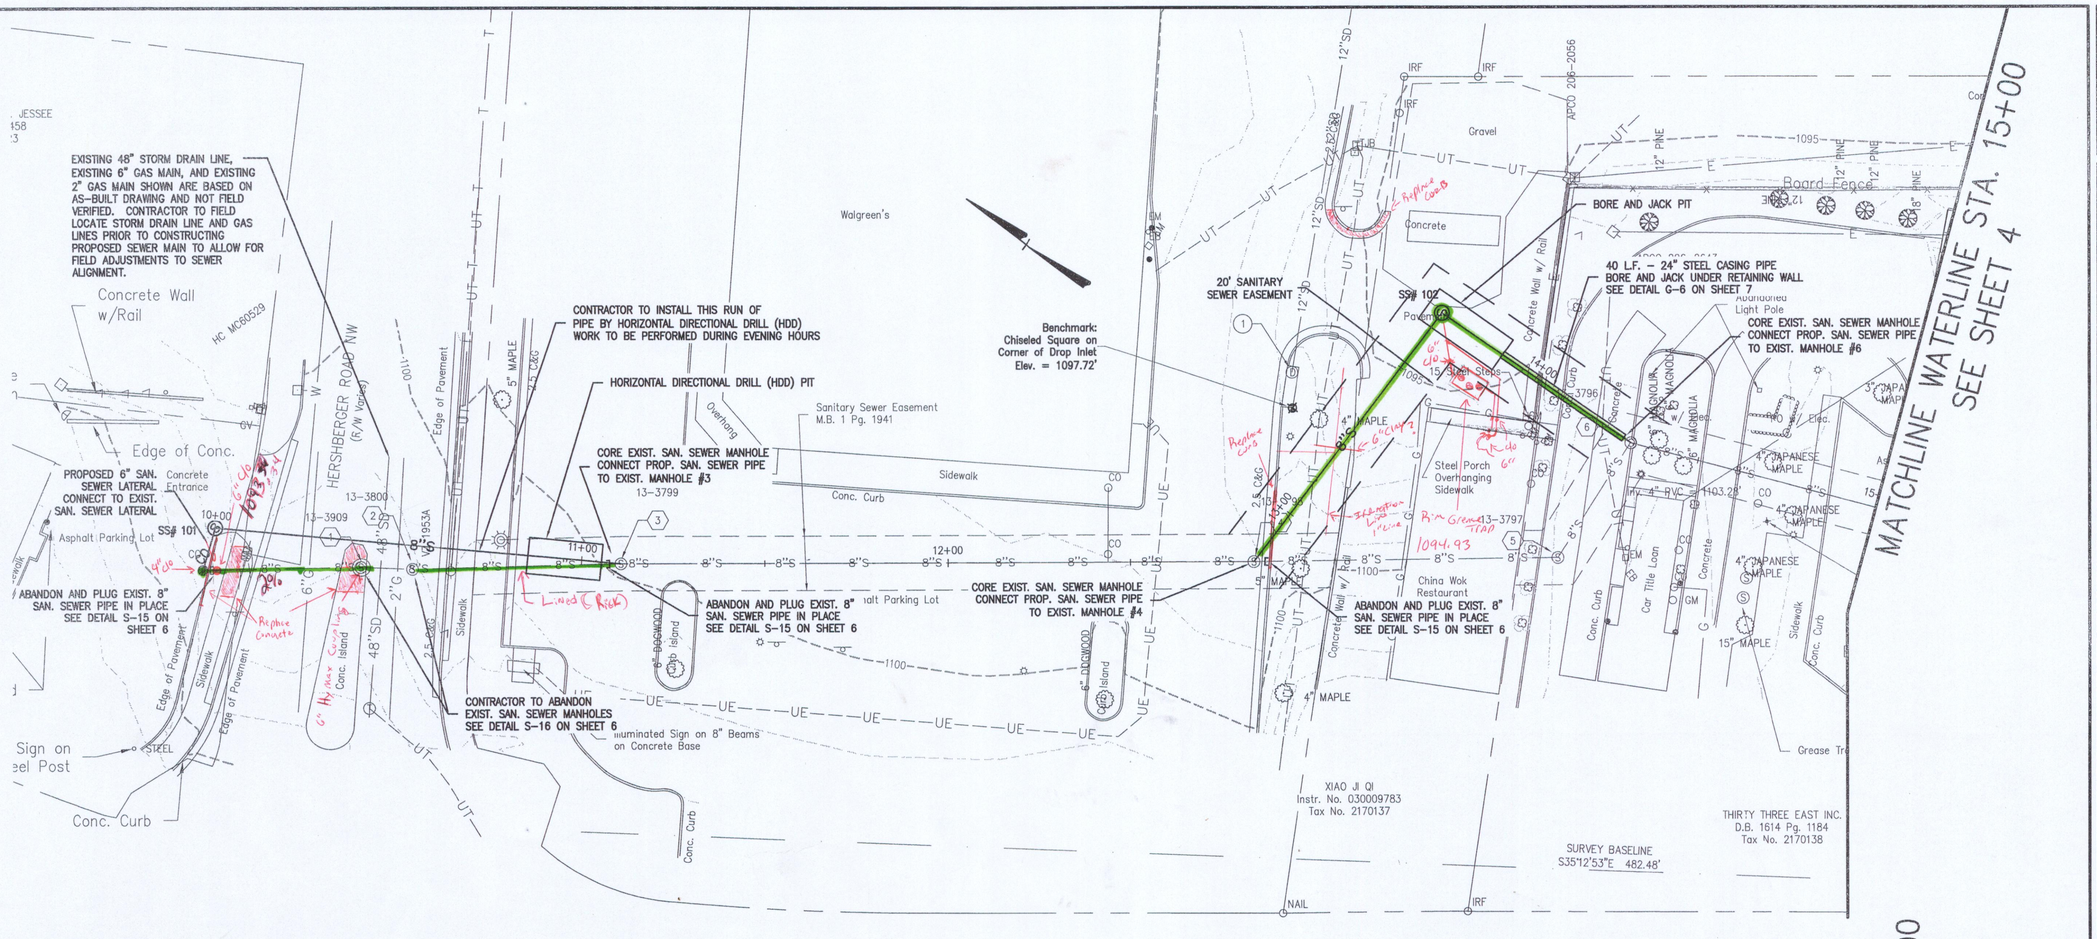

SANITARY SEWER PROFILE

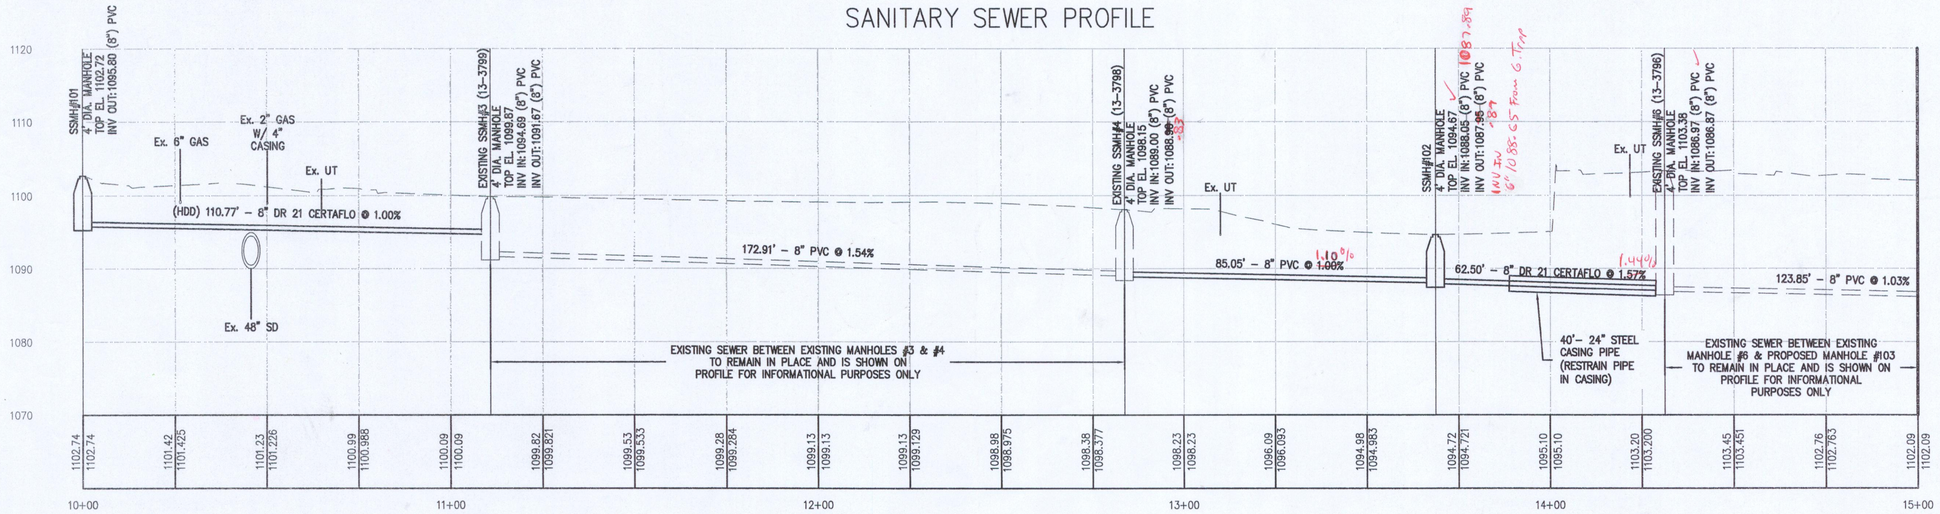

MATCHLINE SANITARY SEWER STA. 15+00 SEE SHEET 4

SCALE: 1" = 20'–0"

COMMONWEALTH OF VIRGINIA — BRADLEY C. CRAIG — Lic. No. 023879 — PROFESSIONAL ENGINEER

Revisions	Date
CHANGES BASED ON CONTRACTOR NEGOTIATIONS	11/8/2013

Issue Date: JUNE 13, 2013
Drawn By: JEF
Designed By: BCC/JEF
Checked By: BCC
Date: 10/31/2012

Mattern & Craig
CONSULTING ENGINEERS • SURVEYORS
701 FIRST STREET, S.W.
ROANOKE, VIRGINIA 24016
(540) 345-9342
FAX (540) 345-7691

WILLIAMSON ROAD SEWER REPLACEMENT – 4800 BLOCK
WESTERN VIRGINIA WATER AUTHORITY

PLAN & PROFILE

CITY OF ROANOKE, VIRGINIA

Vertical Scale: 1" = 10'
Horizontal Scale: 1" = 20'
Commission Number: 3228
Sheet No.: 3