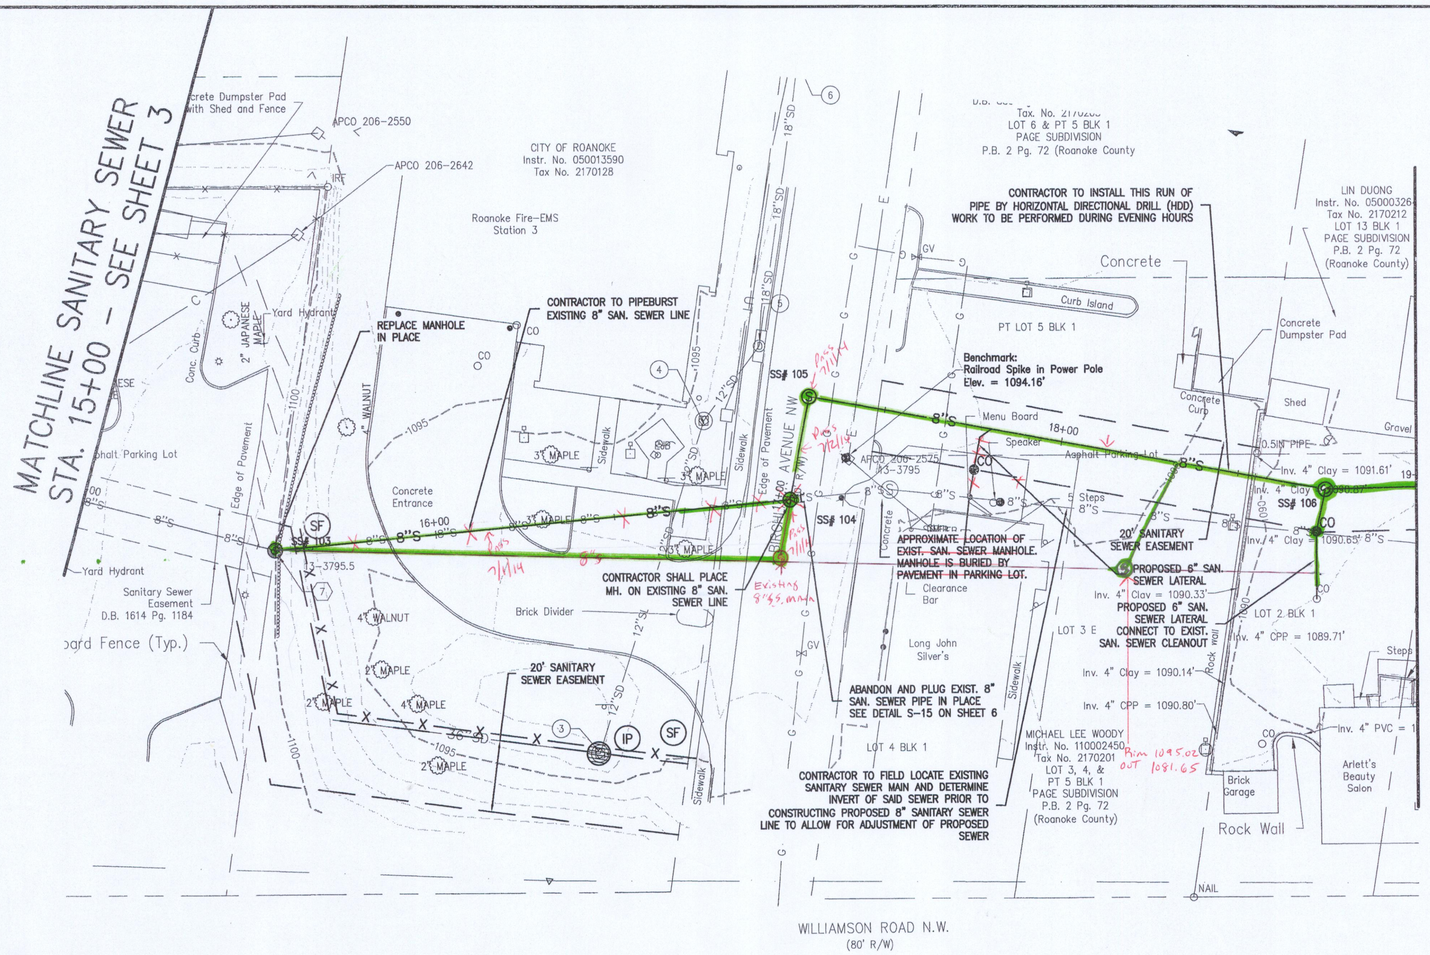

SANITARY SEWER PROFILE

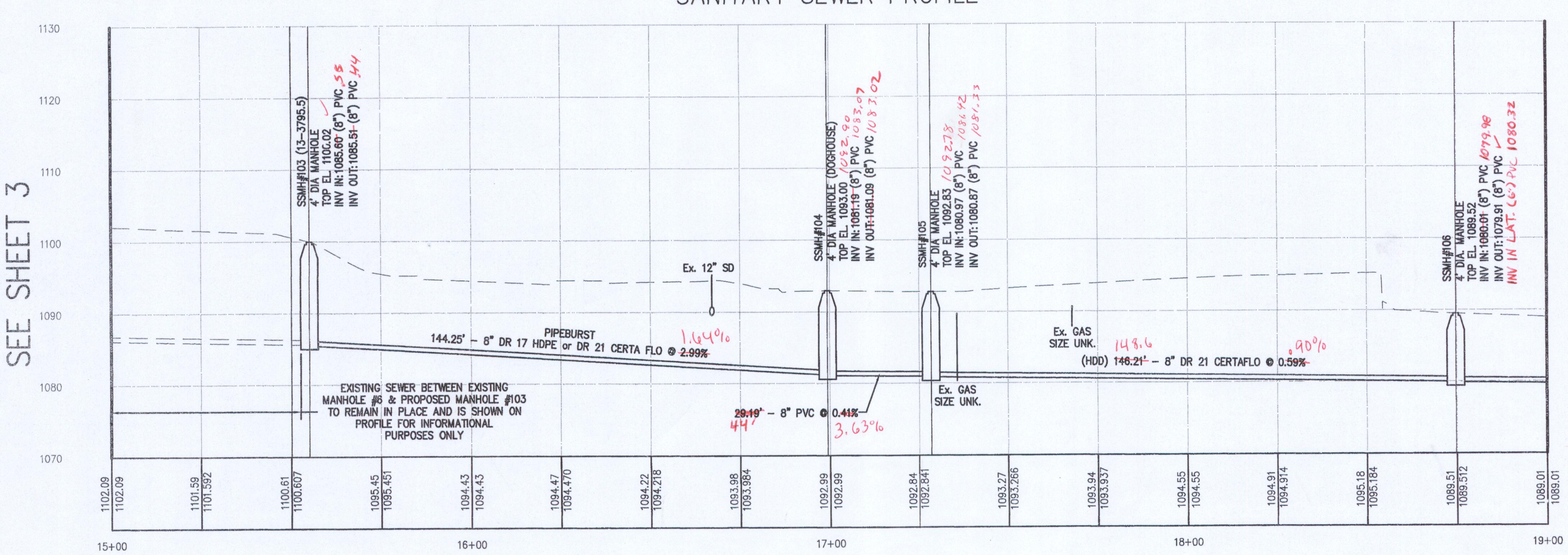

SCALE: 1" = 20'-0"

Revisions	Date
CHANGES BASED ON CONTRACTOR NEGOTIATIONS	11/8/2013

Issue Date: JUNE 13, 2013
Drawn By: JEF
Designed By: BCC/AEF
Checked By: BCC
Date: 10/31/2012

Mattern & Craig
CONSULTING ENGINEERS • SURVEYORS
701 FIRST STREET, S.W.
ROANOKE, VIRGINIA 24016
(540) 345-9343
FAX (540) 345-7691

COMMONWEALTH OF VIRGINIA
BRADLEY C. CRAIG
Lic. No. 023879
LICENSED PROFESSIONAL ENGINEER

WILLIAMSON ROAD SEWER REPLACEMENT – 4800 BLOCK
WESTERN VIRGINIA WATER AUTHORITY

PLAN & PROFILE

CITY OF ROANOKE, VIRGINIA

Vertical Scale: 1" = 10'
Horizontal Scale: 1" = 20'
Commission Number: 3228
Sheet No.: 4