

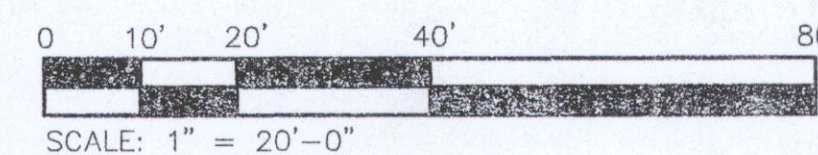
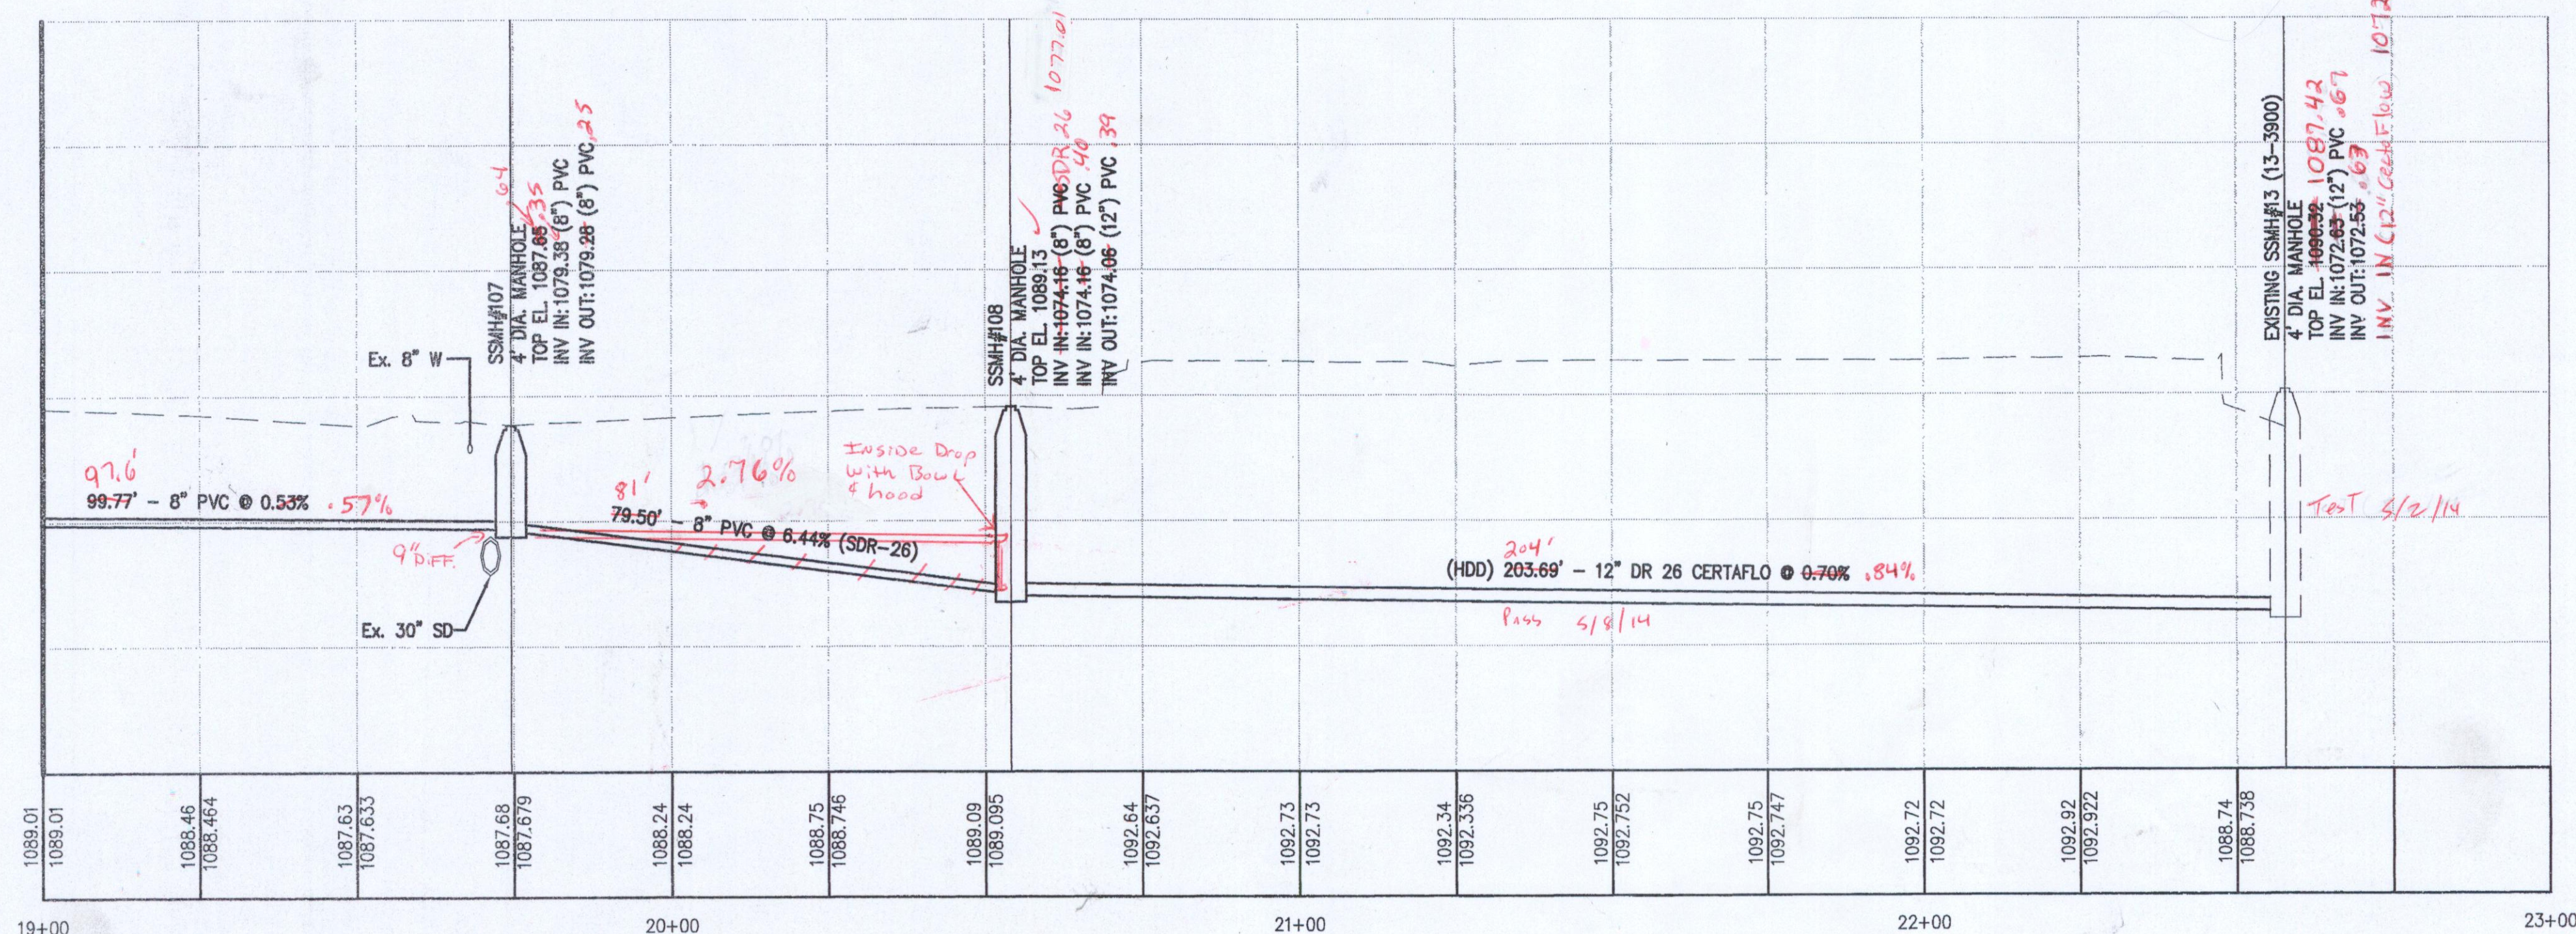


MATCHLINE SANITARY SEWER
STA. 19+00 - SEE SHEET 4

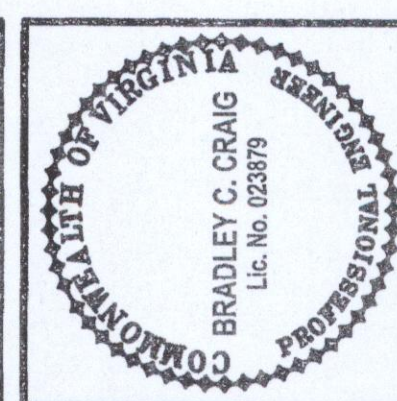

MATCHLINE SANITARY SEWER STA. 19+00
SEE SHEET 4

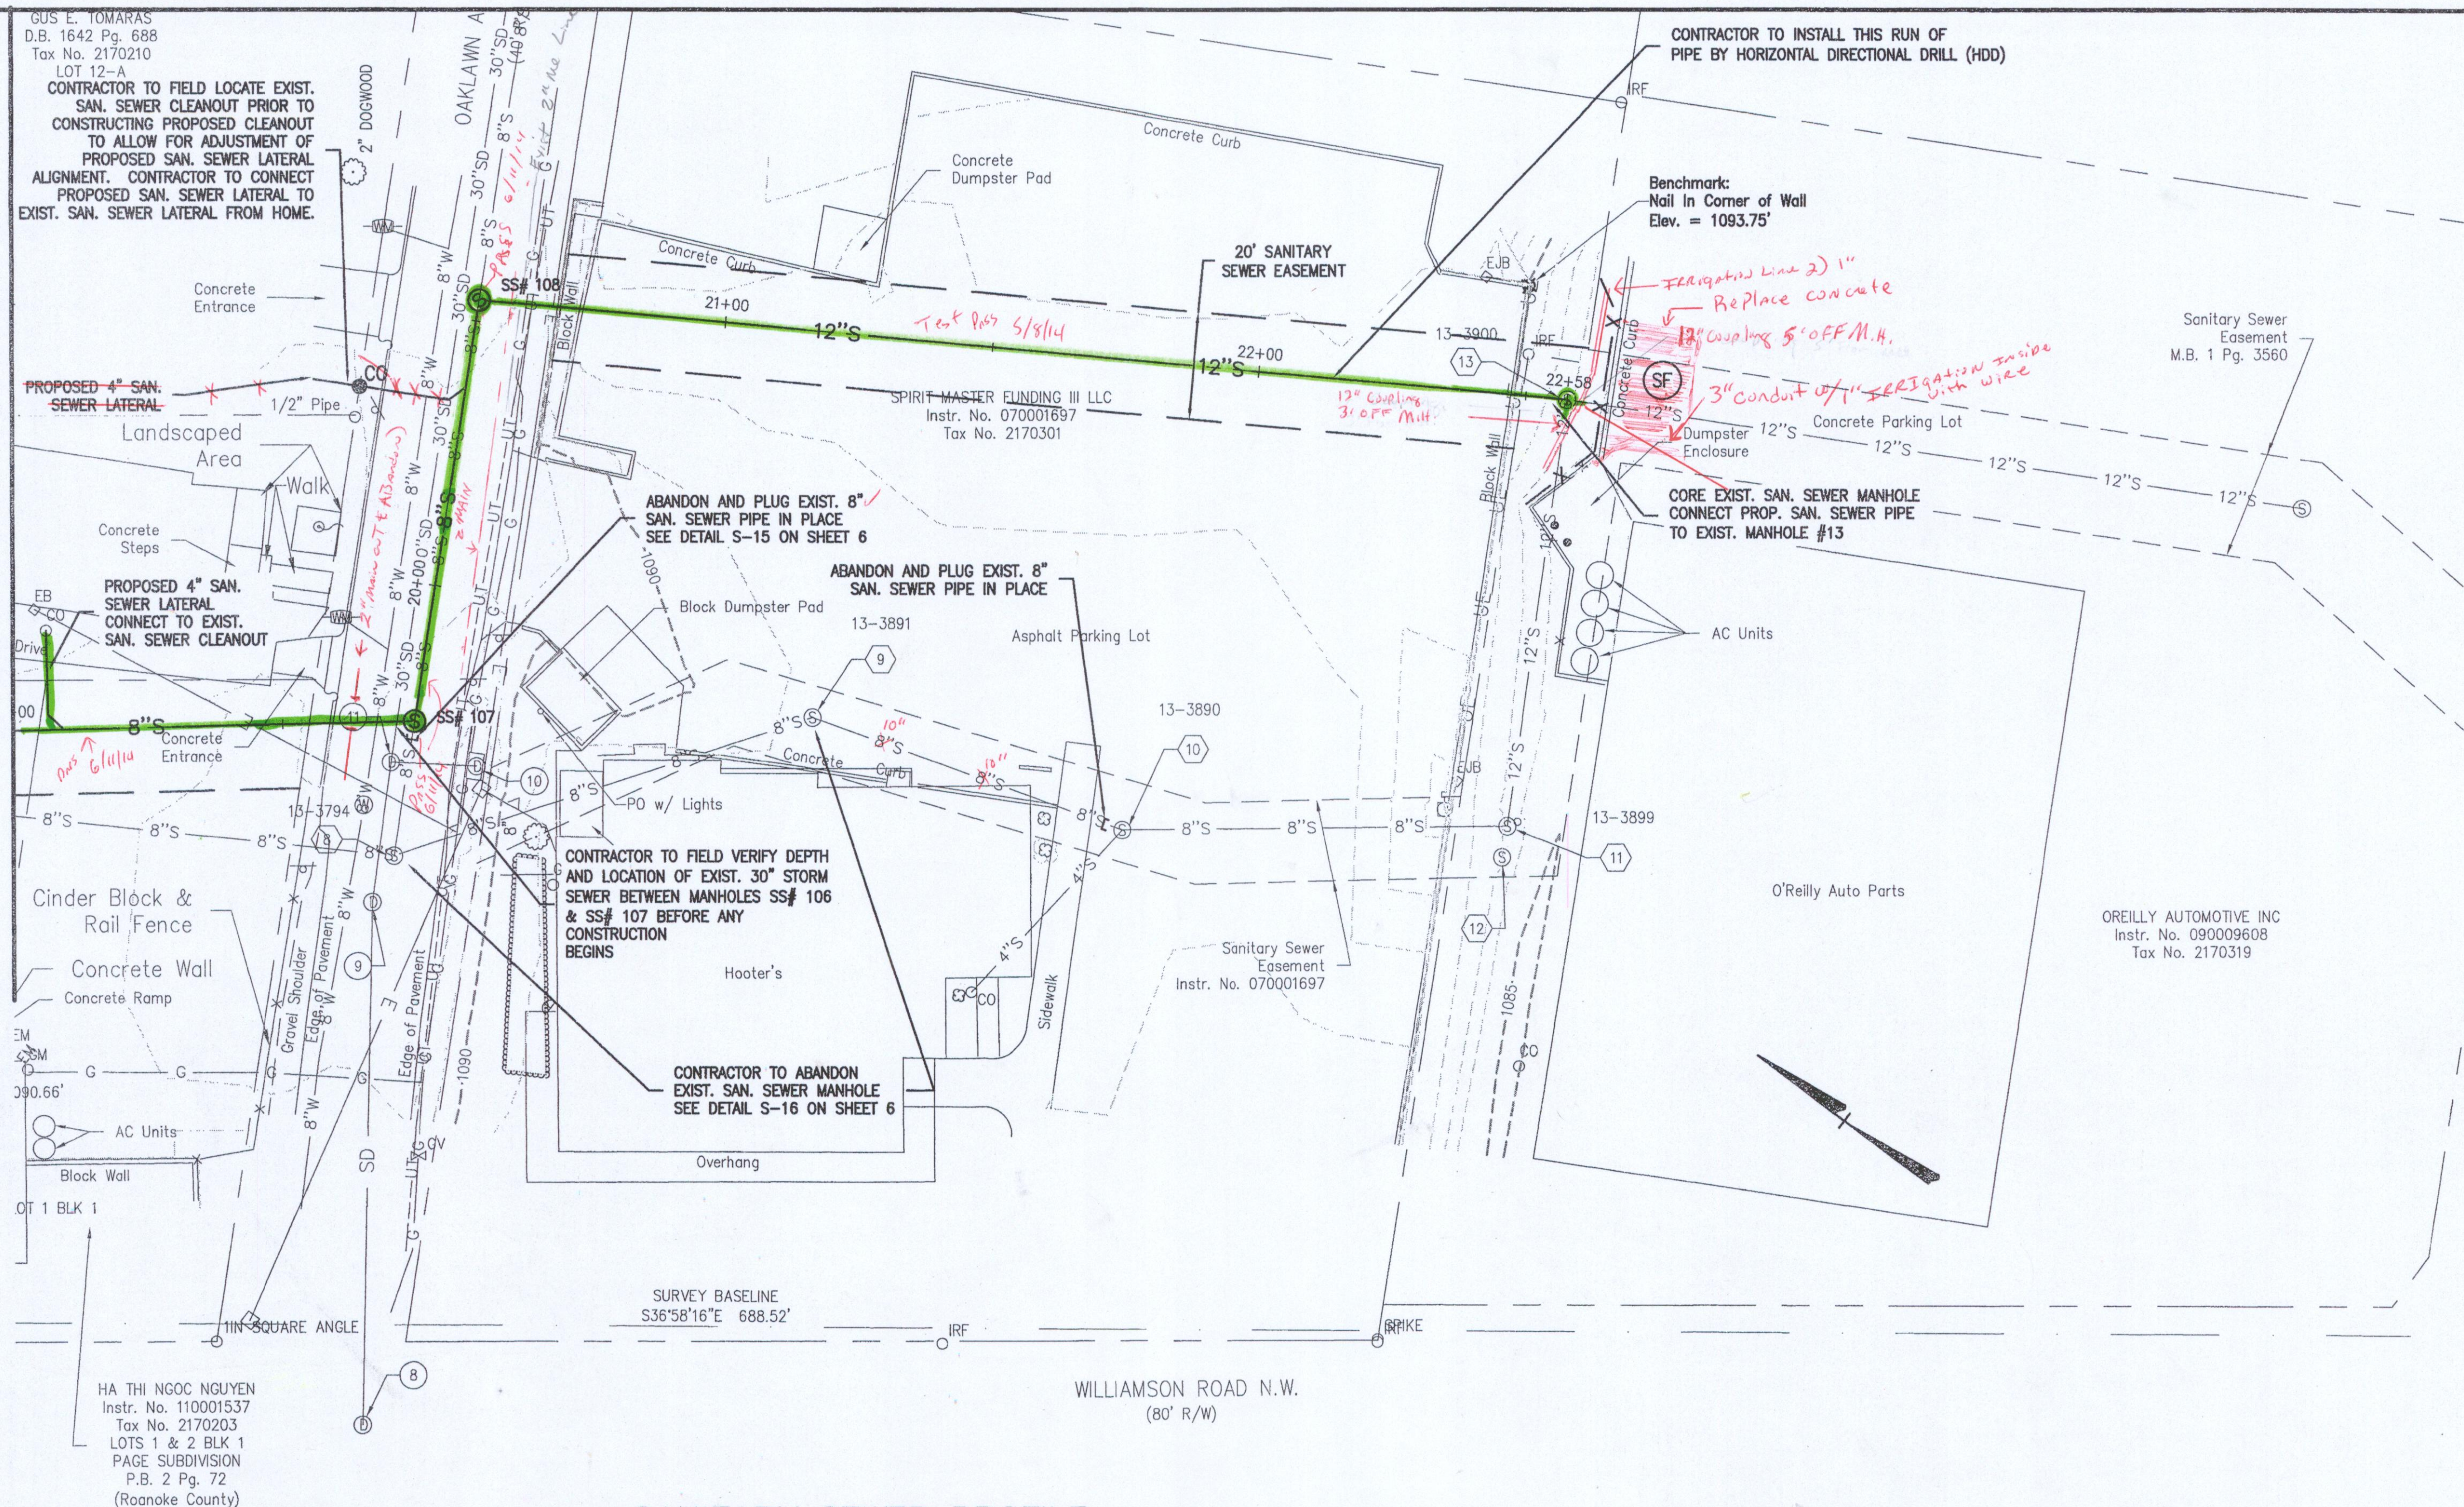

Revisions	Date
CHANGES BASED ON CONTRACTOR NEGOTIATIONS	11/8/2013

Issue Date: JUNE 13, 2013
Drawn By: JEF
Designed By: BCC/JEF
Checked By: BCC
Date: 10/31/2012

Mattern & Craig
CONSULTING ENGINEERS • SURVEYORS
701 FIRST STREET, S.W.
ROANOKE, VIRGINIA 24016
(800) 443-3592
FAX (540) 345-7691

WILLIAMSON ROAD SEWER REPLACEMENT - 4800 BLOCK
WESTERN VIRGINIA WATER AUTHORITY
PLAN & PROFILE
CITY OF ROANOKE, VIRGINIA

Vertical Scale:
1" = 10'
Horizontal Scale:
1" = 20'
Commission Number:
3228
Sheet No.:
5