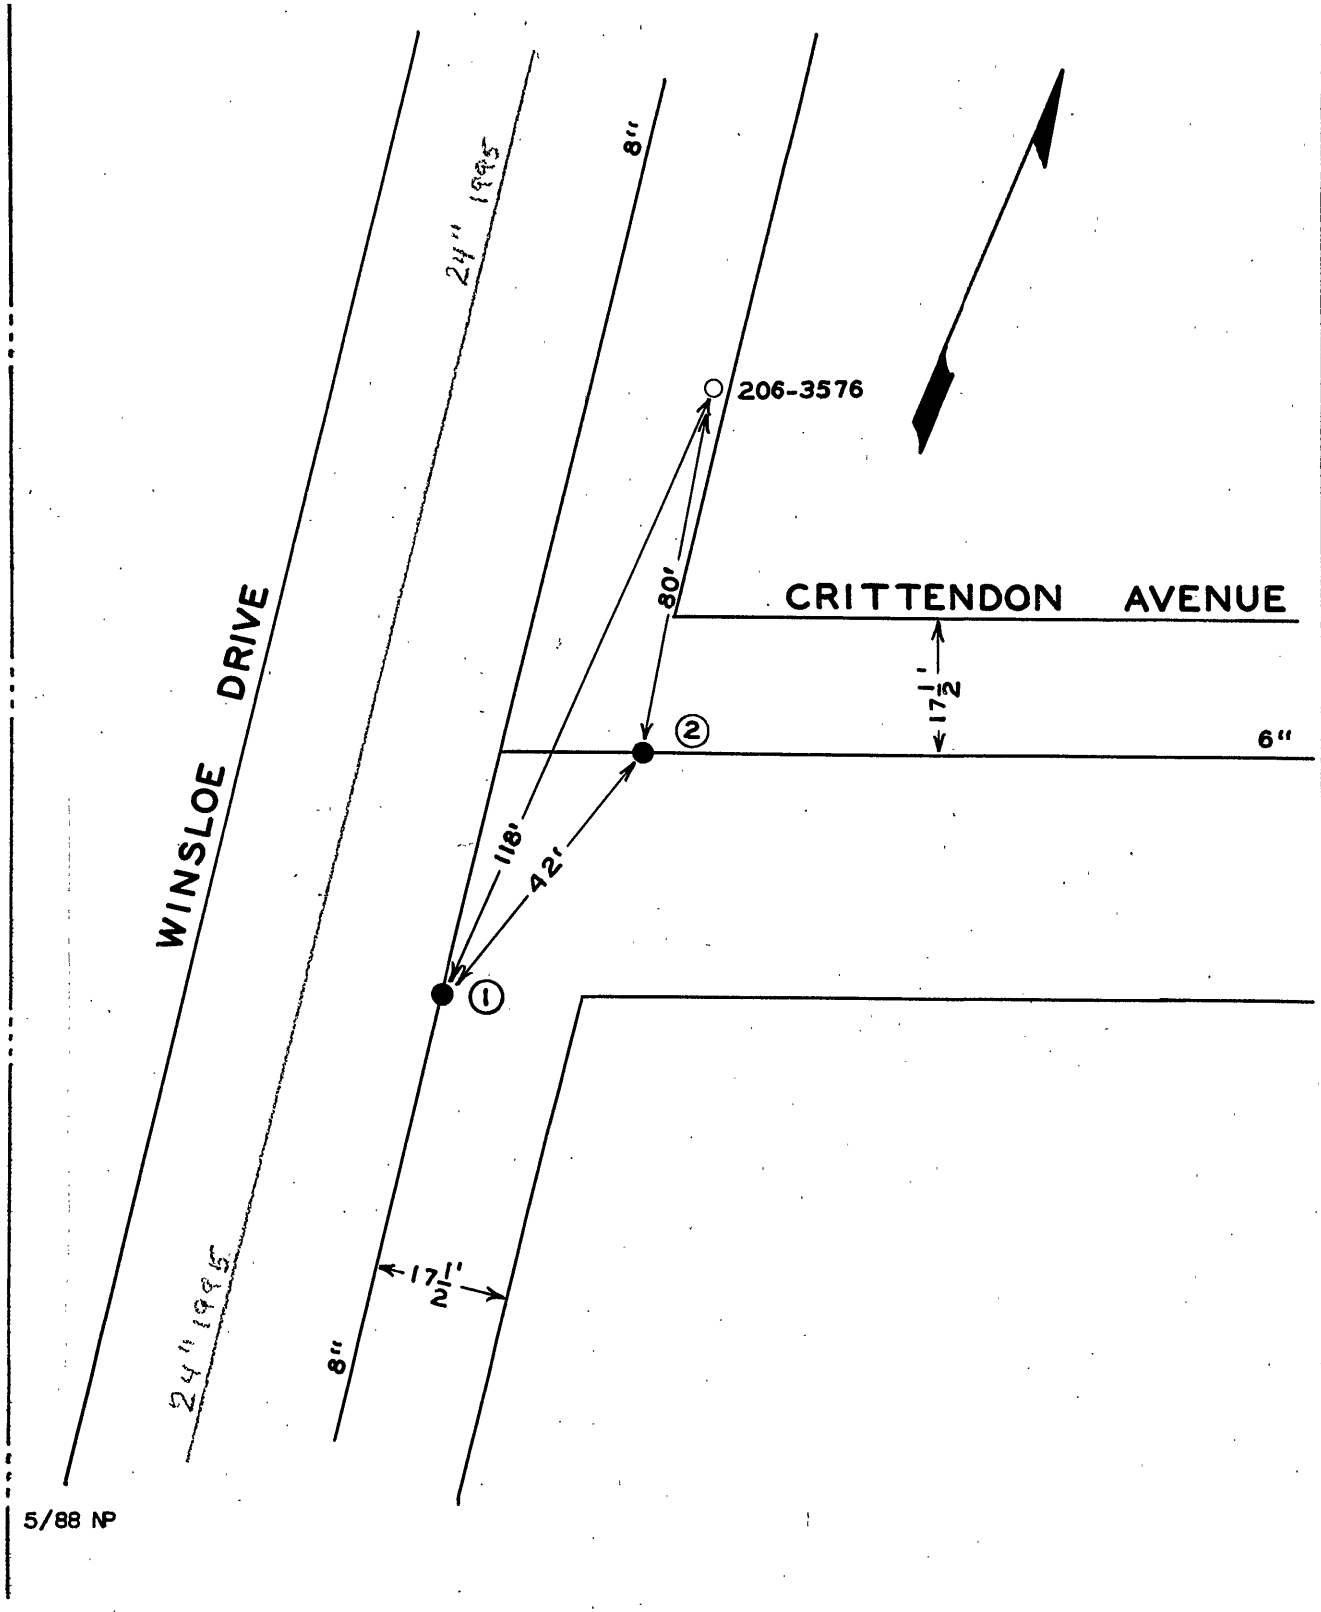

DATE	NO.	SIZE	MAKE	OPEN	TURNS
8-64	1	8"	MUELLER	R	
8-64	2	6"	MUELLER	R	
	1	0	S.P.L.		
	2	0	E.P.L.		

CITY OF ROANOKE—WATER DEPT.

VALVE DIAGRAM

CRITTENDON AVENUE &

WINSLOE DRIVE N.W.

SEC. MAP 210

DATE PAGE NO.

5/88 NP