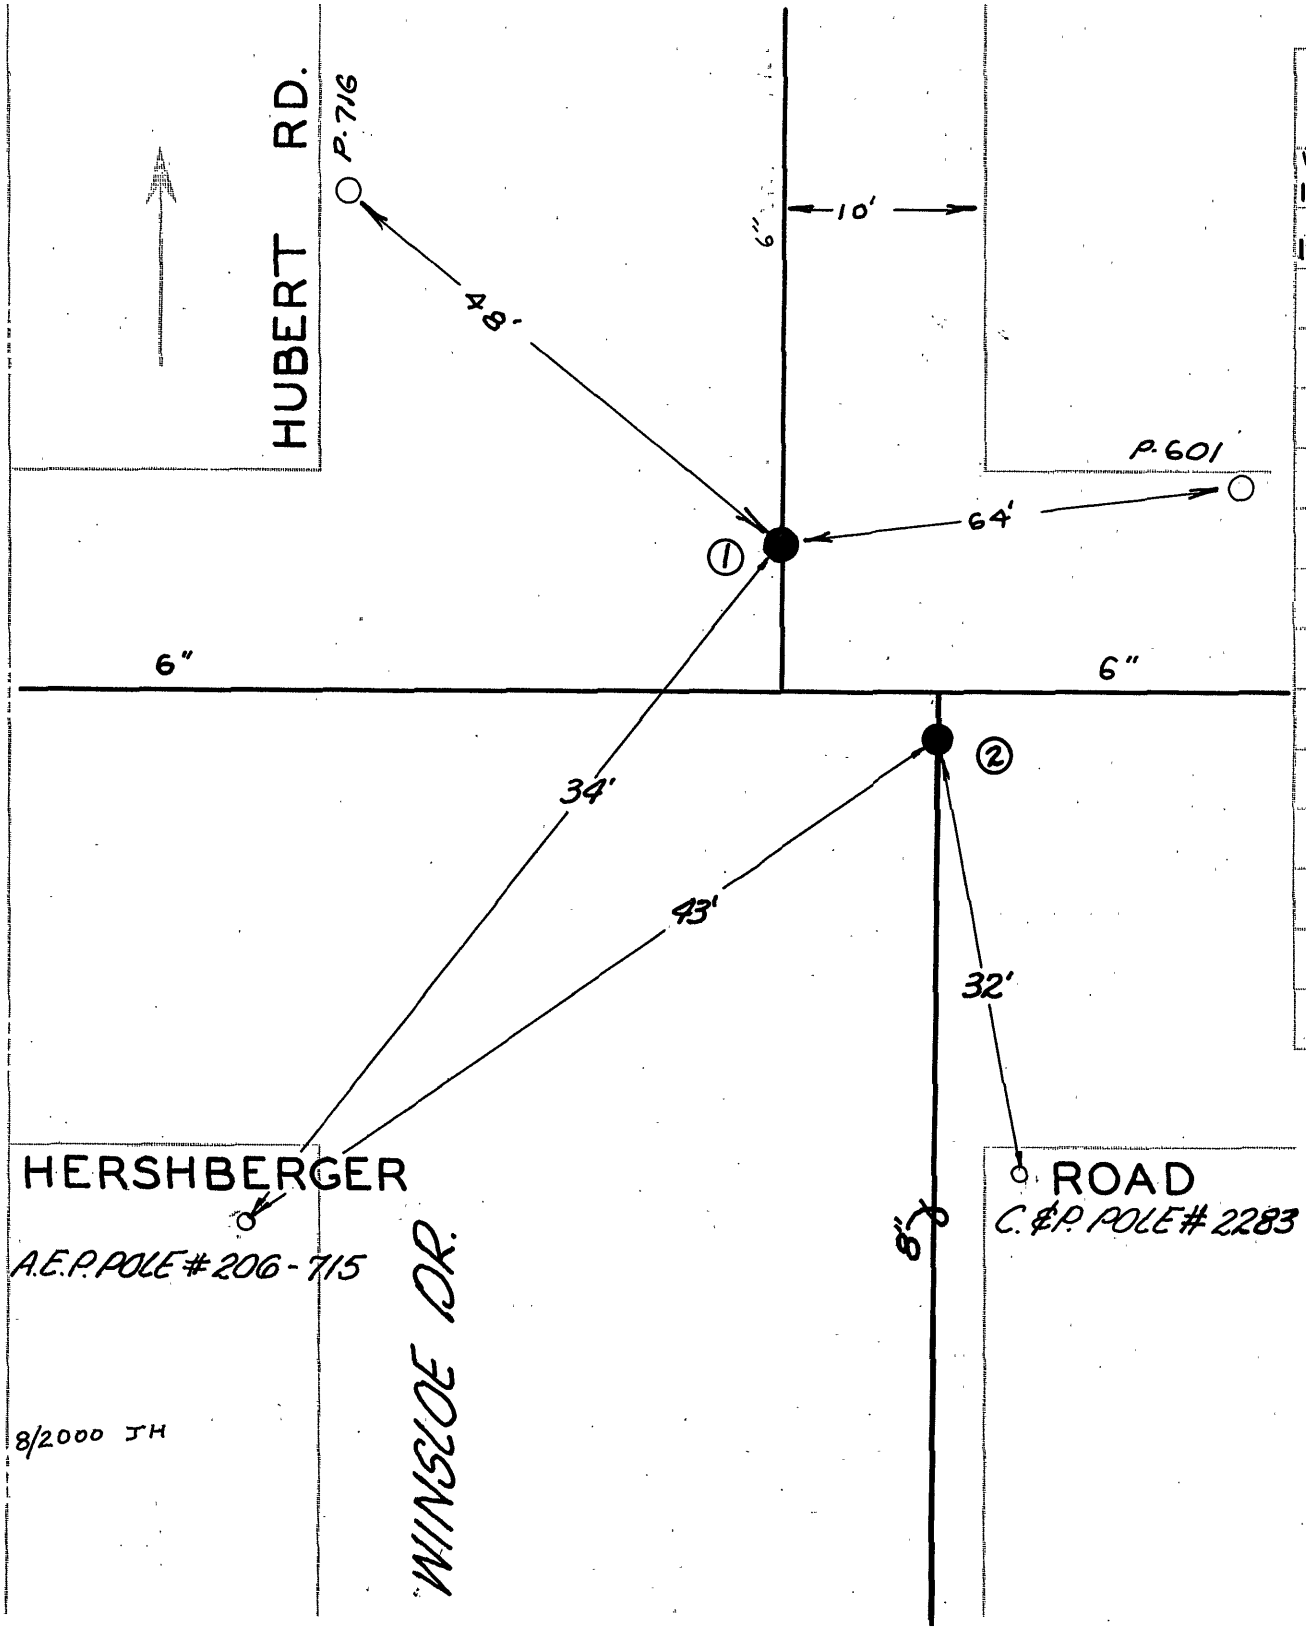

DATE	NO.	SIZE	MAKE	OPEN	TURNS
WR 1951	1	6"		R	21
1975	2	6"	MUELLER	R	21
	1	8'-S	NPL		

CITY OF ROANOKE—WATER DEP'T

VALVE DIAGRAM

HERSHBERGER RD. &

HUBERT RD.

WINSLOE DRIVE N.W.

SEC. MAP 220

DATE PAGE NO.