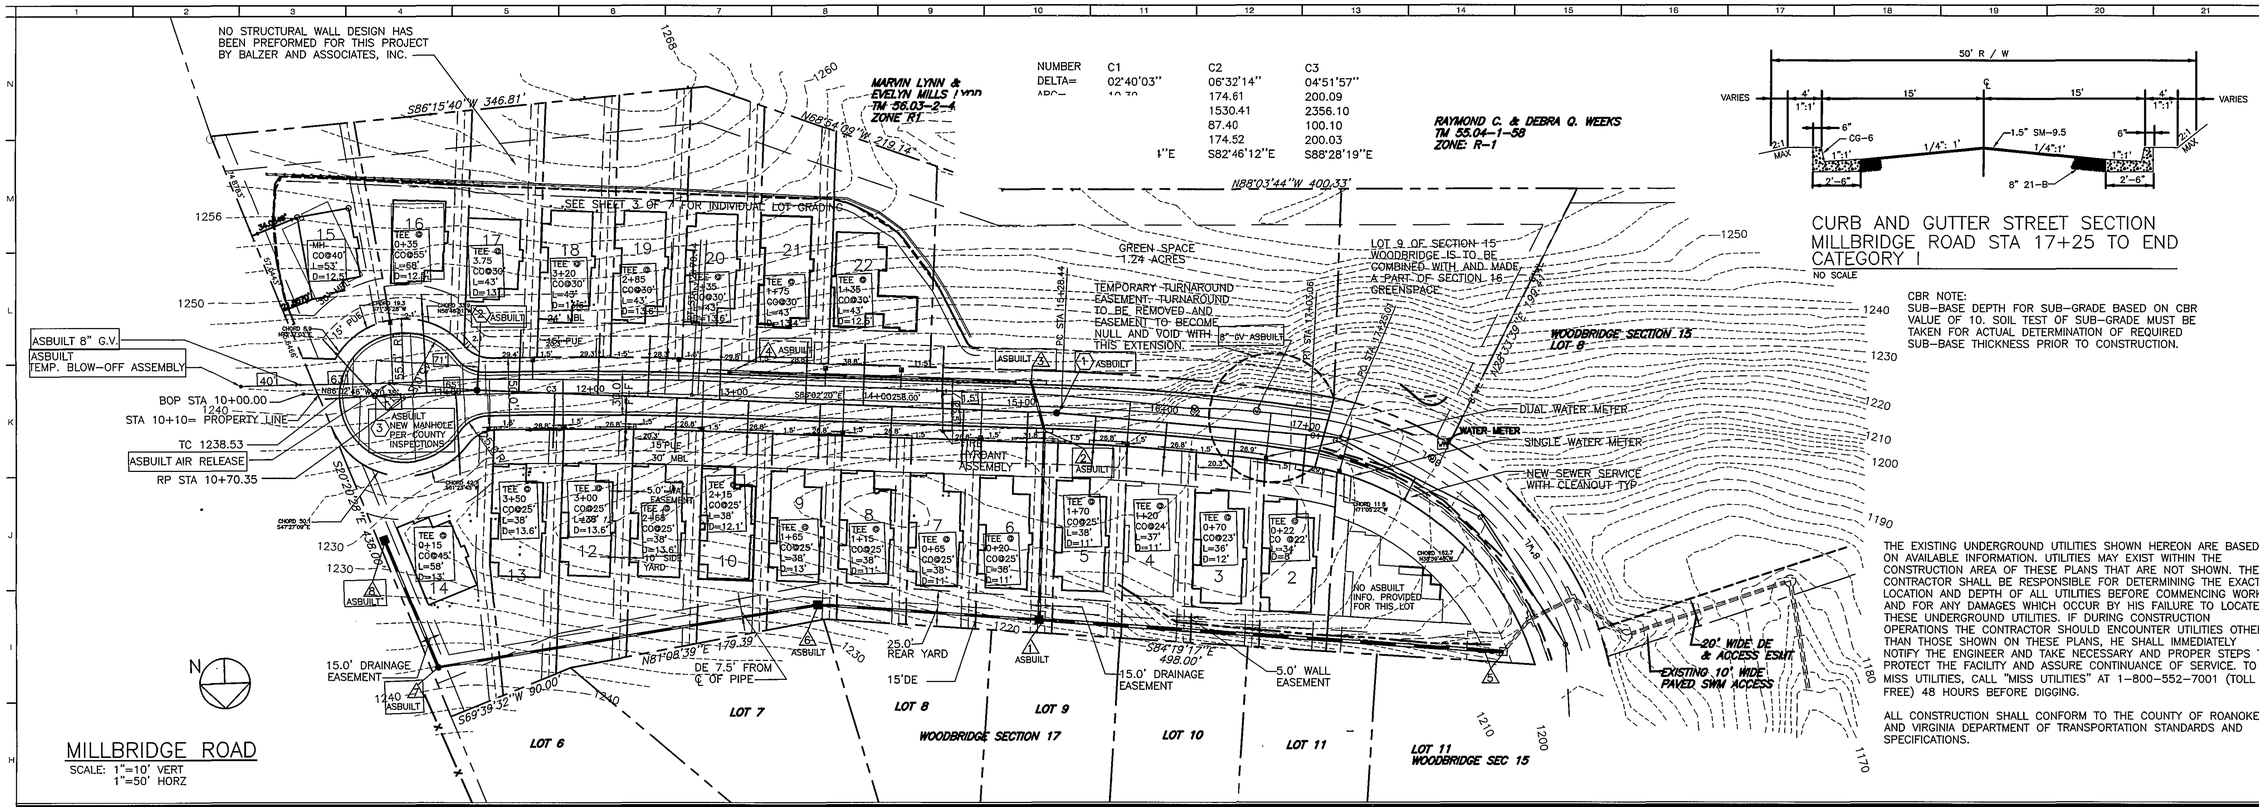

NUMBER	C1	C2	C3
DELTA=	02°40'03"	06°32'14"	04°51'57"
ARC=	[illegible]	174.61	200.09
		1530.41	2356.10
		87.40	100.10
		174.52	200.03
	1"E	S82°46'12"E	S88°28'19"E

CURB AND GUTTER STREET SECTION MILLBRIDGE ROAD STA 17+25 TO END CATEGORY I

NO SCALE

CBR NOTE:
SUB-BASE DEPTH FOR SUB-GRADE BASED ON CBR VALUE OF 10. SOIL TEST OF SUB-GRADE MUST BE TAKEN FOR ACTUAL DETERMINATION OF REQUIRED SUB-BASE THICKNESS PRIOR TO CONSTRUCTION.

THE EXISTING UNDERGROUND UTILITIES SHOWN HEREON ARE BASED ON AVAILABLE INFORMATION. UTILITIES MAY EXIST WITHIN THE CONSTRUCTION AREA OF THESE PLANS THAT ARE NOT SHOWN. THE CONTRACTOR SHALL BE RESPONSIBLE FOR DETERMINING THE EXACT LOCATION AND DEPTH OF ALL UTILITIES BEFORE COMMENCING WORK, AND FOR ANY DAMAGES WHICH OCCUR BY HIS FAILURE TO LOCATE THESE UNDERGROUND UTILITIES. IF DURING CONSTRUCTION OPERATIONS THE CONTRACTOR SHOULD ENCOUNTER UTILITIES OTHER THAN THOSE SHOWN ON THESE PLANS, HE SHALL IMMEDIATELY NOTIFY THE ENGINEER AND TAKE NECESSARY AND PROPER STEPS TO PROTECT THE FACILITY AND ASSURE CONTINUANCE OF SERVICE. TO MISS UTILITIES, CALL "MISS UTILITIES" AT 1-800-552-7001 (TOLL FREE) 48 HOURS BEFORE DIGGING.

ALL CONSTRUCTION SHALL CONFORM TO THE COUNTY OF ROANOKE AND VIRGINIA DEPARTMENT OF TRANSPORTATION STANDARDS AND SPECIFICATIONS.

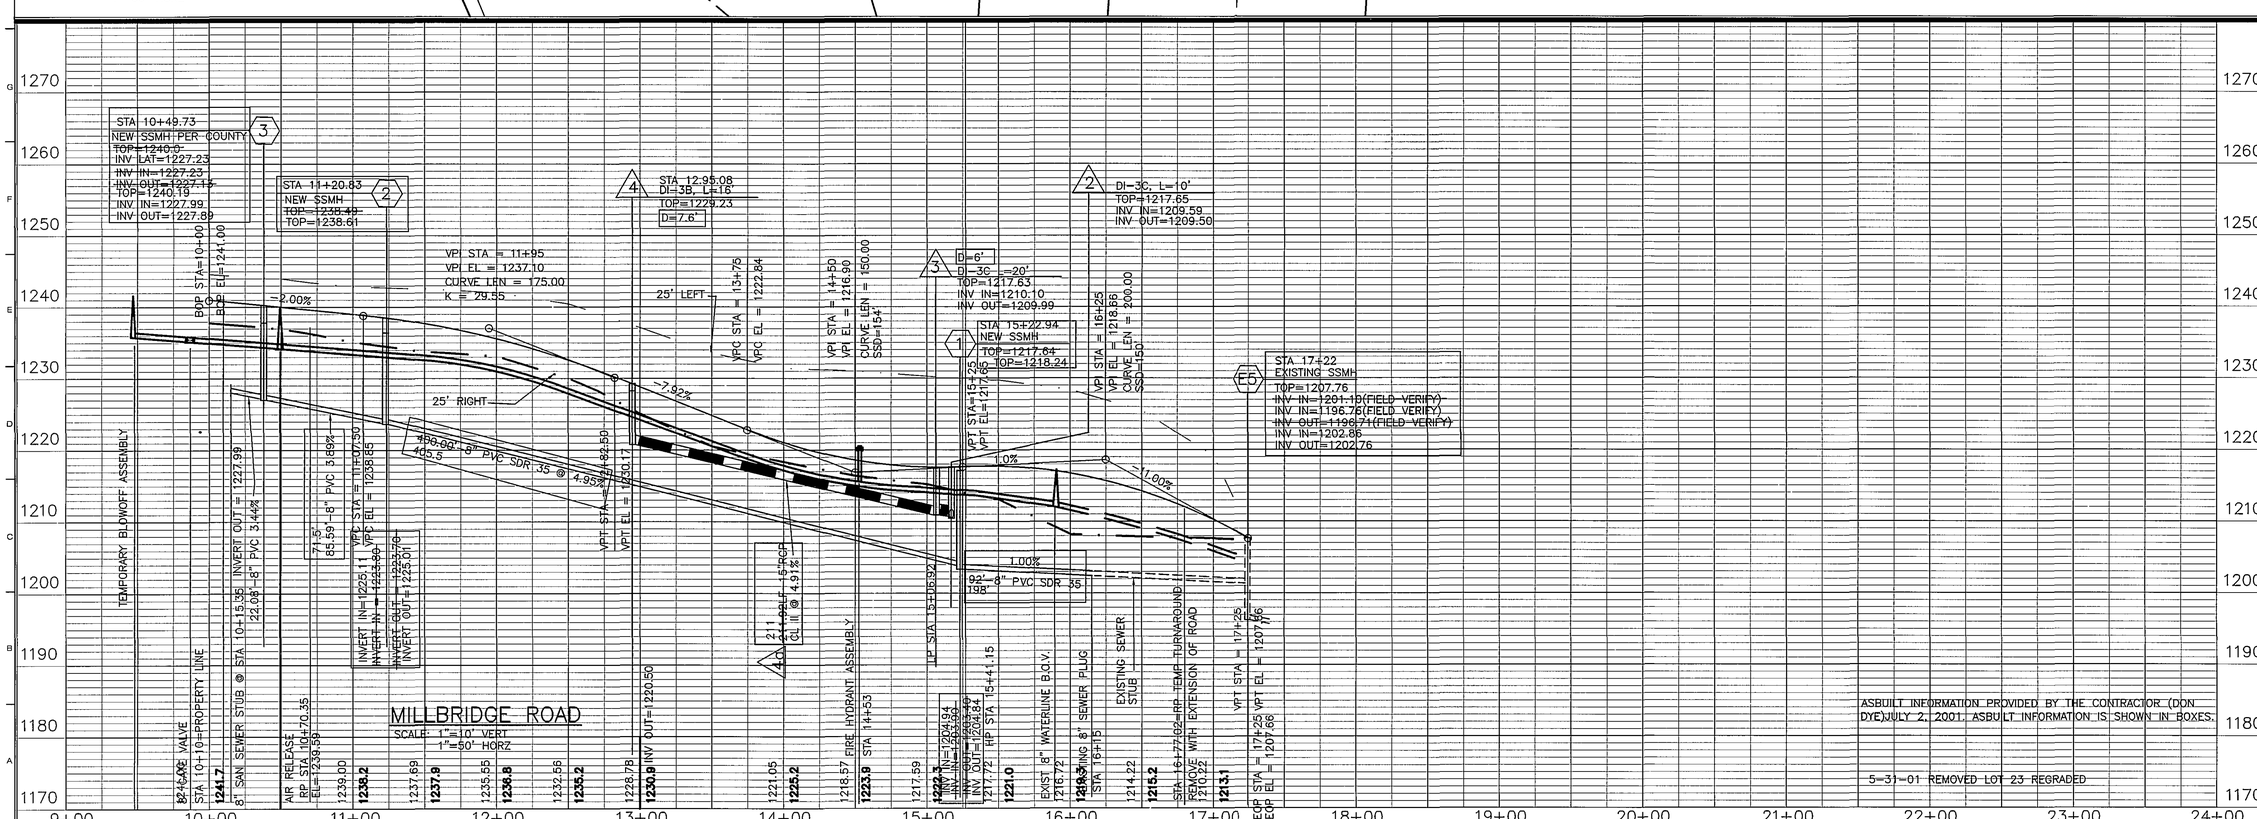

ASBUILT INFORMATION PROVIDED BY THE CONTRACTOR (DON DYE)JULY 2, 2001. ASBUILT INFORMATION IS SHOWN IN BOXES.

5-31-01 REMOVED LOT 23 REGRADED

COMMONWEALTH OF VIRGINIA
ROGER I. STURGILL
No. 033058
PROFESSIONAL ENGINEER

BALZER AND ASSOCIATES INC.
REFLECTING TOMORROW
• PLANNERS • ARCHITECTS
• ENGINEERS • SURVEYORS

1208 Corporate Circle
Roanoke, Virginia 24018
Phone: 540/772-9580
FAX: 540/772-8050

501 Branchway Road
Suite 100
Richmond, Virginia 23236
Phone: 804/794-0571
FAX: 804/794-2635

880 Technology Park Drive
Suite 200
Glen Allen, Virginia 23059
Phone: 804/553-0132
FAX: 804/553-0133

WOODBRIDGE VILLAGE
SECTION 1a

ASBUILT PLAN AND PROFILE

ROANOKE COUNTY, VIRGINIA

DRAWN BY: DRB
DESIGNED BY: DRB
CHECKED BY: RIS
DATE: SEPT. 15, 2000
REVISIONS:

(6) 9-15-00
(7) 12-12-00
(8) 5-10-01
(10) 5-31-01
(11) 7-3-01
(12) 11-8-04
REVISED ASBUILTS
SCALE: AS SHOWN

SHEET NO.
4 OF 6

JOB NO.
95065