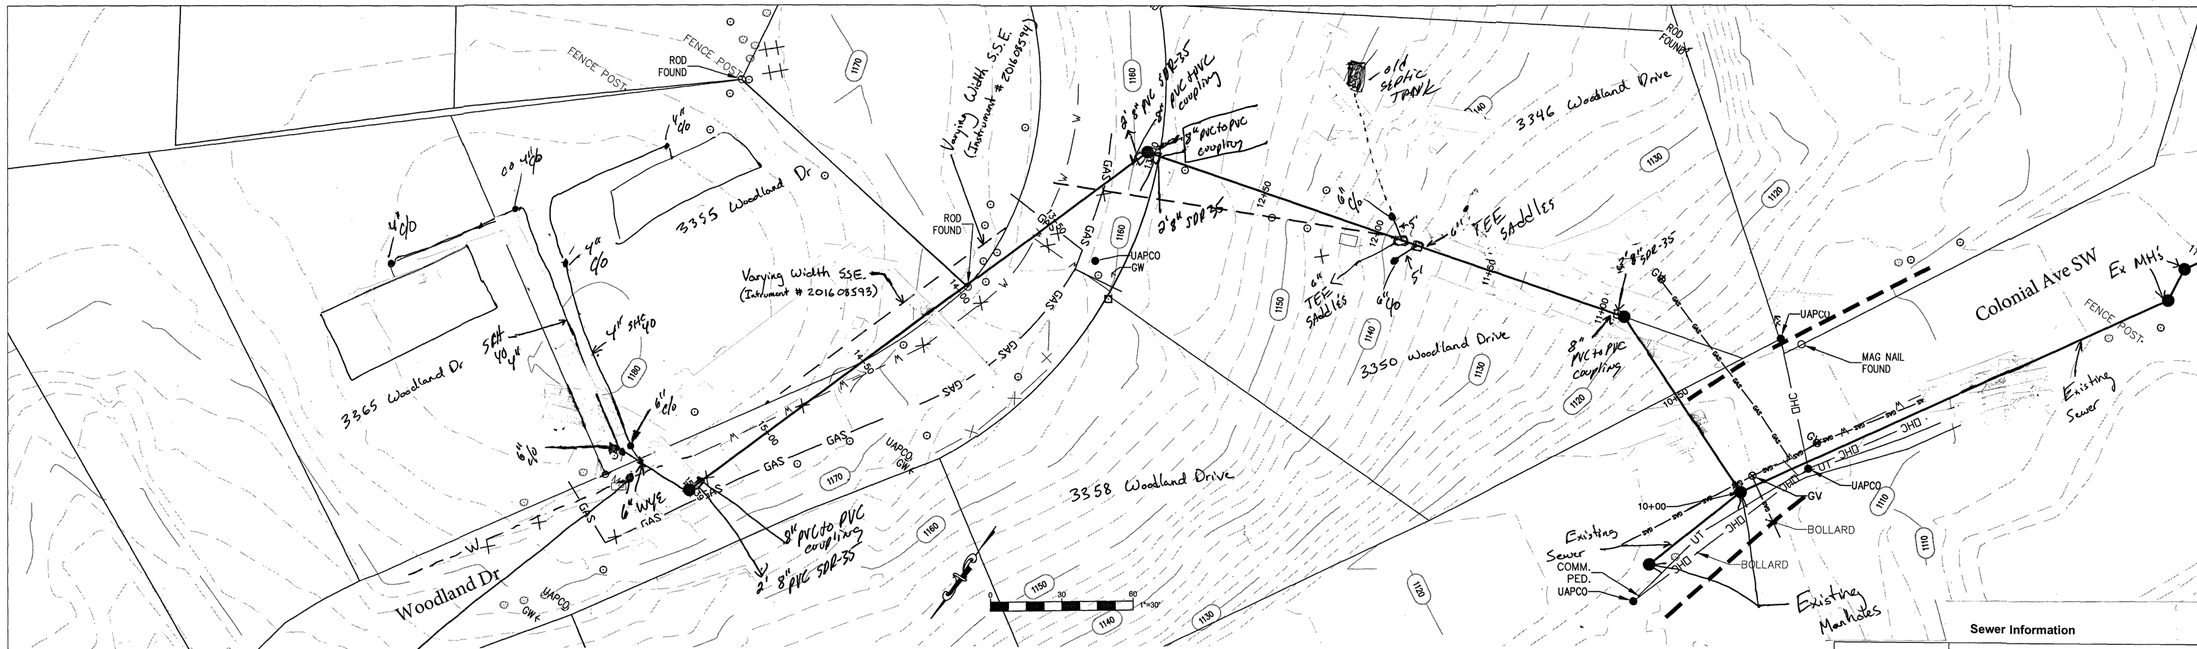

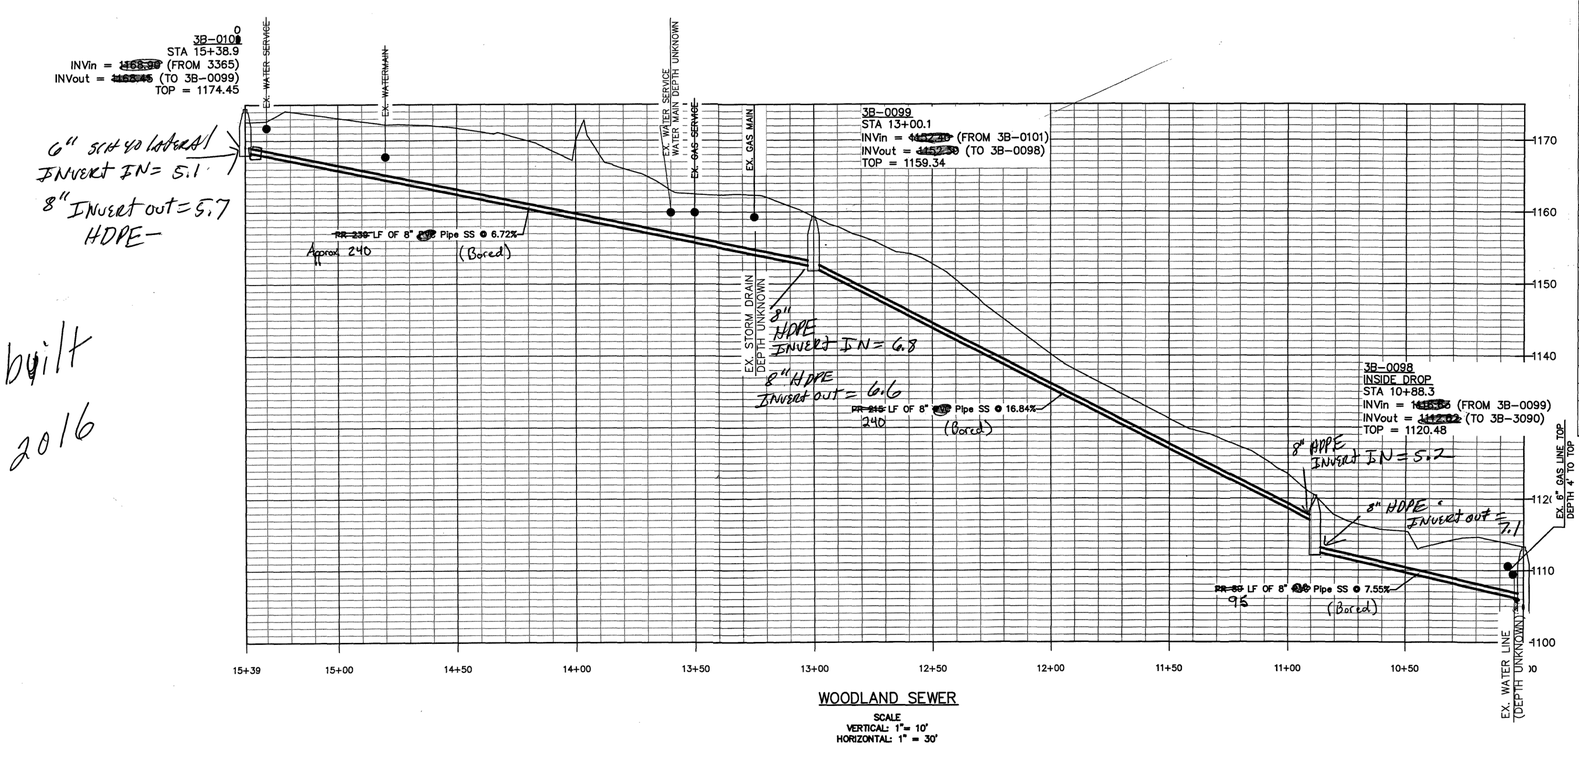

WOODLAND SEWER

SCALE
VERTICAL: 1" = 10'
HORIZONTAL: 1" = 30'

As-built
Sept. 2016

3B-3090
STA 10+00.0
INVin = 1104.67 (FROM 3B-3091)
INVin = 1105.06 (FROM 3B-0098)
INVout = 1104.57 (TO 3B-3089)
TOP = 1113.32

Sewer Information

Project Name	WOODLAND SEWER
Contractor	CM3 / GRINDSTAFF
Install Date	10/13/2016
Sewer Gravity Main(s)	
Manufacturer	
Diameter	8"
Pipe Class	DR-17
Material	HDPE
Comments	GRINDSTAFF / BORED, REAMED,& PULLED 3 SECTIONS OF 8" FUSION
Sewer Force Main(s)	
Manufacturer	
Diameter	
Pipe Class	
Material	
Comments	
Sewer Gravity Lateral(s)	
Manufacturer	NORTH AMERICAN PIPE
Diameter	6"
Pipe Class	SCH 40
Material	PVC
Comments	ALL 6" LATERALS INSTALLED BY CM3 3346 , 3350 , 3355 ,3365
Sewer Manhole(s)	
Manufacturer	CSI
Material	PRE- FAB
Ring & Cover Manuf.	WVWA SPEC.
Cover Type	
Comments	MH. 3B-0101.0 3B-0099.0 3B-0098.0 INSTALLED BY CM3

WESTERN VIRGINIA WATER AUTHORITY
ENGINEERING SERVICES
601 S JEFFERSON ST, SUITE 300
ROANOKE, VA 24011
540-853-5641 or 540-853-5770

COMMONWEALTH OF VIRGINIA
DAVID M. VOGELSONG
Lic. No. 023274
PROFESSIONAL ENGINEER

WOODLAND SEWER

PLAN & PROFILE

Rev	Description	Date	By

Designed: AAS
Drawn: AAS
Checked: DMV
Approved:
Date: 7/29/16
Project:

1
Sheet 1 of 1