PLAN

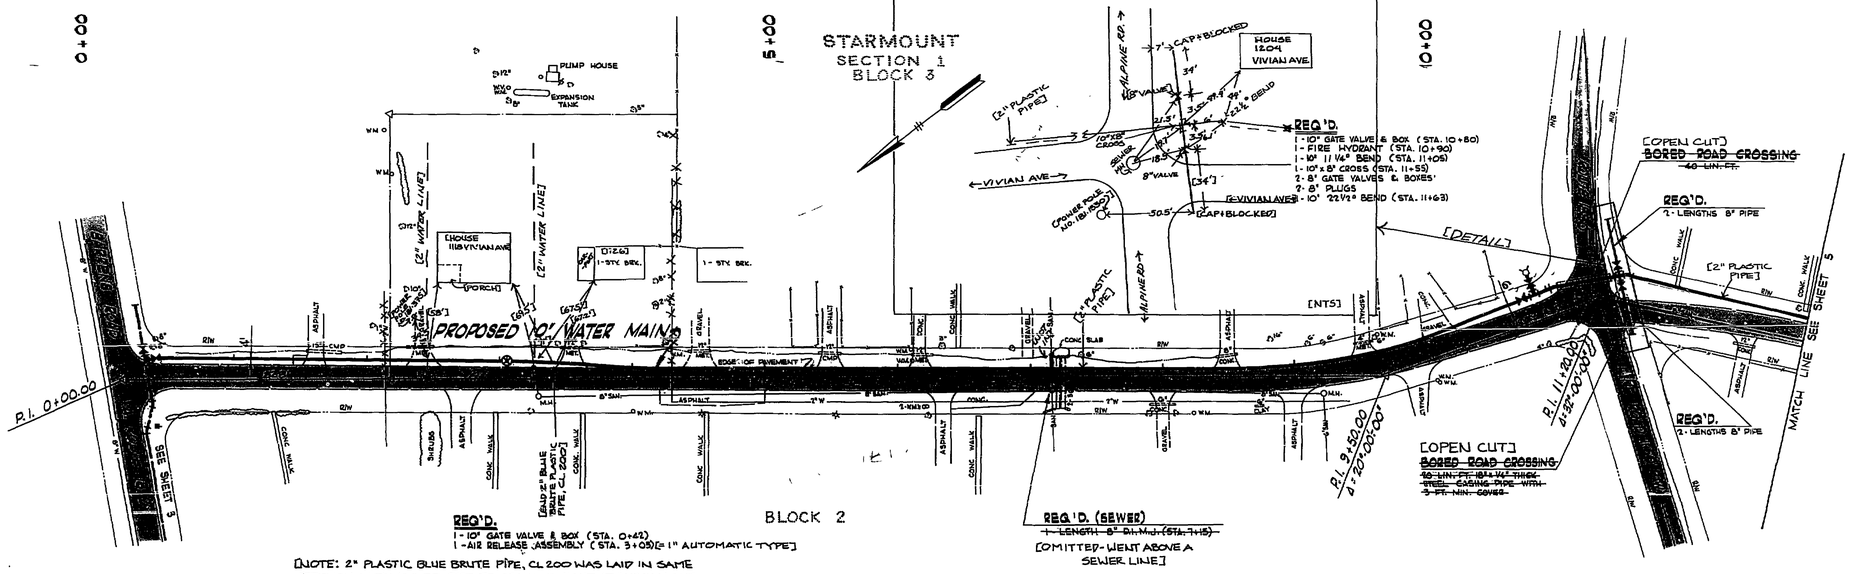

[NOTE: 2" PLASTIC BLUE BRUTE PIPE, CL 200 WAS LAID IN SAME TRENCH WITH 10" D.I. PIPE FROM INT. DWIGHT ST. & VIVIAN AVE. TO STA. 3+25±, VIVIAN AVE. THE PLASTIC LINE WAS ADDED TO CONTRACT BY PJA ENGINEERING FOR THE PURPOSE OF INTERCONNECTING TWO EXISTING STARMOUNT WELLS.]

SCALE : 1 IN. = 50 FT.

PROFILE

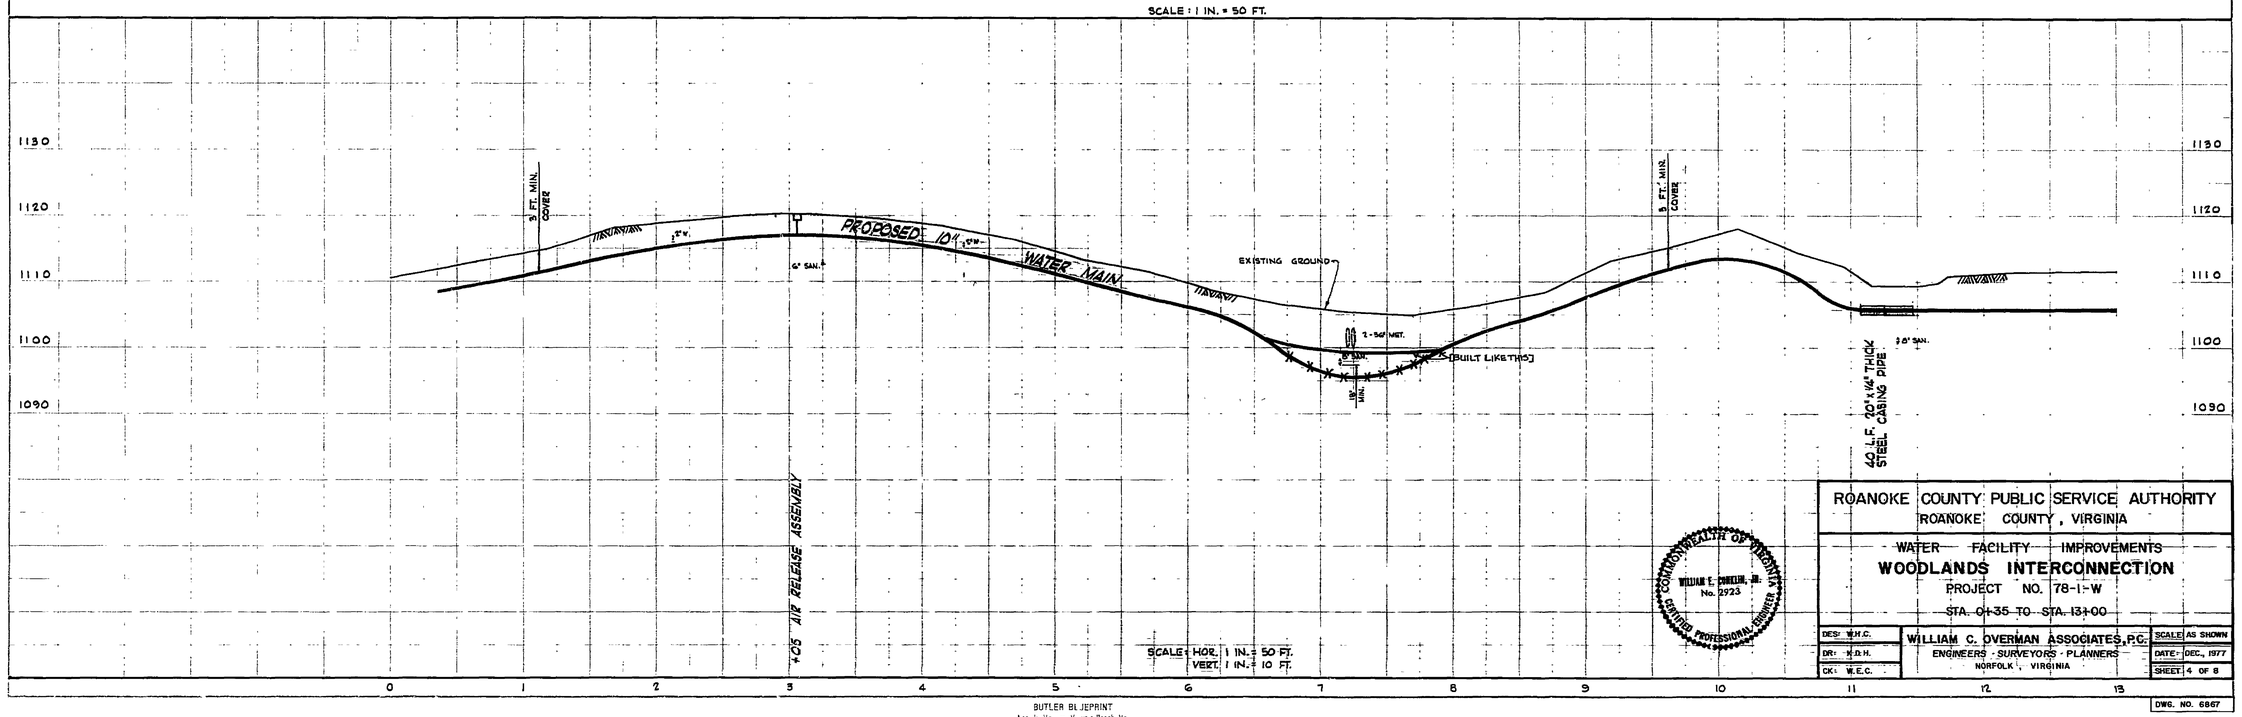

COMMONWEALTH OF VIRGINIA
WILLIAM E. CONKLIN, JR.
No. 2923
CERTIFIED PROFESSIONAL ENGINEER

ROANOKE COUNTY PUBLIC SERVICE AUTHORITY
ROANOKE COUNTY, VIRGINIA

WATER FACILITY IMPROVEMENTS
WOODLANDS INTERCONNECTION
PROJECT NO. 78-1-W
STA. 0+35 TO STA. 13+00

DES: W.H.C.	WILLIAM C. OVERMAN ASSOCIATES, P.C.	SCALE: AS SHOWN
DR: W.D.H.	ENGINEERS · SURVEYORS · PLANNERS	DATE: DEC., 1977
CK: W.E.C.	NORFOLK, VIRGINIA	SHEET 4 OF 8

DWG. NO. 6867

BUTLER BLUEPRINT

WT-0226