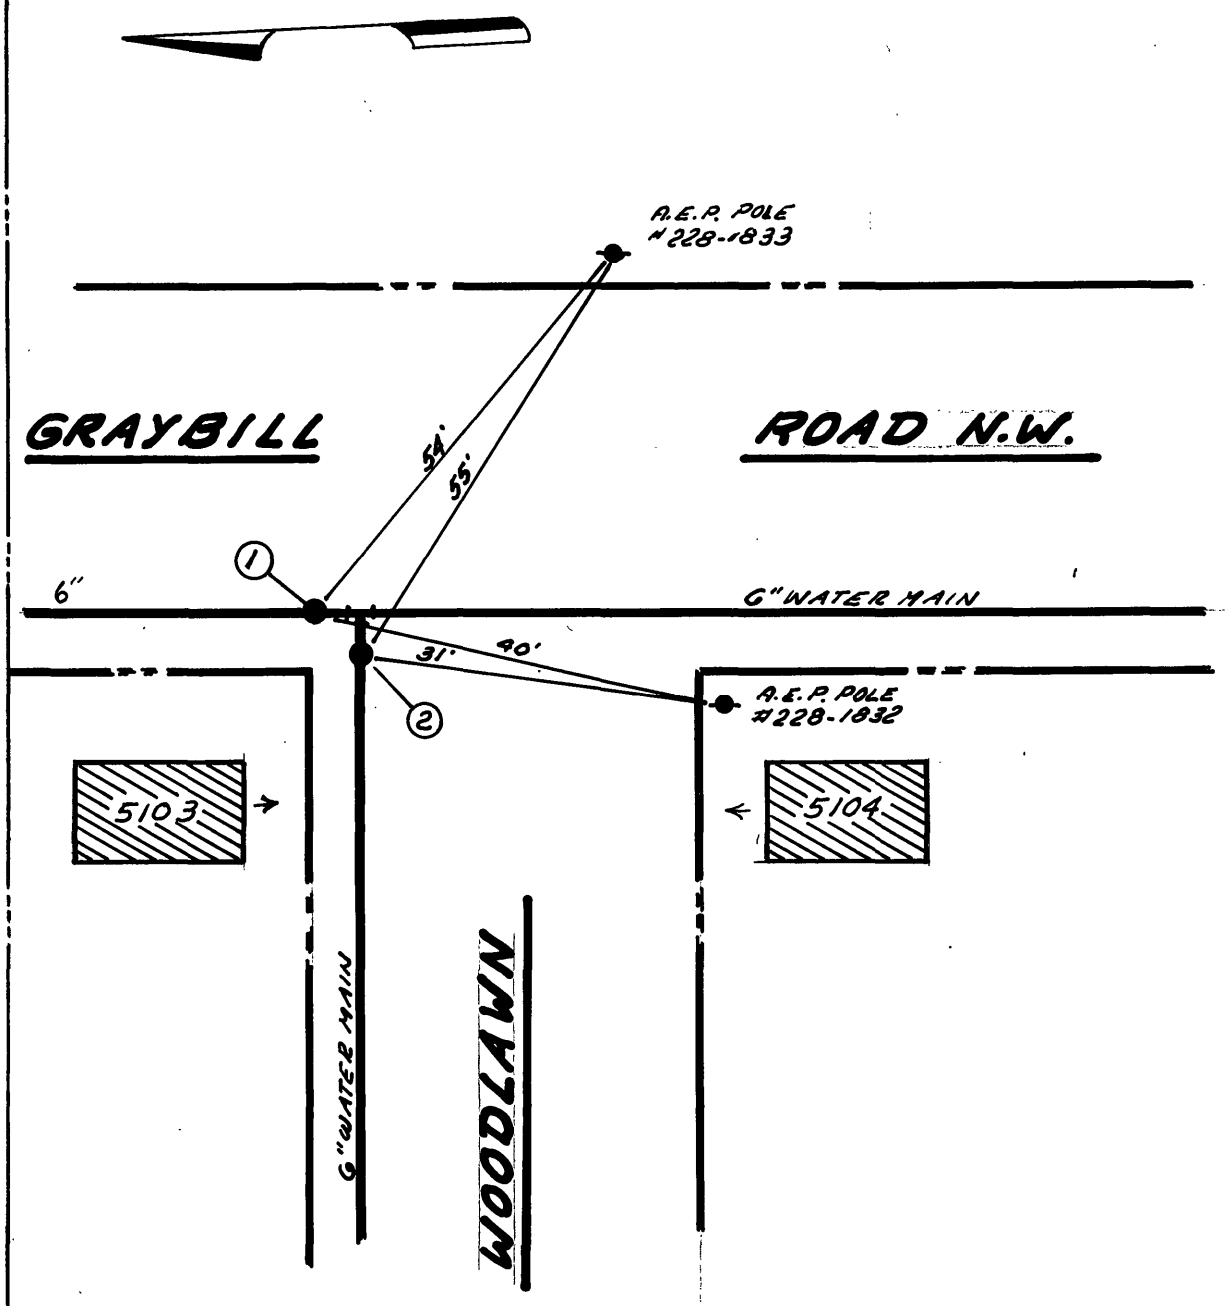

9/2000 JH

DATE	NO.	SIZE	MAKE	OPEN	TURNS
3-84	1	6"	MUL.	R	21
3-84	2	6"	MUL.	R	21

CITY OF ROANOKE—WATER DEP'T

VALVE DIAGRAM

GRAYBILL ROAD &

WOODLAWN

SEC. MAP 611 N.W.

DATE 7-9-84 PAGE NO.