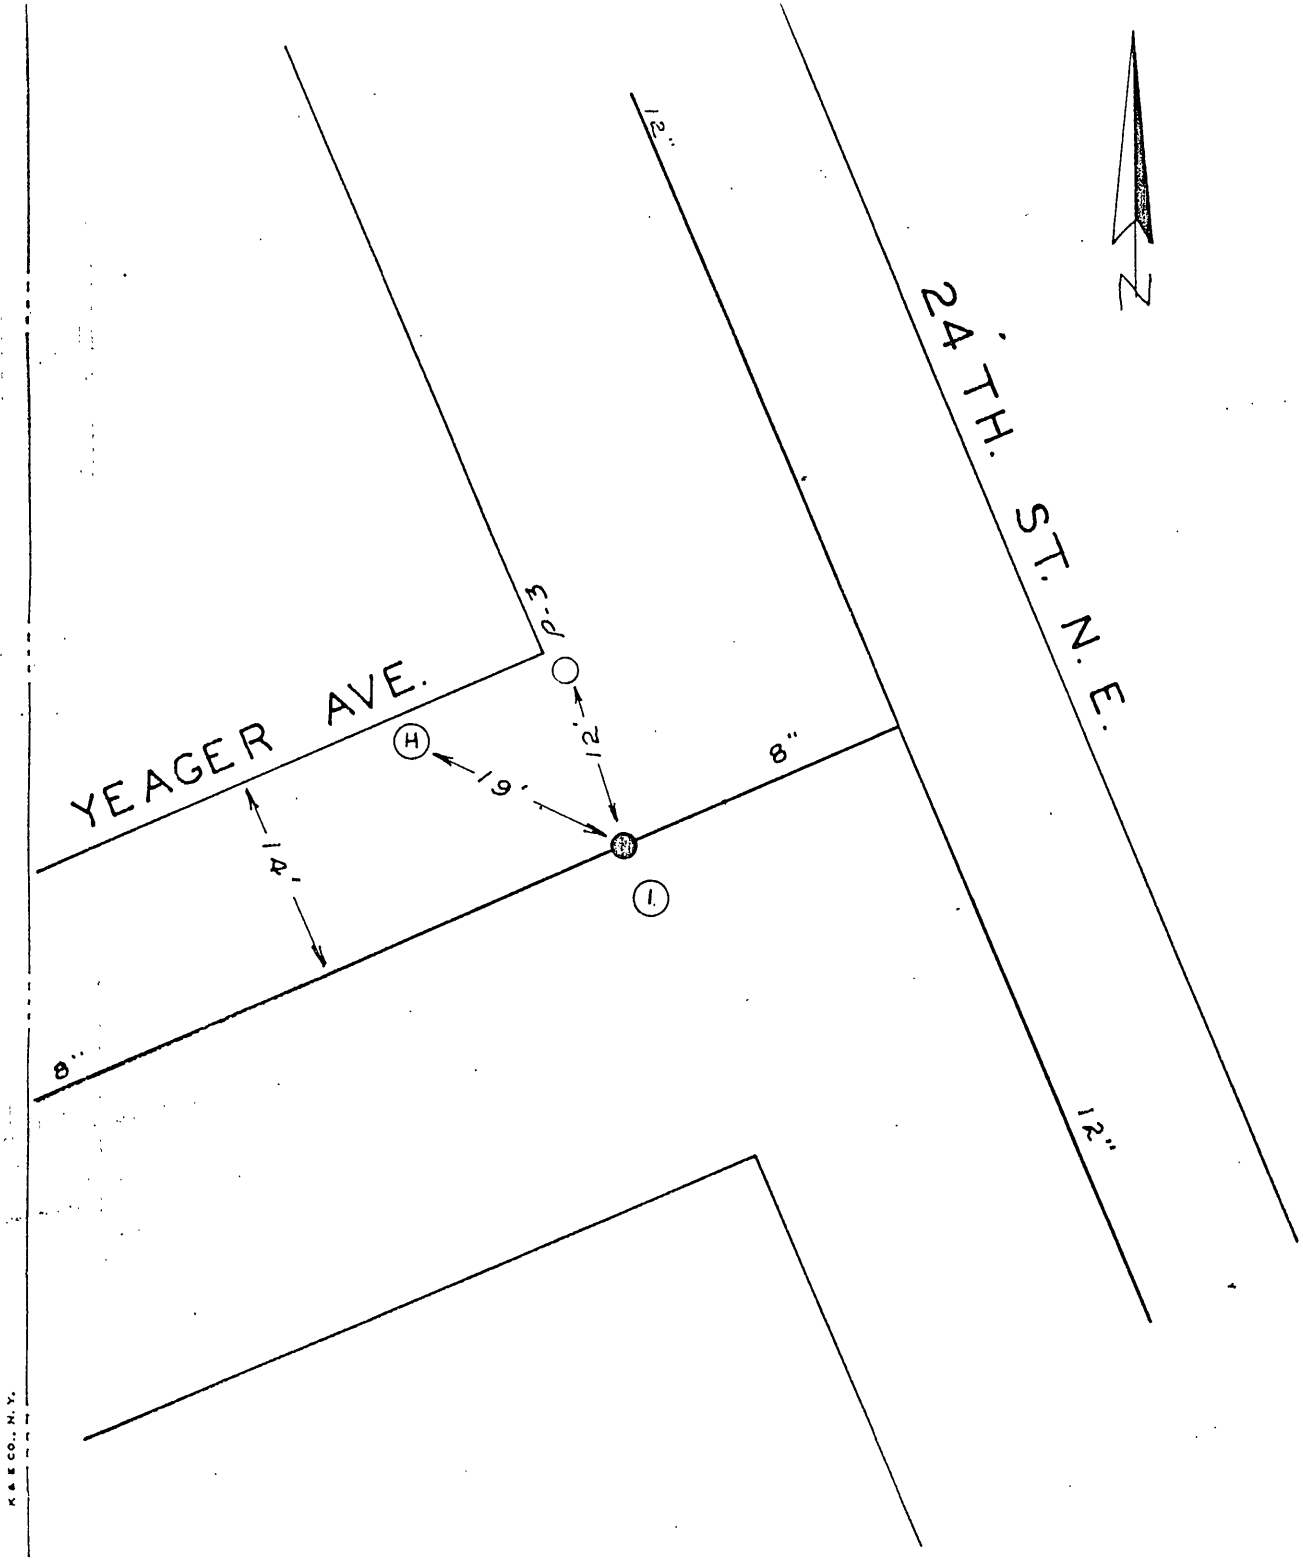

DATE	NO.	SIZE	MAKE	OPEN	TURNS
	1	8"	MUELLER	R	26
	1	0	WPL		

CITY OF ROANOKE—WATER DEPT.

VALVE DIAGRAM

YEAGER AVE. & 24TH. ST. N.E.

SEC. MAP 334

DATE PAGE NO.

"IMPERIAL" TRACING CLOTH. K & E CO., N. Y.