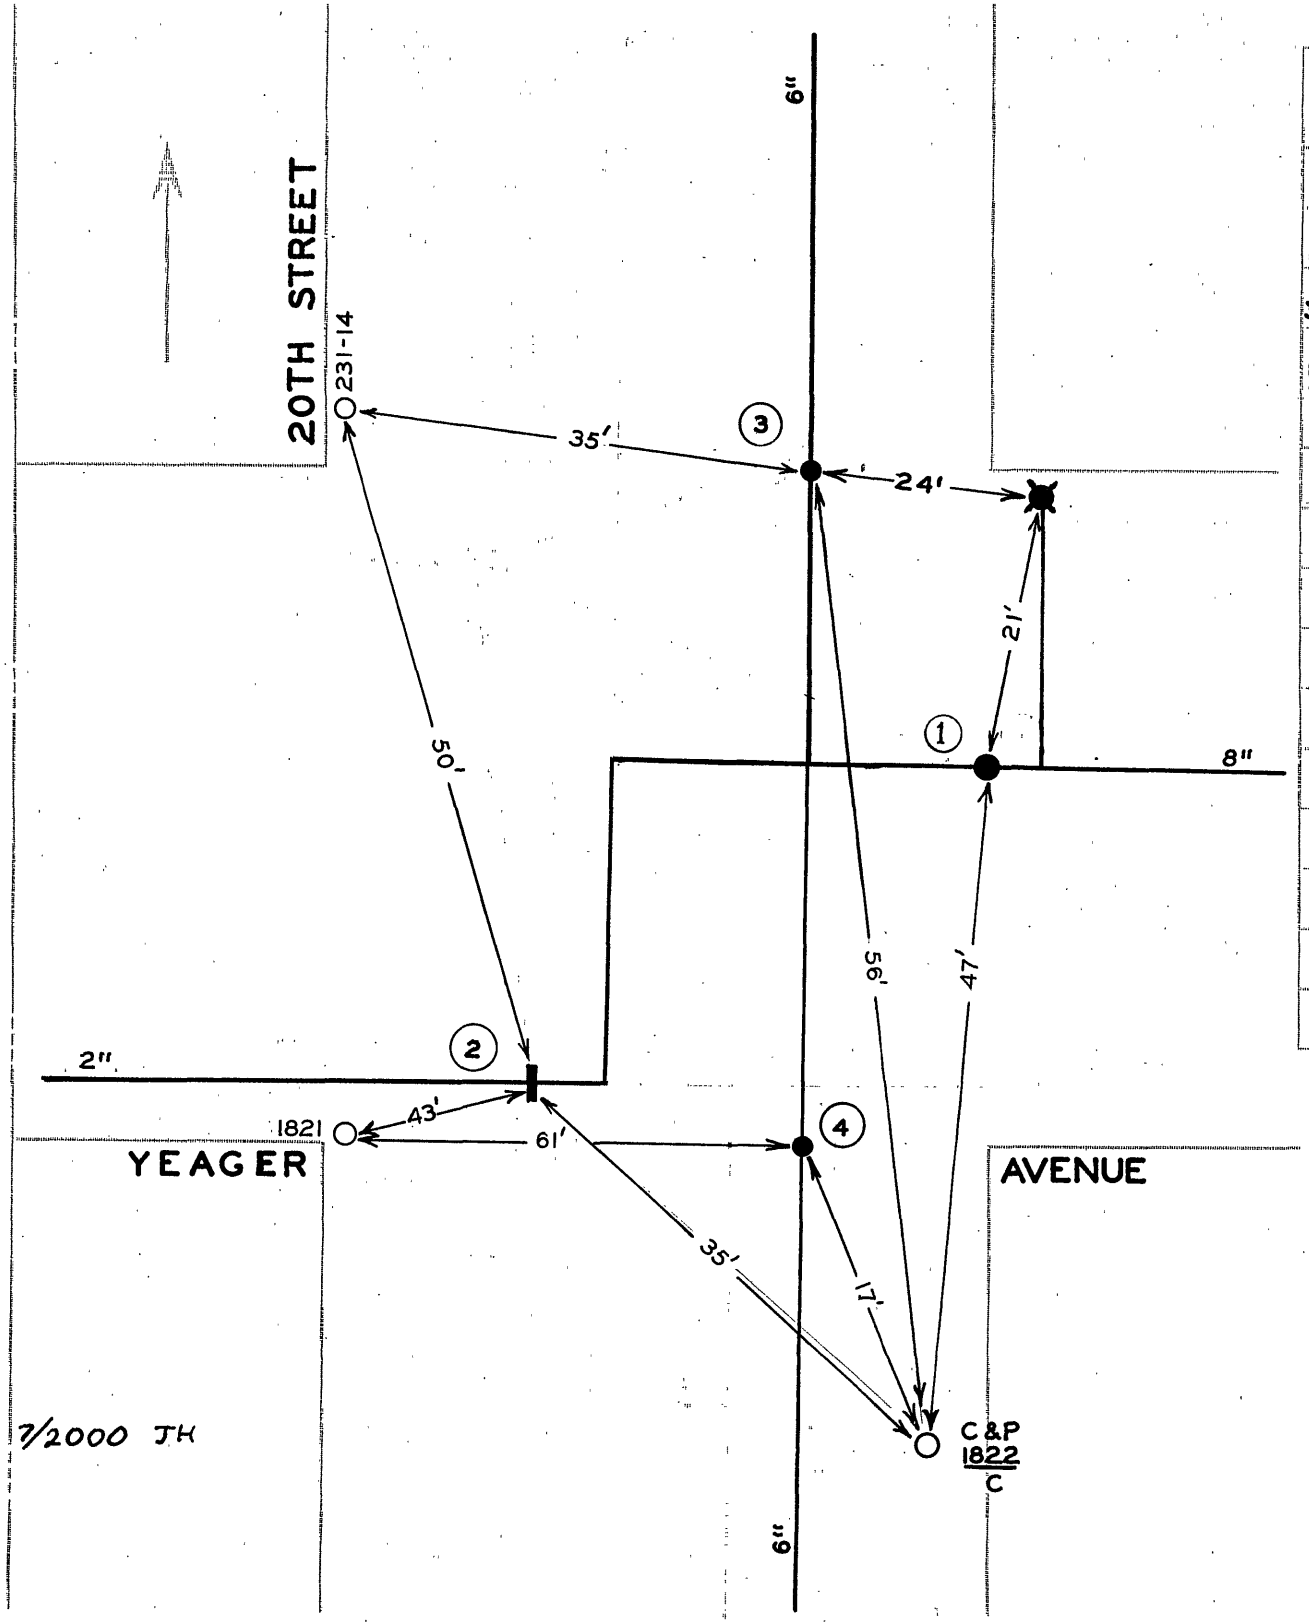

DATE	NO.	SIZE	MAKE	OPEN	TURNS
8-61	1	8"	DARLING	R	
WR 1951	2	2"	W. R.		
3-64	3	6"	MUELLER	R	
8-64	4	6"	MUELLER	R	
	1	0	E.P.L.		
	3	0	N.P.L.		
	4	0	S.P.L.		

CITY OF ROANOKE—WATER DEPT

VALVE DIAGRAM

YEAGER AVENUE &

20TH STREET N.E.

SEC. MAP 334

DATE PAGE NO.