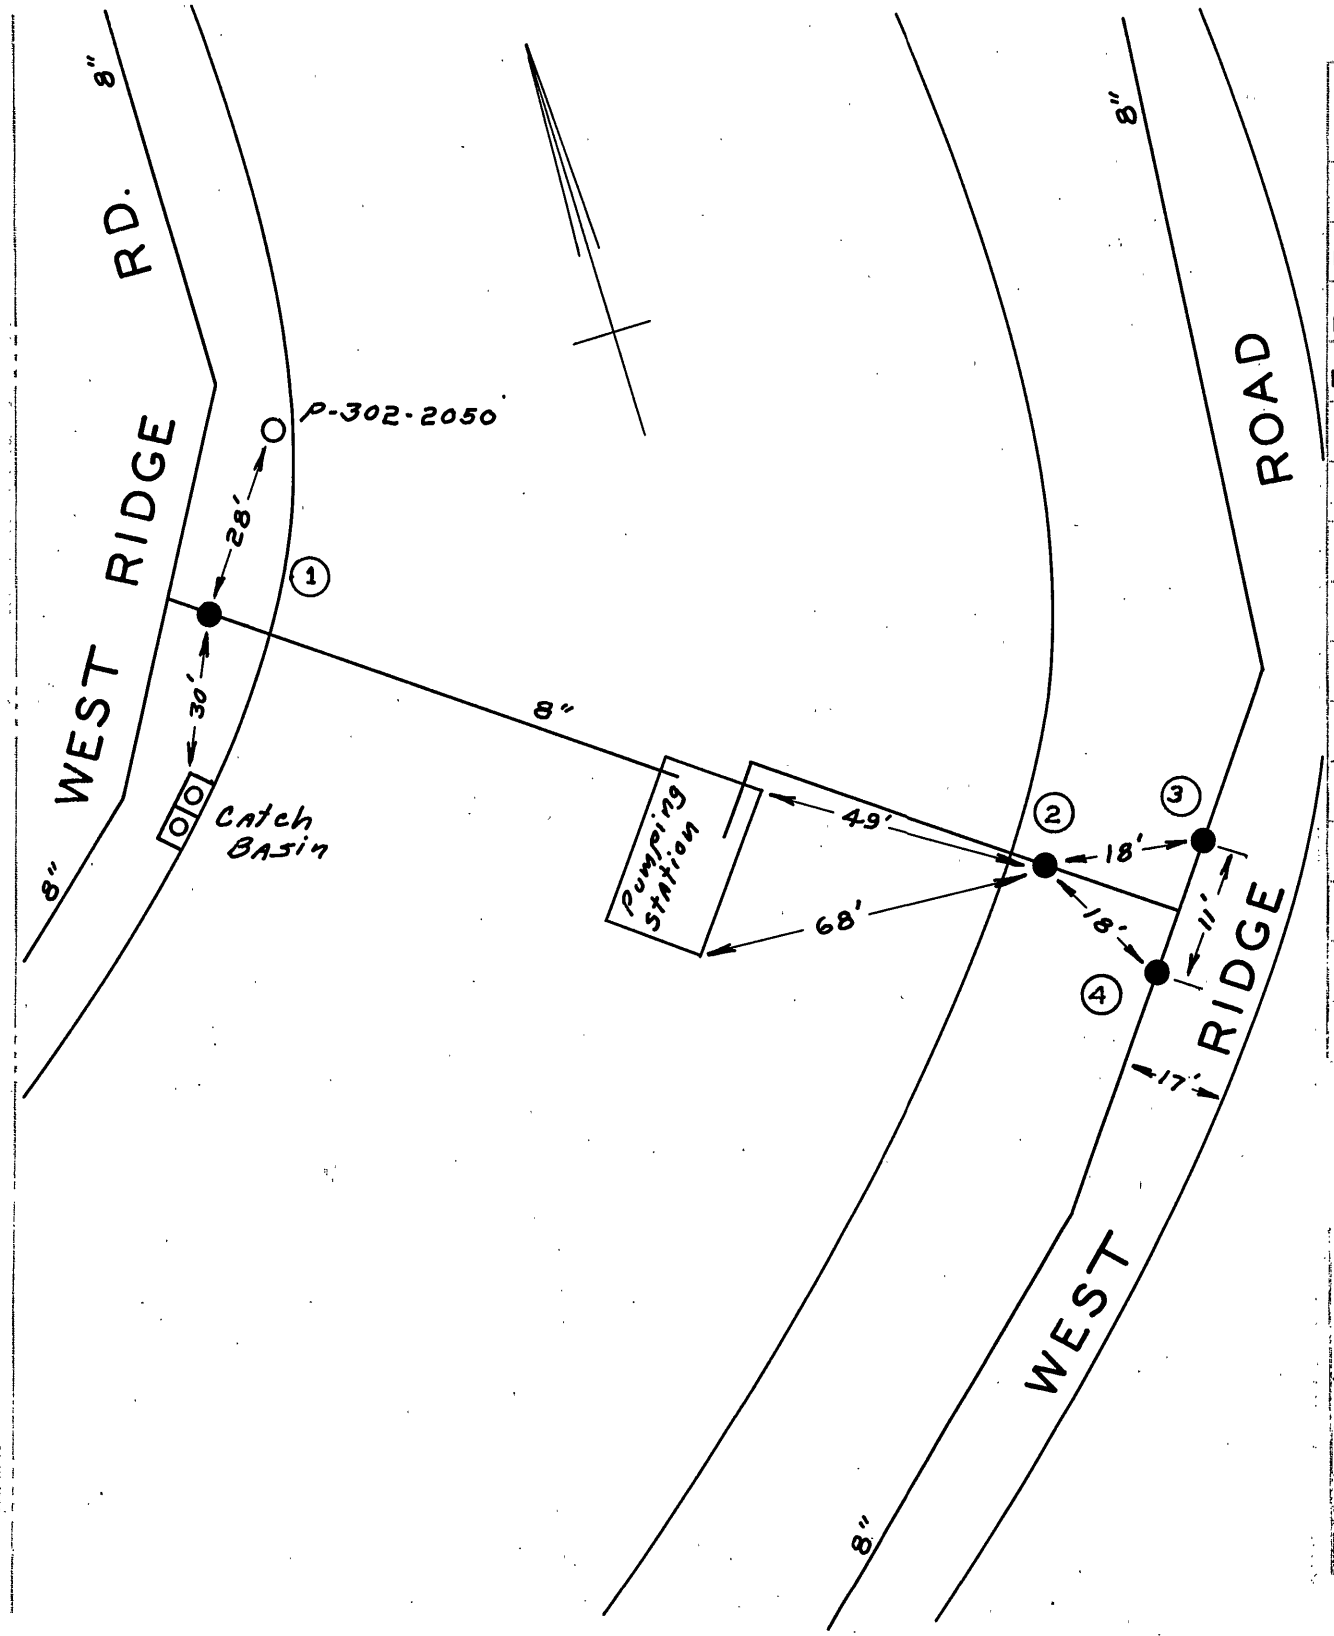

DATE	NO.	SIZE	MAKE	OPEN	TURNS
1955	1	8"	MUELLER	R	
1956	2	8"	MUELLER	R	
1956	3	8"	MUELLER	R	
1956	4	8"		R	

CITY OF ROANOKE--WATER DEPT.

VALVE DIAGRAM

CHAPEL FOREST

PUMPING STATION S.W.

SEC. MAP 108

DATE ..... PAGE NO.