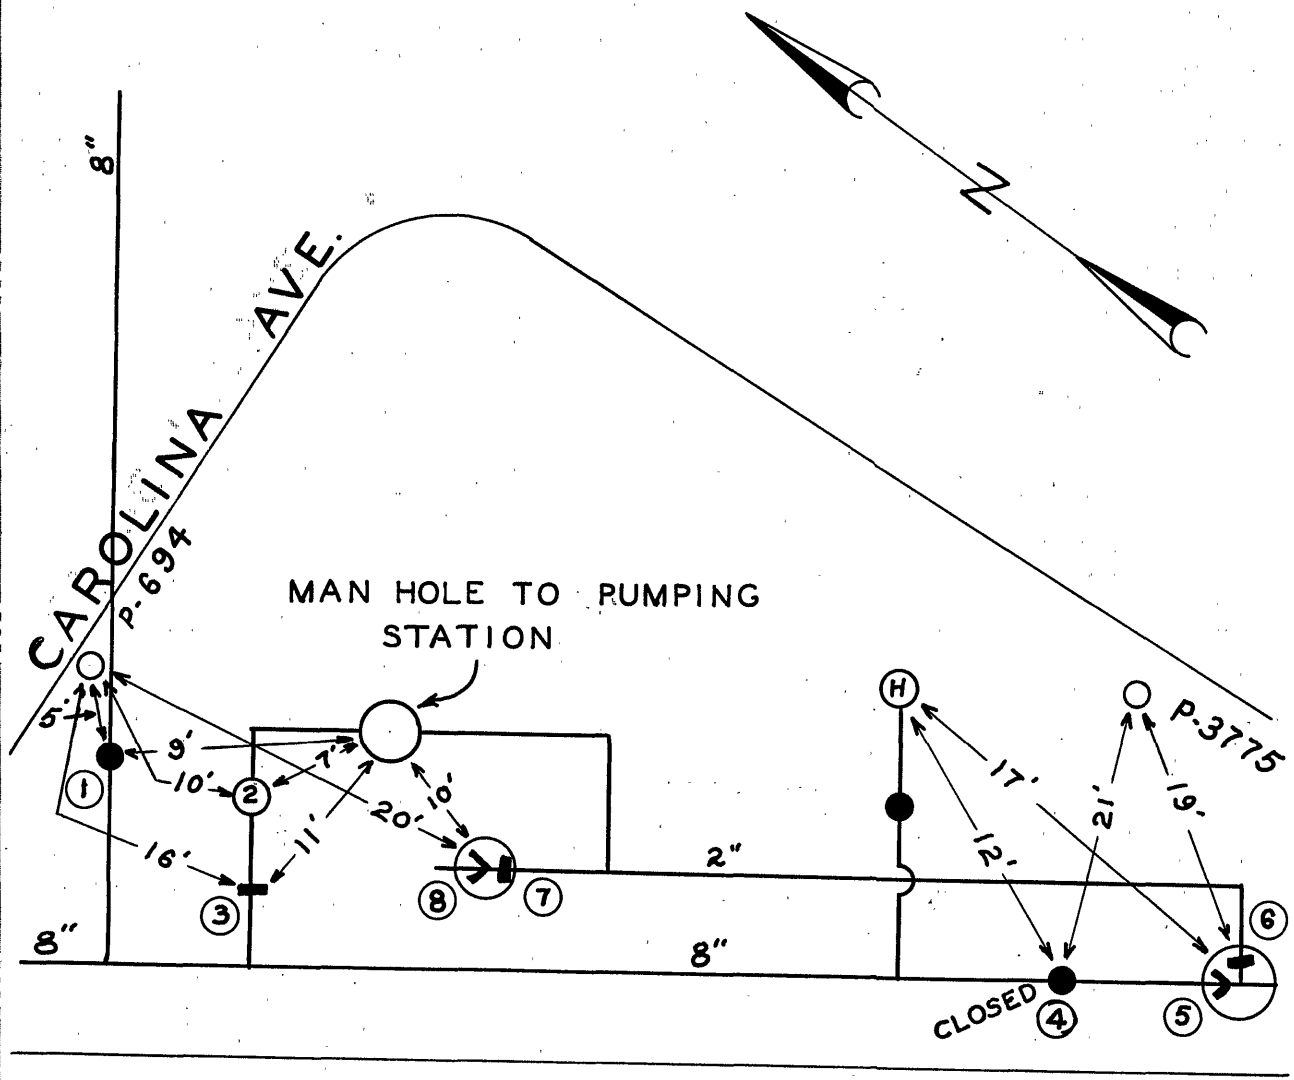

DATE	NO.	SIZE	MAKE	OPEN	TURNS
	1	8"		R	
	2	2"	TO METER	L	
	3	2"		R	
	4	8"		R	
	5	8"	CHECK		
	6	2"		R	
	7	2"		R	
	8	2"	CHECK		

CASSELL LANE S.W.

CHESTNUT HILLS PUMP. STATION

CITY OF ROANOKE—WATER DEPT.

VALVE DIAGRAM

CAROLINA AVE. &

CASSELL LANE S.W.

CHESTNUT HILLS P. S.

SEC. MAP 107

DATE PAGE NO.

"IMPERIAL" TRACING CLOTH
R & B CO., N.Y.