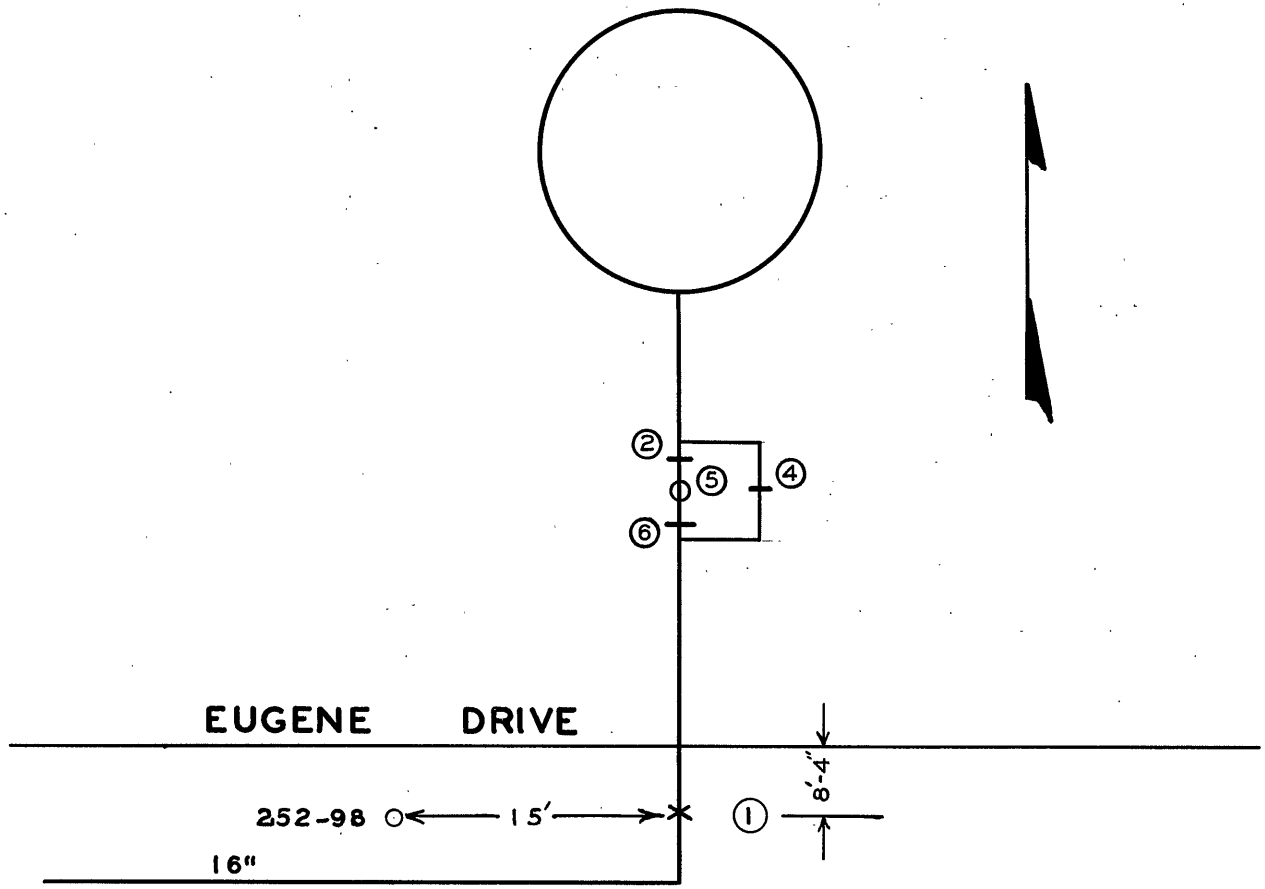

DATE	NO.	SIZE	MAKE	OPEN	TURNS
6-63	1	1"	AIR VALVE		
	2	12"		R	
	3	12"		R	
	4	12"		R	
	5	12"	ALTITUDE	VALVE	

NOTE
VALVE BOXES ARE CLOW
ADJUSTABLE TYPE

CITY OF ROANOKE—WATER DEPT.

VALVE DIAGRAM

EUGENE DRIVE TANK N.W.

SEC. MAP 50

DATE PAGE NO.