


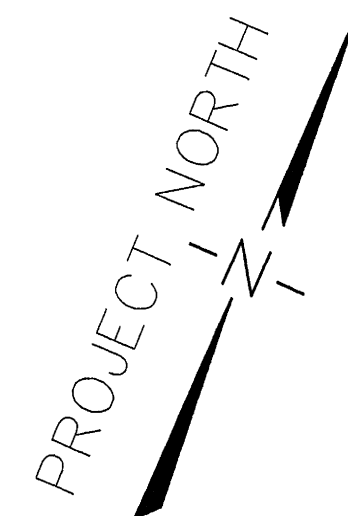


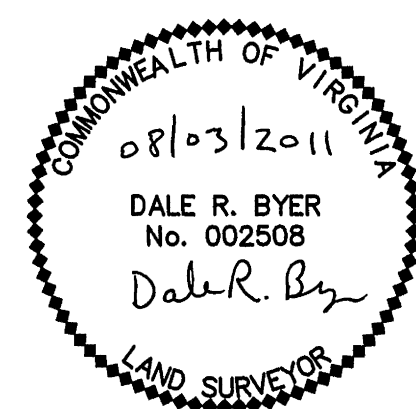

NORTHING	EASTING	ELEVATION	
3636442.147	11093894.038	1676.87	SURVEY MONITORING POINT 1
3636502.105	11094059.973	1671.71	SURVEY MONITORING POINT 2
3636538.299	11094158.834	1671.79	SURVEY MONITORING POINT 3
3636579.358	11094271.890	1672.75	SURVEY MONITORING POINT 4

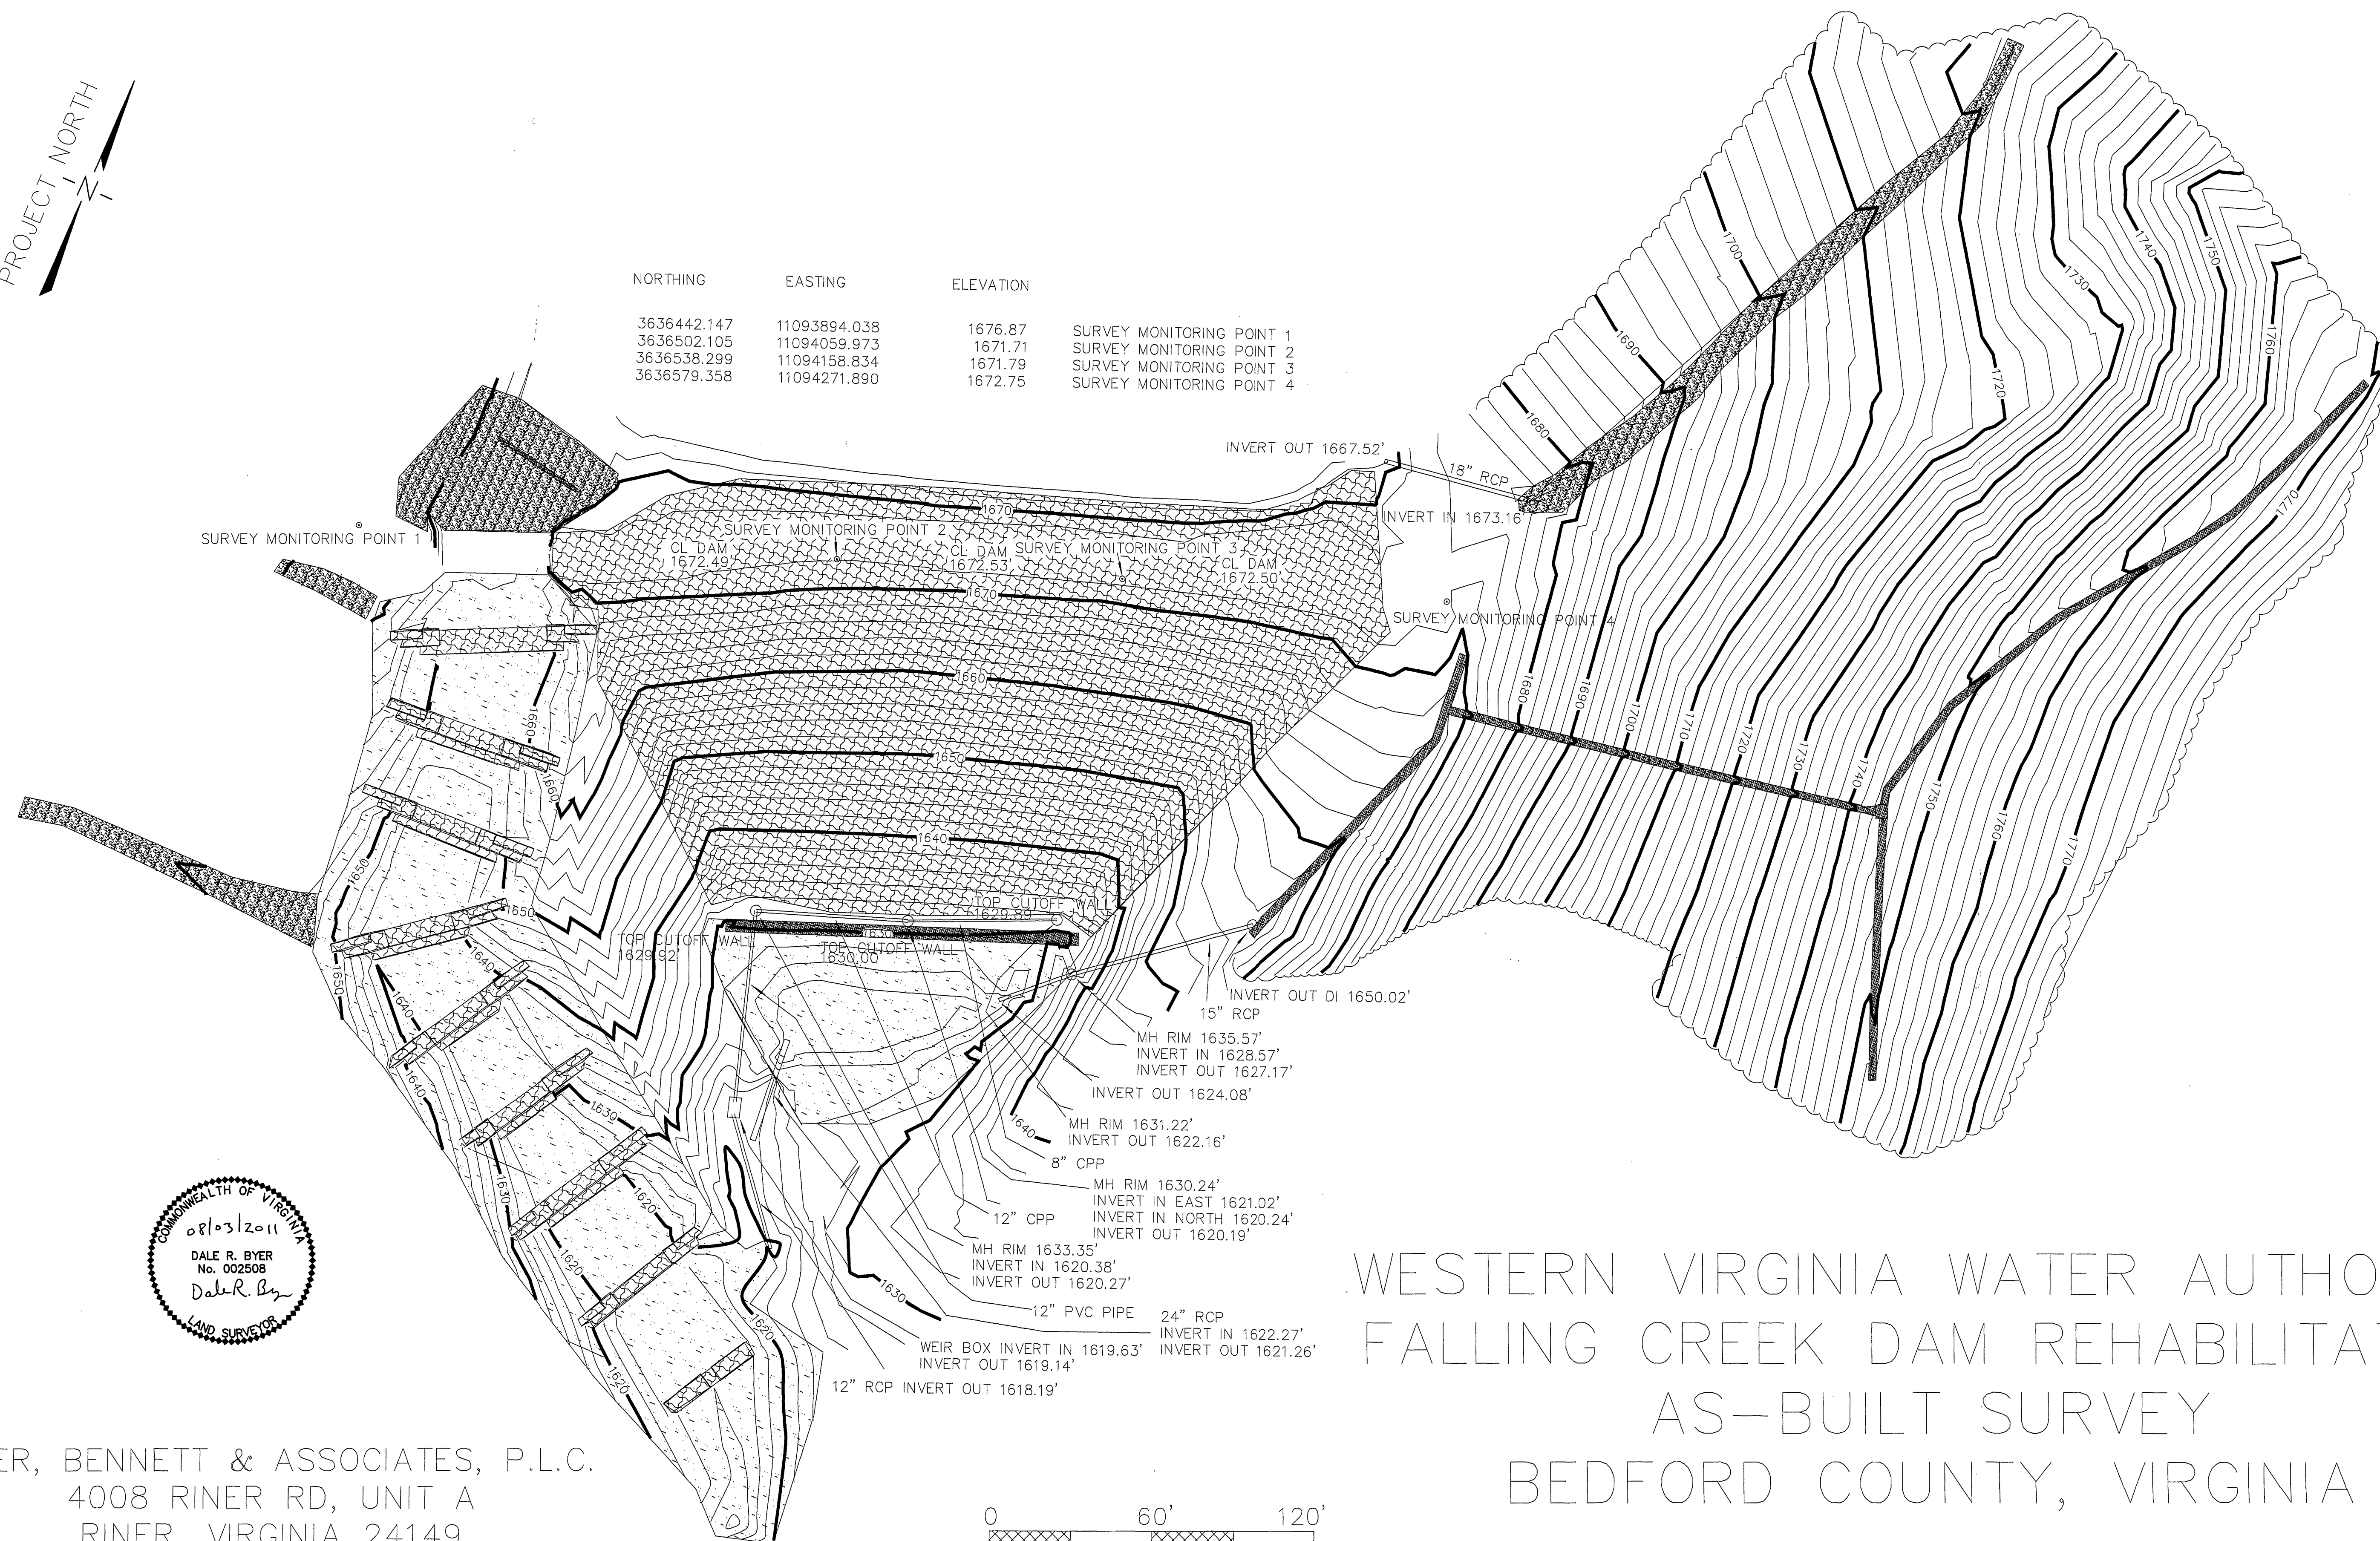

BYER, BENNETT & ASSOCIATES, P.L.C.
4008 RINER RD, UNIT A
RINER, VIRGINIA 24149
(540)381-7004

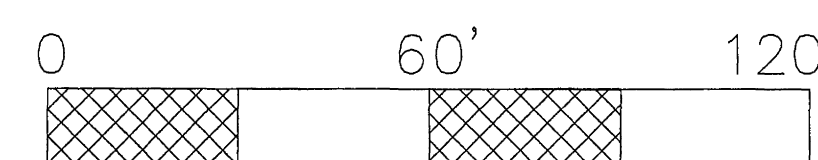

WESTERN VIRGINIA WATER AUTHORITY FALLING CREEK DAM REHABILITATION AS-BUILT SURVEY BEDFORD COUNTY, VIRGINIA