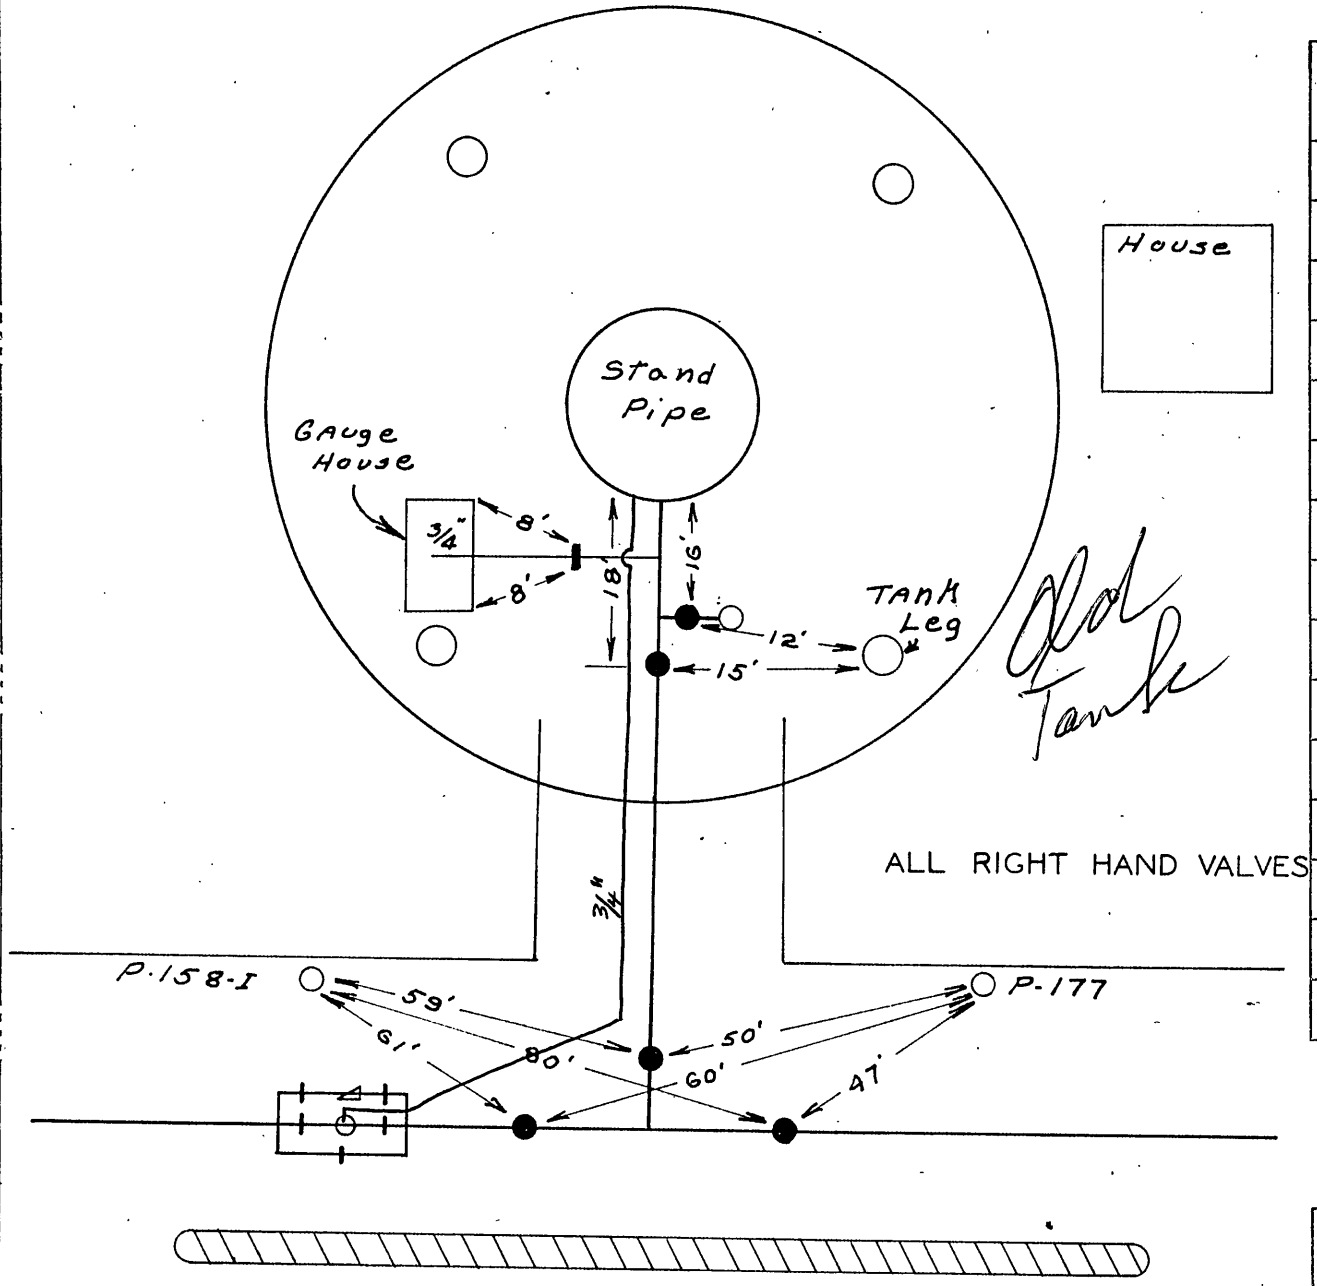

DATE	NO.	SIZE	MAKE	OPEN	TURNS

3/4" sensing line from Riser to Alt. valve installed Sep 1975.

CITY OF ROANOKE—WATER DEPT.

VALVE DIAGRAM

HOLLINS ELEVATED TANK

& U.S ROUTE 11 AT

DRIVE WAY N.E.

SEC. MAP 22

DATE PAGE NO.

"IMPERIAL" TRACING CLOTH K & E CO., N. Y.