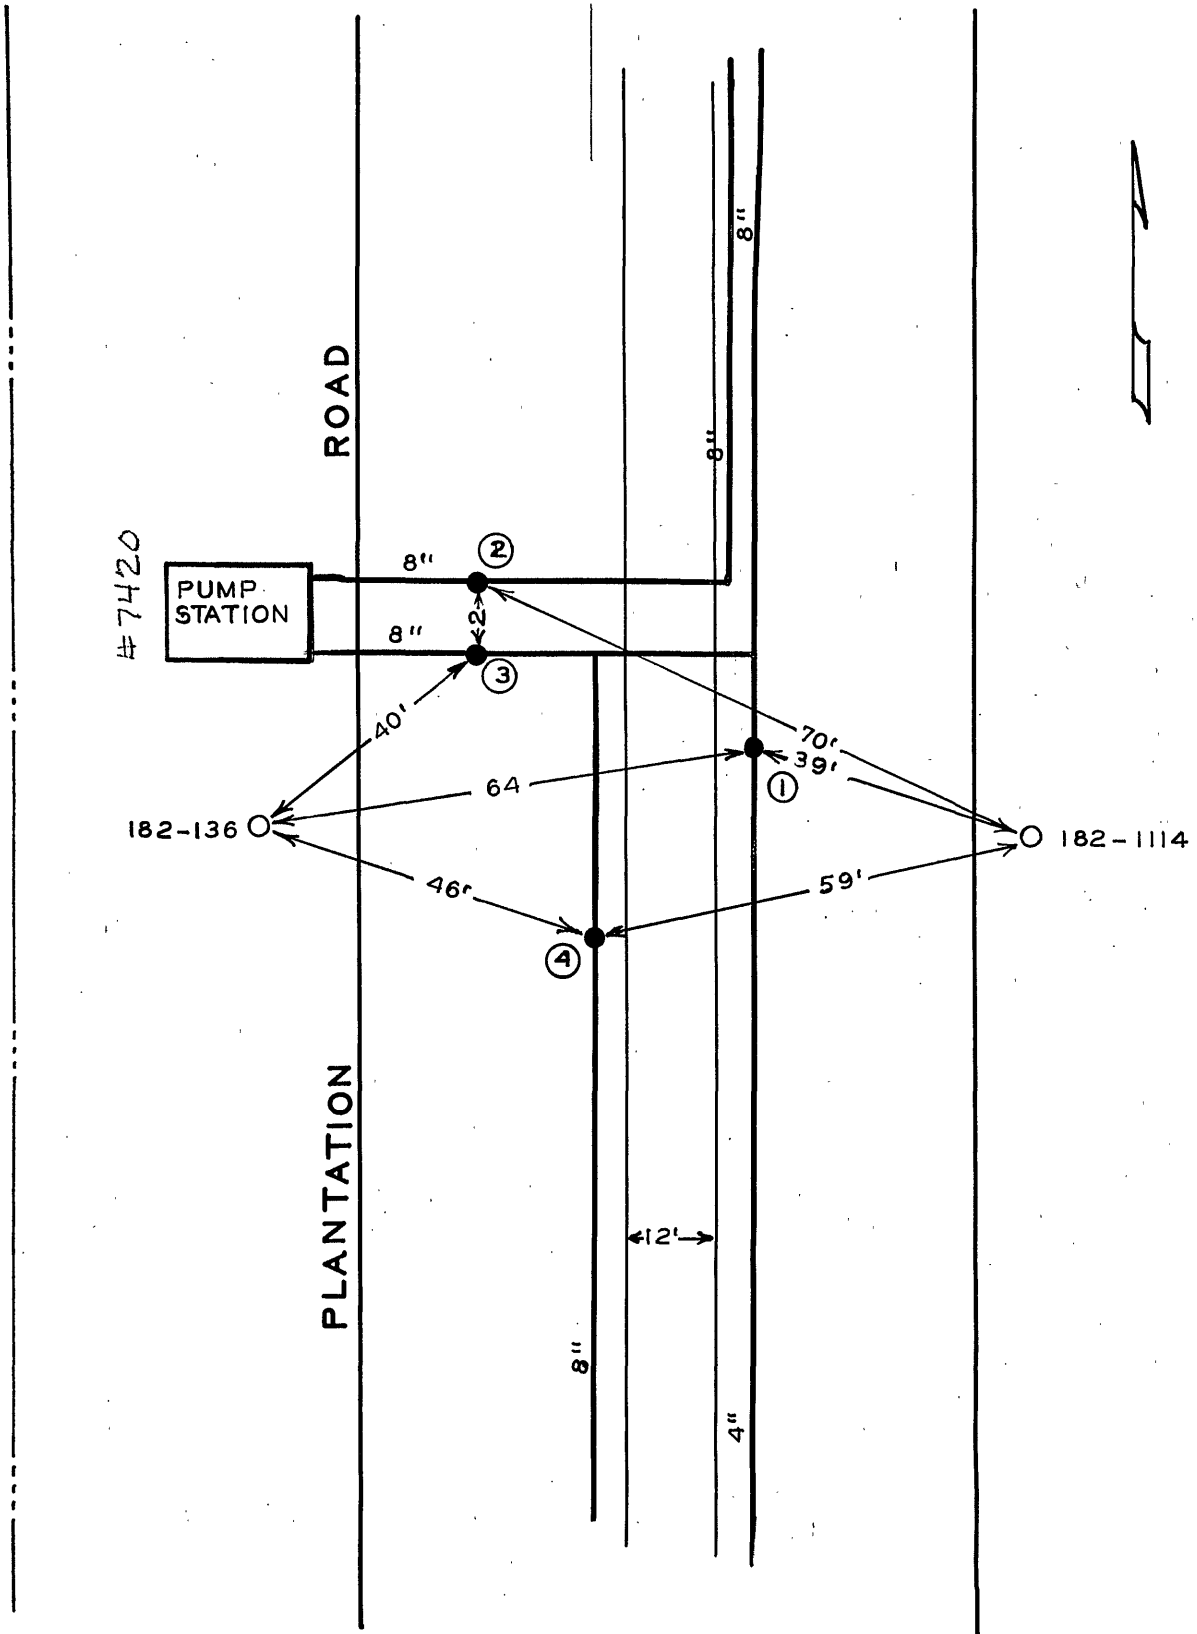

DATE	NO.	SIZE	MAKE	OPEN	TURNS
1947	1	4"	DARLING	R	9
1947	2	8"	DARLING	R	27
1947	3	8"	DARLING	R	27
1966	4	8"	MUELLER	R	26 1/2

CITY OF ROANOKE—WATER DEPT.

VALVE DIAGRAM

PLANTATION ROAD AT HOLLINS PUMP STATION N.E.

SEC. MAP 18

DATE **PAGE NO.**