




EXPLANATION

- B-3 Existing Test Boring Locations
- B-1* Test Borings with Water Level Monitoring Well
- Spring Location
- BRW-1 Previous Borrow Source Test Borings for Rockfill Dam
- Sinkhole Location

NOTES
SPRINGS NEAR B-5, B-9
BORING B-20 HAS A WELL
WHICH THE NEW BORING
14A, 15, 16, 17A
WHY USE 12-11-2-B?
BORING 14A HAS WELL NOW
SHOW WATER SPRINGS UNDER
AND LARGE POND & SMALL
POND LITTLE (100)

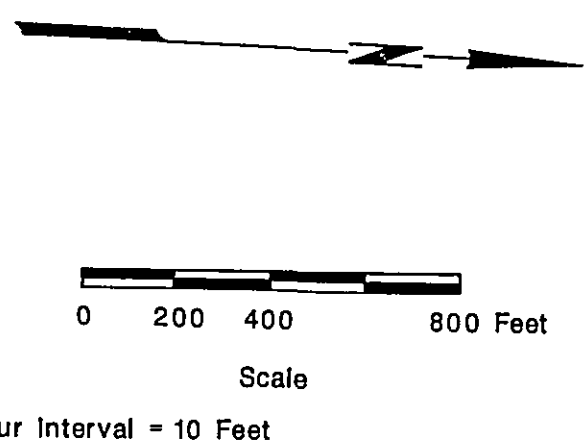

Schnabel Engineering Associates, P. C.			
Sheet 1			
Location of Proposed Dam, Test Borings, Springs and Geomorphological Features in Spring Hollow			
Date 6/7/89	Drawn By KRF	Checked By GMM	Project V880313