


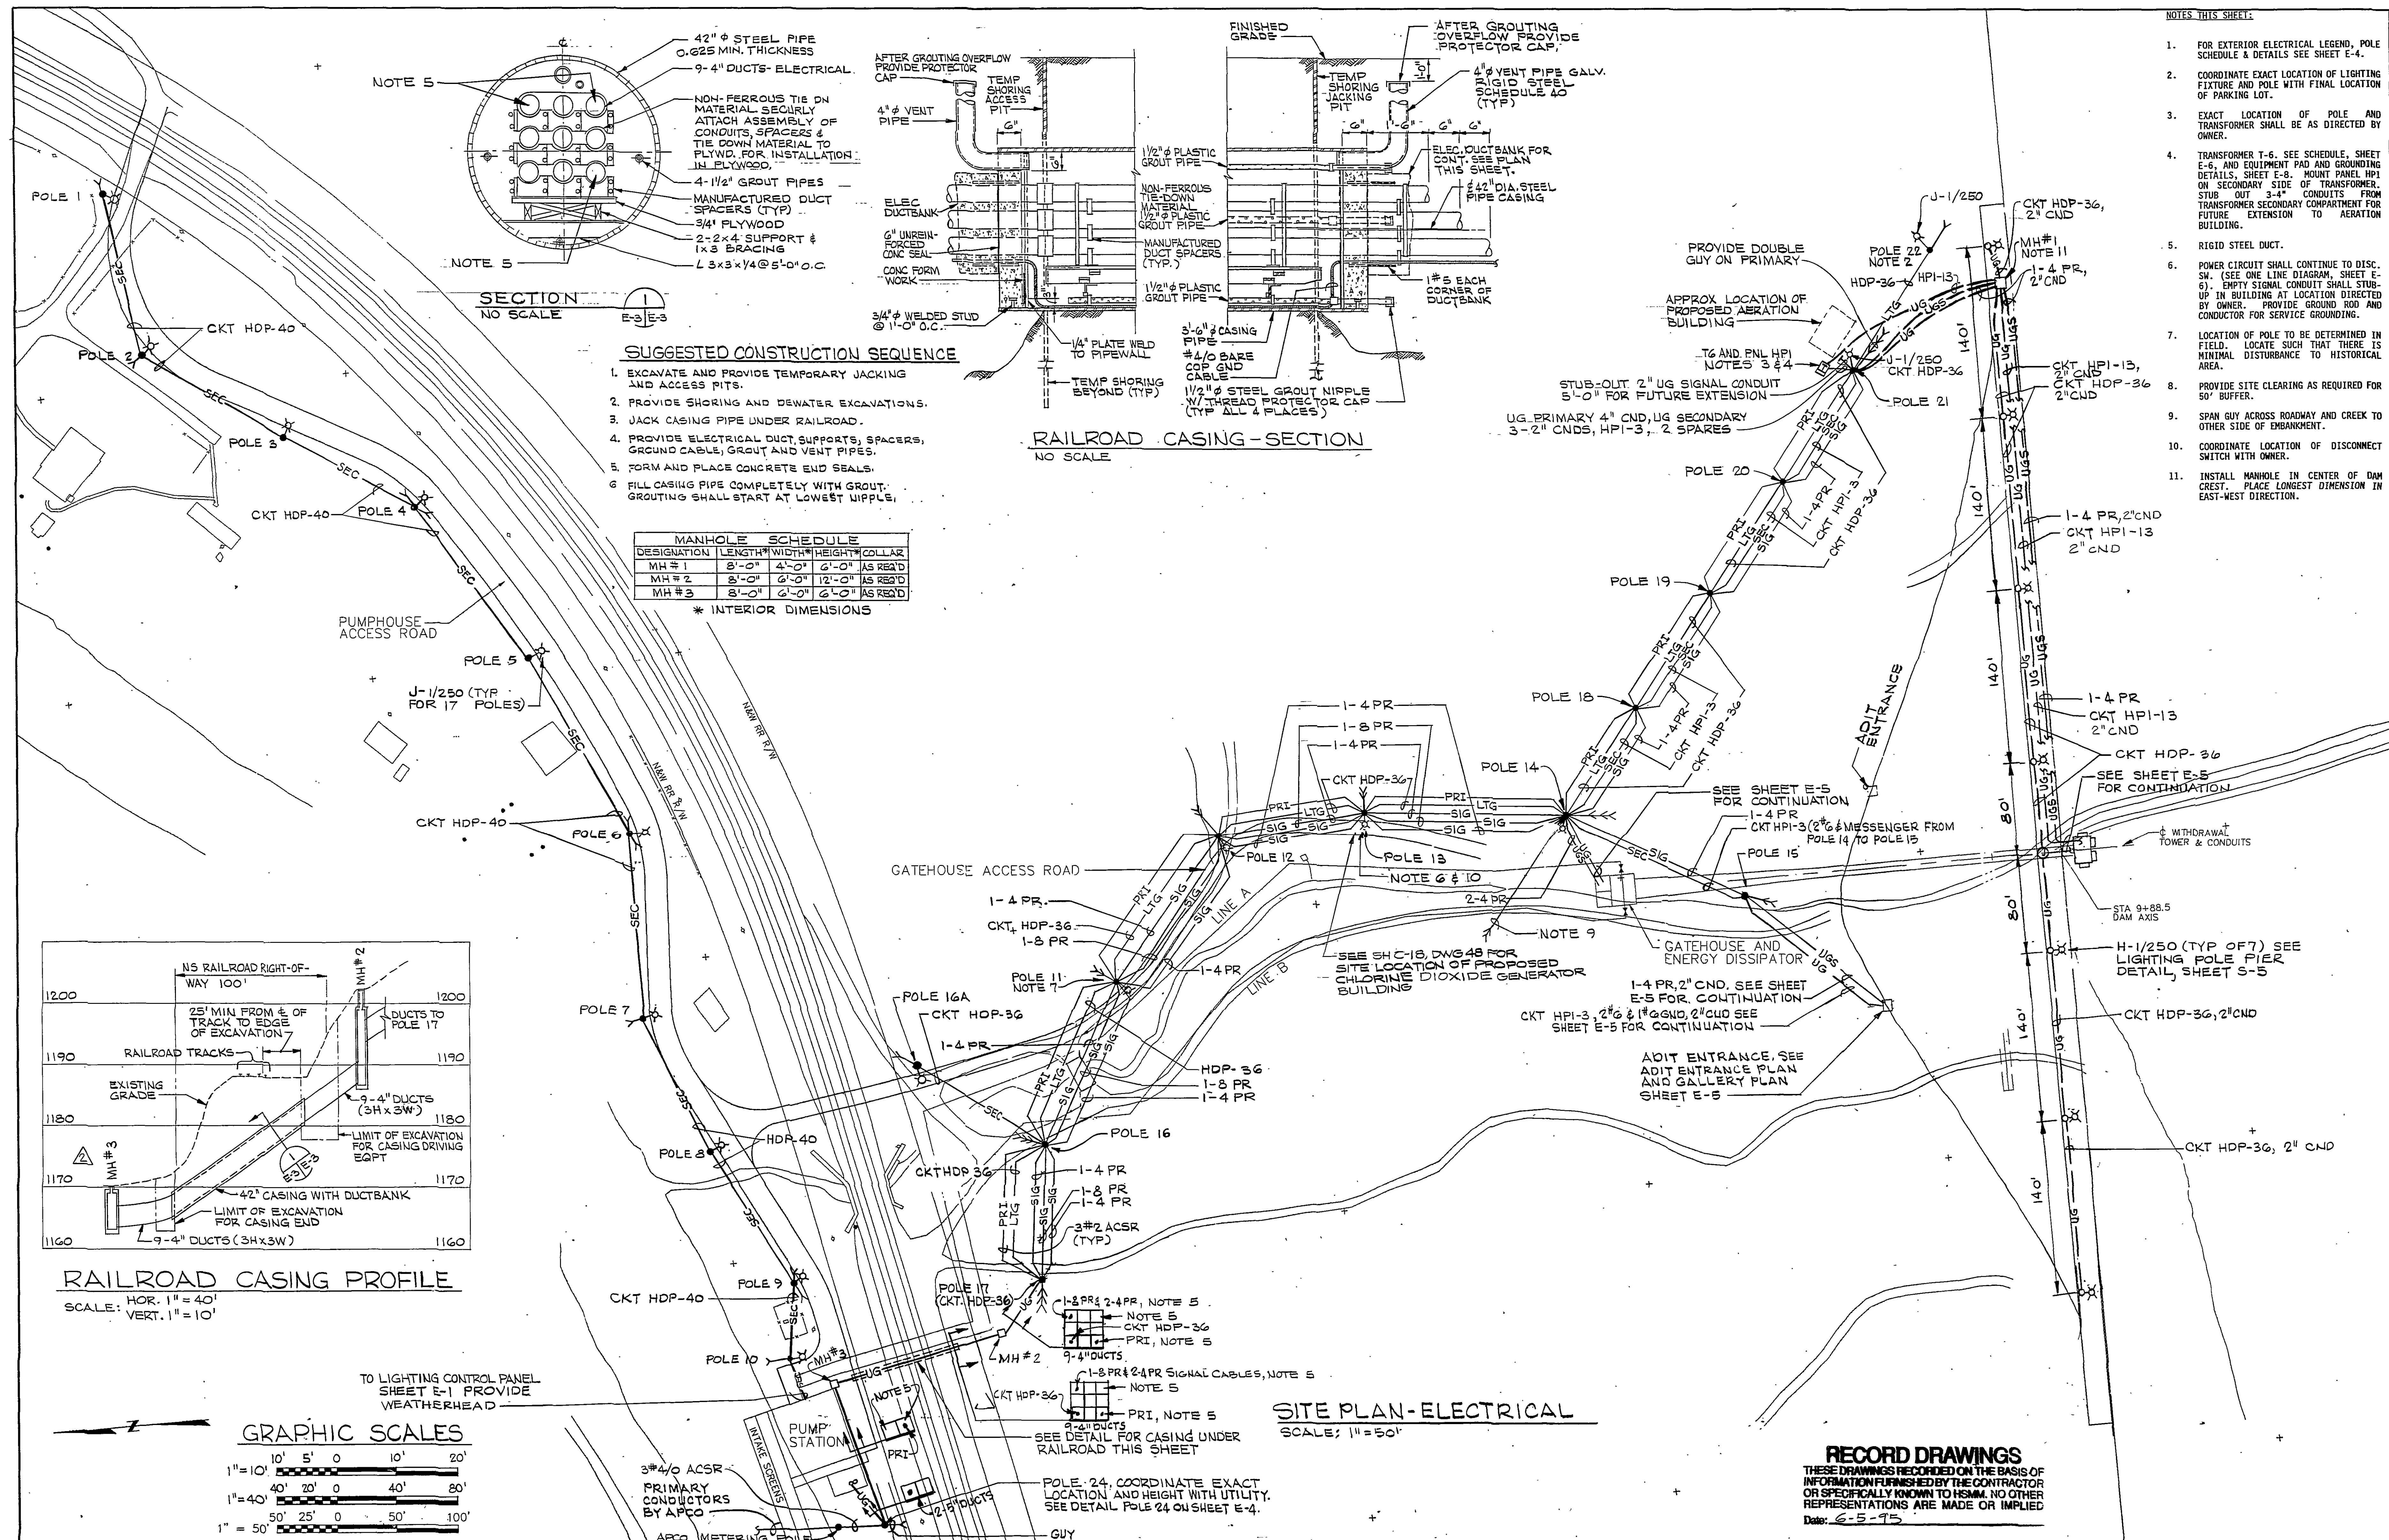

DESIGNED	<u>Set / esc</u>	DATE	<u>3/30/74</u>		REVISIONS	
DRAWN	<u>RAB</u>	DATE	<u>3/30/74</u>		DATE	BY	DESCRIPTION	DATE	BY	DESCRIPTION	
CHECKED	<u>Rm</u>	DATE	<u>3/30/74</u>		<u>3/30/74</u>	<u>Set</u>	<u>RELOC RD & POWER TO DAM</u>	
APPROVED	<u>RW</u>	DATE	<u>3/4/74</u>		<u>3/30/74</u>	<u>Set</u>	<u>RE CASING, SITE PLAN</u>	
ISSUED	<u>flb</u>	DATE	<u>8/21/74</u>		<u>3/30/74</u>	<u>Set</u>	<u>PER CONTR RECORD DWG</u>	