NOTE:
1. ALL PLATE 6061–T6 ALUMINUM
2. ALL PIPE 6061–T6 ALUMINUM
3. ISOLATE ALUMINUM FROM DISSIMILAR METAL AND CONCRETE WITH RUBBER GASKET MATERIAL.

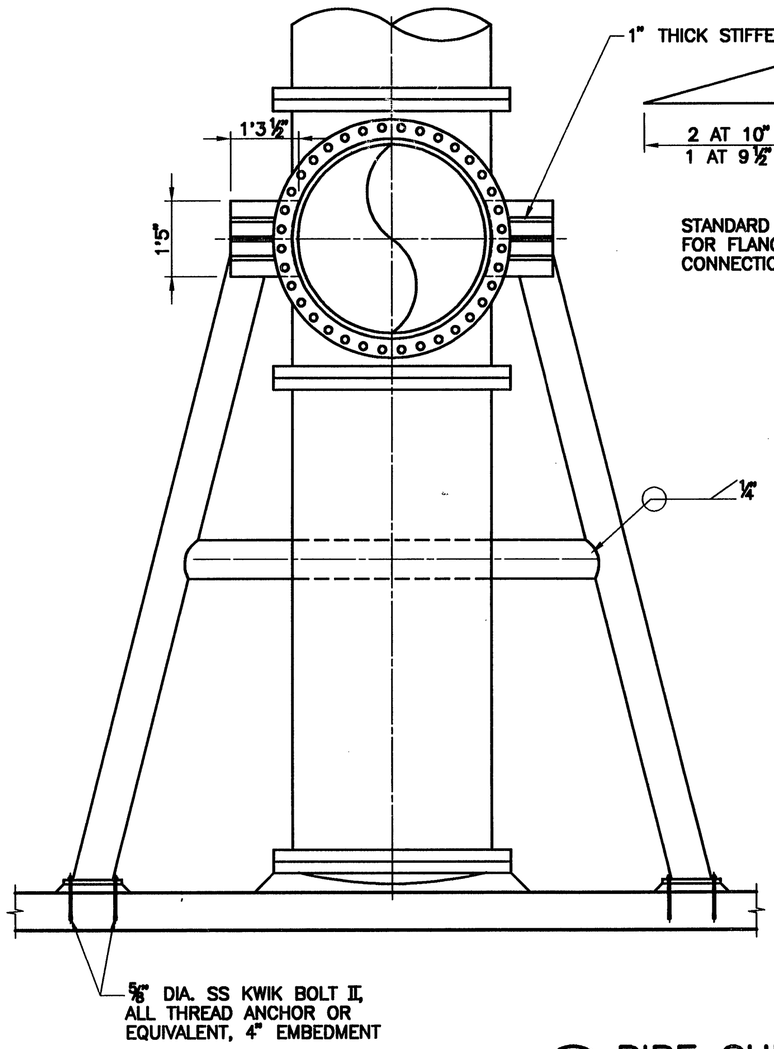

SIDE

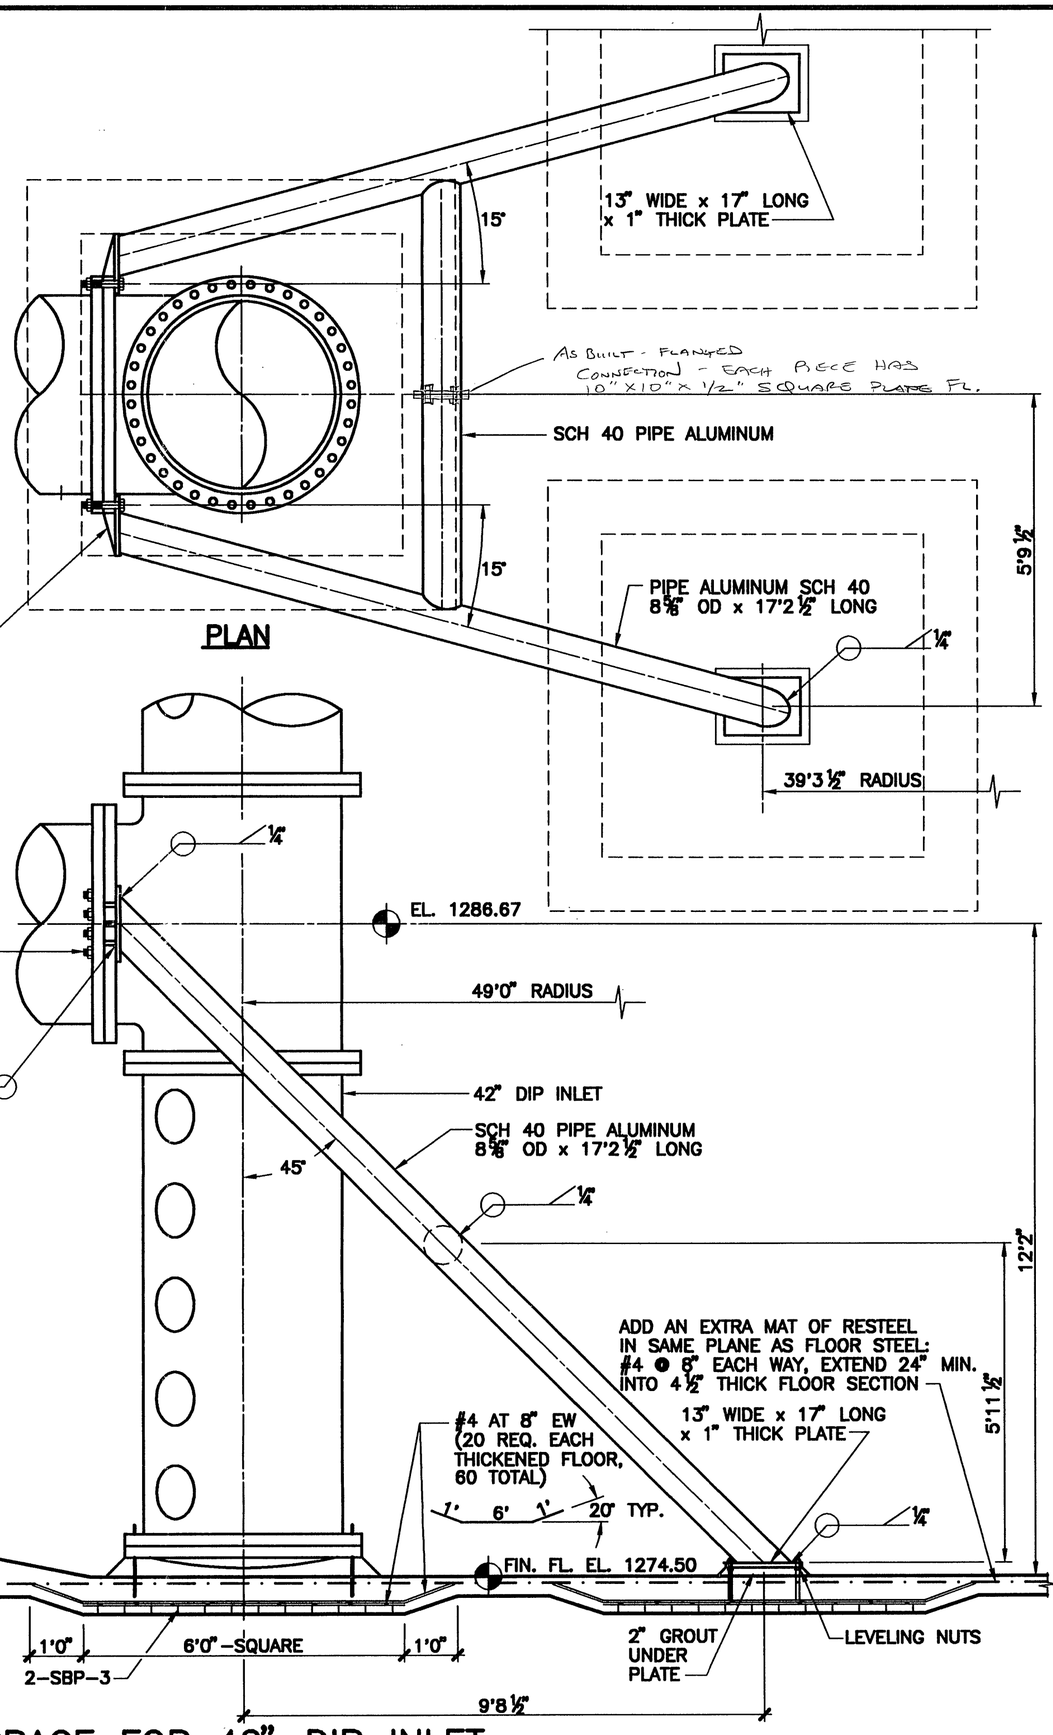

(25) PIPE SUPPORT BRACE FOR 42" DIP INLET

1' 0 1' 2' SCALE 1/2"=1'0"

COPYRIGHT © 1995 BY THE CROM CORPORATION–ALL RIGHTS RESERVED

CROM

DATE: 03–21–95
DRAWN: DSK
CHECKED: MMCL
APPROVED: MMCL
DESIGNED: JSW

TANK DESCRIPTION:
2.0–MG CLEAR WELL

TANK DIMENSIONS:
112'0" ID x 28'0" SWD

TANK BUILDER:
THE CROM CORPORATION
GAINESVILLE, FLORIDA

OWNER:
COUNTY OF ROANOKE
VIRGINIA

CONSULTING ENGINEER:
ROANOKE COUNTY UTILITY DEPARMENT

REV.	DESCRIPTION	DATE CK.BY

WHERE STANDARD SPECIFICATIONS ARE IN CONFLICT WITH CROM CORPORATION SPECIFICATIONS OR WITH GOOD PRE–STRESSING OR SHOTCRETE PRACTICES THE STANDARD SPECIFICATIONS SHALL BE SUBORDINATED.
THIS DESIGN AND DRAWING ORIGINATED BY AND THE EXCLUSIVE PROPERTY OF THE CROM CORPORATION.

BAR IS ONE INCH ON ORIGINAL DRAWINGS 0 1"

SCALE: AS NOTED

FILE NO. 9449.2

SHEET 16 OF 19

C:\TPC\ROANOKE Tue Mar 21 17:28:59 1995