


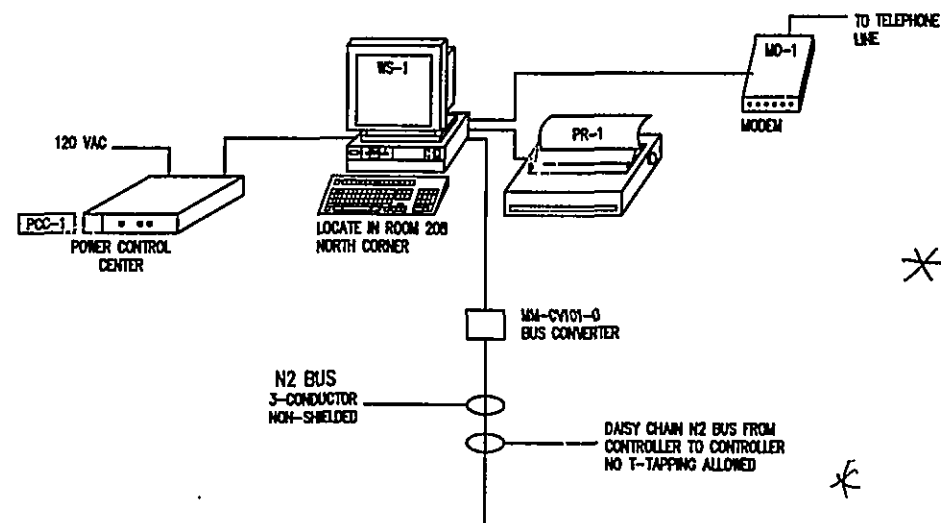

* marked on tile by
Yellow head pin

Located in tool
Room

Thru out bay
in lower level

DC-9100
EN-3
N2-3
AH-11, 12, 13 & 14
XT-1
XP-1, 2
XT-2
XP-3, 4
XT-3
XP-5, 6
XT-4
XP-7, 8
XT-5
XP-9
XT-6
XP-10

mens
Toilet
Above ceiling
Back wall

Above ceiling
in breakroom

Located in
1st Lab on
Left past the
control Room
above the ceiling

Back wall

Located in
chemical Rm

to the Left of
the water ball
in the lobby
above ceiling

Beside left
supply grill

TREATMENT
BUILDING

GAC
BUILDING

POST
TREATMENT
BUILDING

DEVICE TAG	QTY	CODE NUMBER	DESCRIPTION
MD-1	1	144 POKET	MODEN-HAYES
PCC-1	1	3000	POWER CONTROL CENTER-EPI CORP
PR-1	1	56312	EPSON PRINTER FX 850-COMPAQ
SP-1	4	TE/IC4C12	486SX/33MHz 4MB-21MB,COMP
VS-1	1	63633	MODEN CABLE-COMPAQ
	1	39561	MICROSOFT PS/2 MOUSE-COMPAQ
	1	53511	DOS & WINDOWS-COMPAQ
	1	MM-CPT101-0	COMPANION COLOR GRAPHICS
	1	MM-CPT101-0	COMPANION PC VERSION REV
	1	MM-CVT101-0	RS232-RS485 CONVERTER

JOHNSON CONTROLS DAMPER SCHEDULE

PROJECT/ADDRESS:	ROANOKE COUNTY WATER TREATMENT FACILITY	SHEET:	5066-0013
BUILDING DESIGNATION:		CONTRACT:	5066-0013
MECHANICAL CONTRACTOR:		PREPARED BY:	GA
SHEET METAL CONTRACTOR:		DATE:	05/10/95
		BRANCH:	ROANOKE

TAG	SYSTEM	SERVICE	SECT. LABEL	QTY	FAIL POS.	DAMPER TYPE	DAMPER SIZE	REF DET	DUCT INFORMATION	ACTUATOR INFORMATION
							WIDTH	HEIGHT	DUCT SIZE	QTY CODE NUMBER
									WIDTH	HEIGHT
F-35	INTAKE	-	1 NC	48	66	48	66			
F-36	INTAKE	-	1 NC	12	18	12	18			
F-46	INTAKE	-	1 NC	30	12	30	12			
F-47	INTAKE	-	1 NC	9	24	9	24			
F-28	INTAKE	-	1 NC	48	18	48	18			
F-31 & 32	INTAKE	-	1 NC	90	48	90	48			
F-41	INTAKE	-	1 NC	48	36	48	36			
F-41	INTAKE	-	1 NC	72	72	72	72			
F-42 & 43	INTAKE	-	1 NC	78	60	78	60			
F-13 & 16	INTAKE	-	13 NC	48	60	48	60			

THIS DOCUMENT IS CONFIDENTIAL, AND THE PROPERTY OF JOHNSON CONTROLS, INC. THE INFORMATION DISCLOSED IN THIS DOCUMENT SHALL BE DISCLOSED AND USED ONLY FOR PURPOSES OF ACCOMPLISHING THE PROJECT DISCLOSED ON THIS DOCUMENT.

DRAWING TITLE	COMPANION SYSTEM LAYOUT	FILE: 9
PROJECT	ROANOKE COUNTY WATER TREATMENT FACILITY	
JOHNSON CONTROLS Systems & Services Division	JOHNSON CONTROLS INC 2630 BROADWAY S.W. ROANOKE, VA 24014 703-344-8291	CONTRACT NUMBER 95066-0013 DRAWING NUMBER 14 OF 14