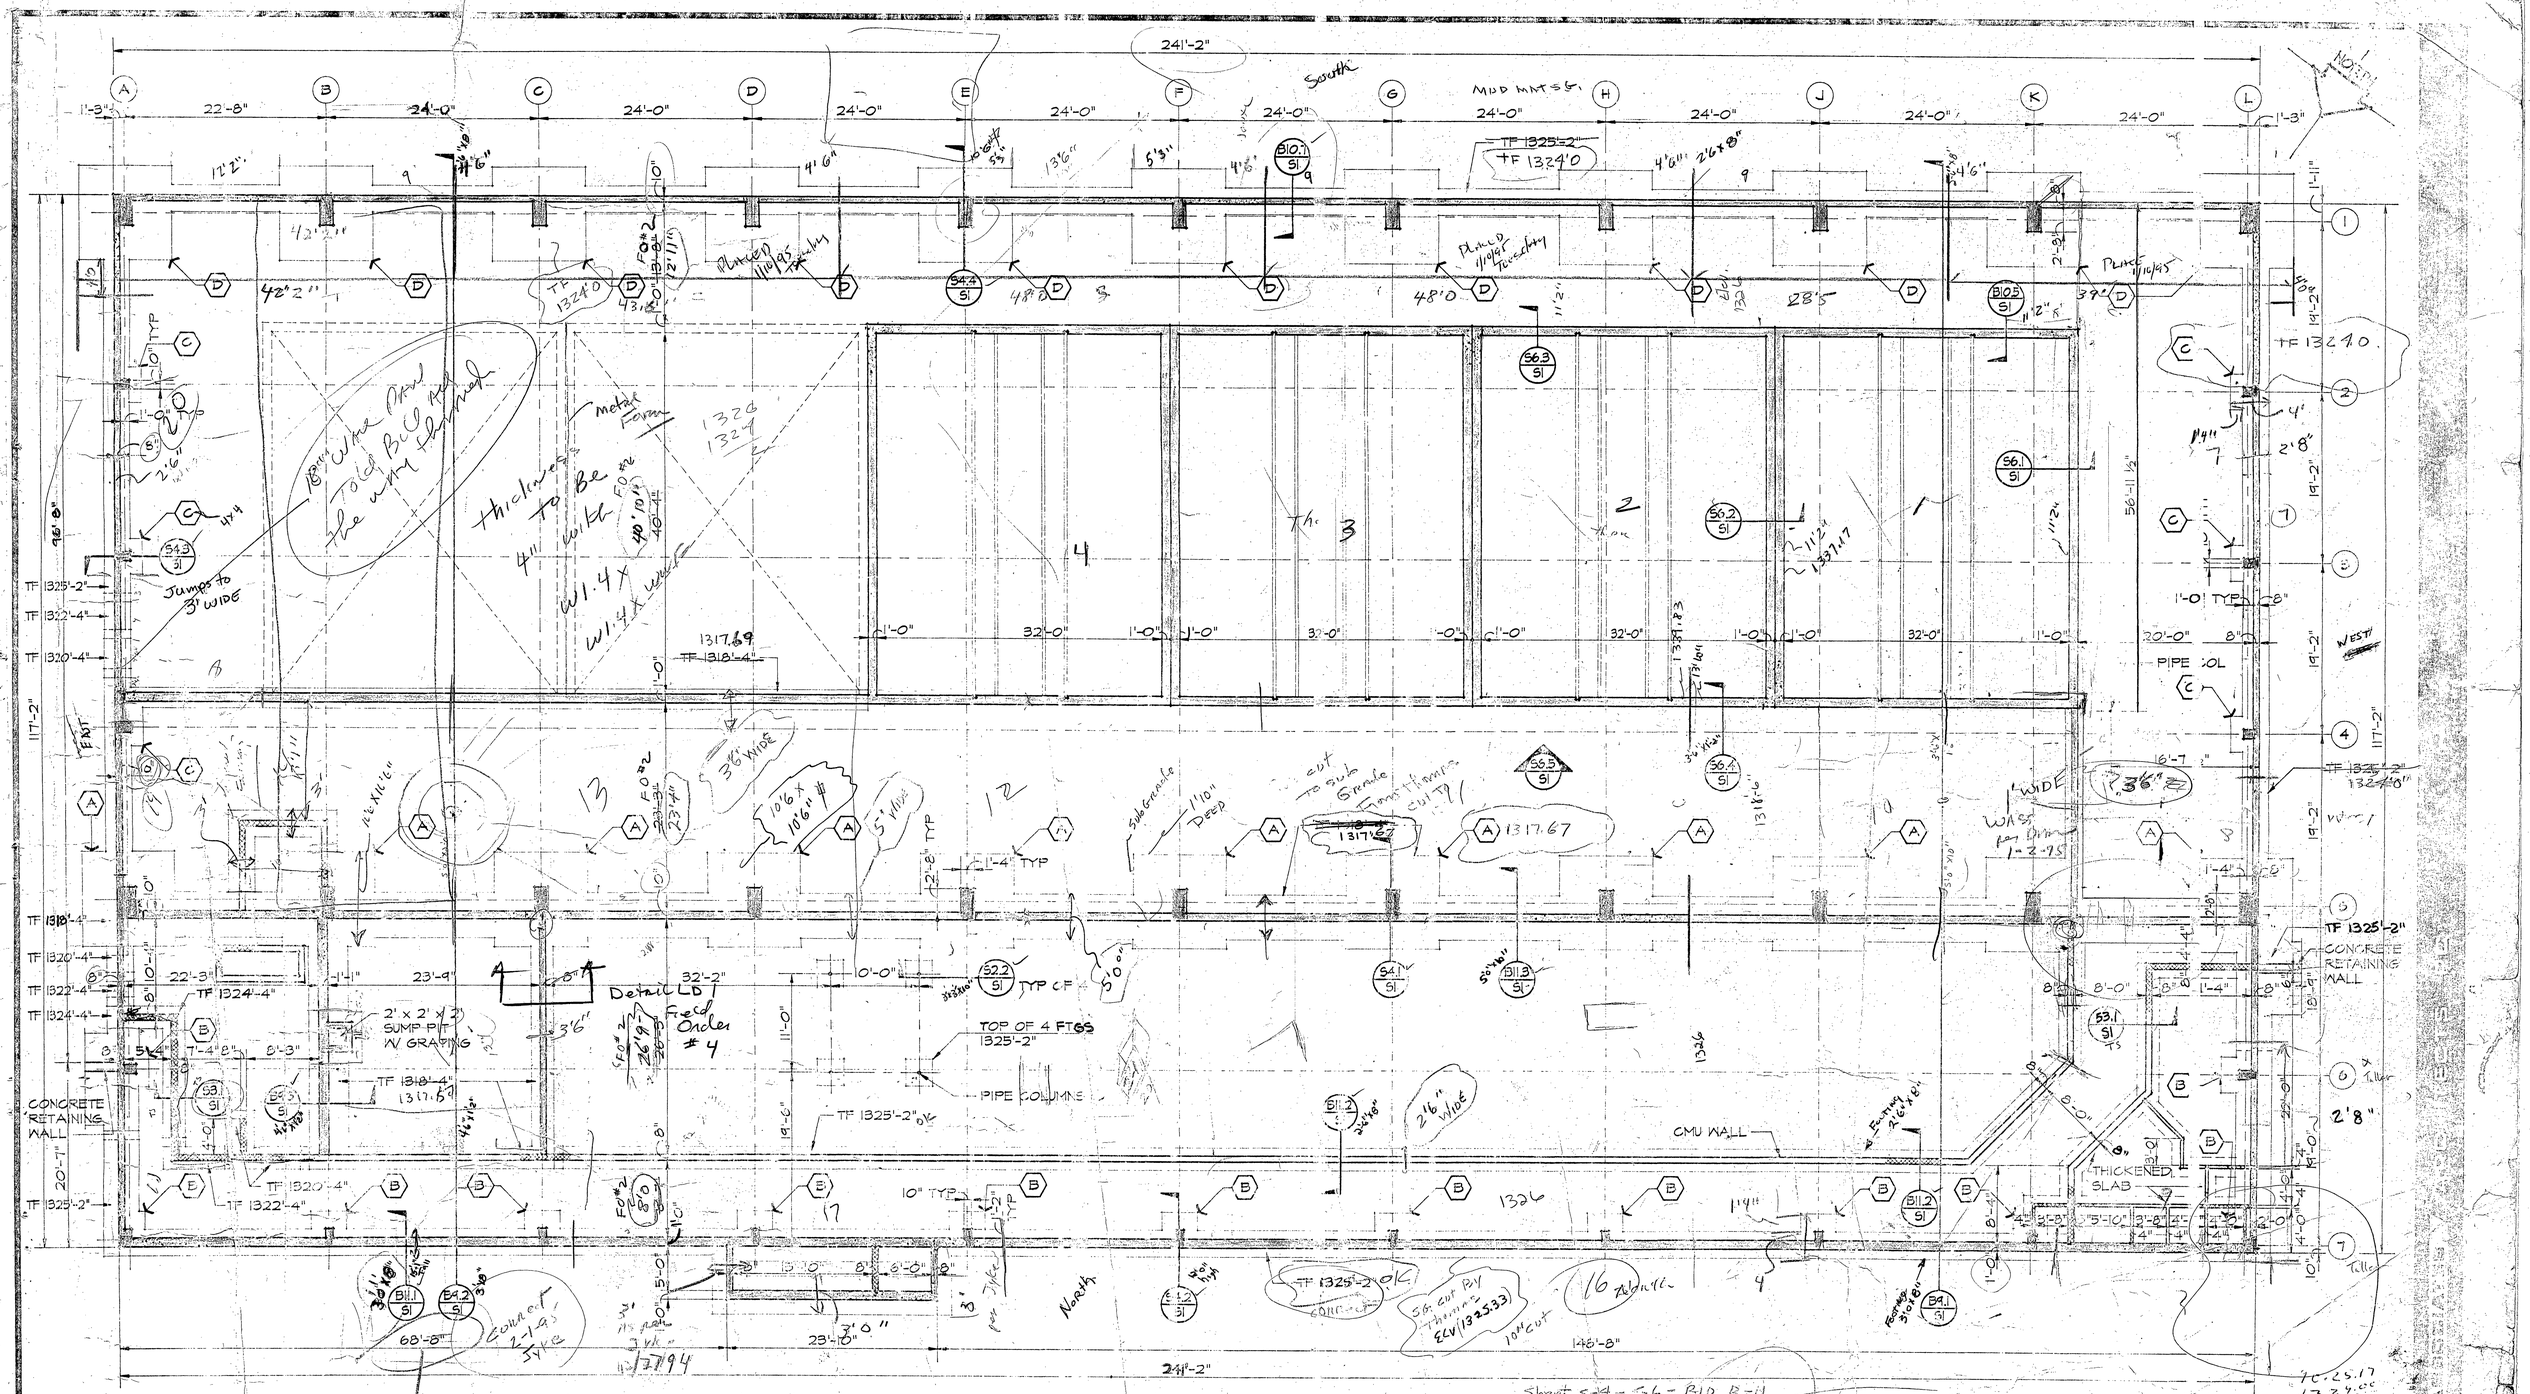

FOOTING AND FOUNDATION PLAN - TREATMENT BUILDING

SCALE 1/8" = 1'-0"

REMARKS

① DIMENSION CLARIFICATION - FROM OUTSIDE OF THE NORTHEAST COTHOL TO EQUIPMENT ROOM 107 IS 68'-8"

ROANOKE COUNTY WATER TREATMENT FACILITY

COMMONWEALTH OF VIRGINIA
RICHARD JONES, JR.
6957

FOOTING AND FOUNDATION PLAN

PROJECT ASSISTANT: FLJ JR

COMMISSION NUMBER: 1815

DRAWN BY:

DATE: 22 SEPT 1994

22 SEPT 1994

S1