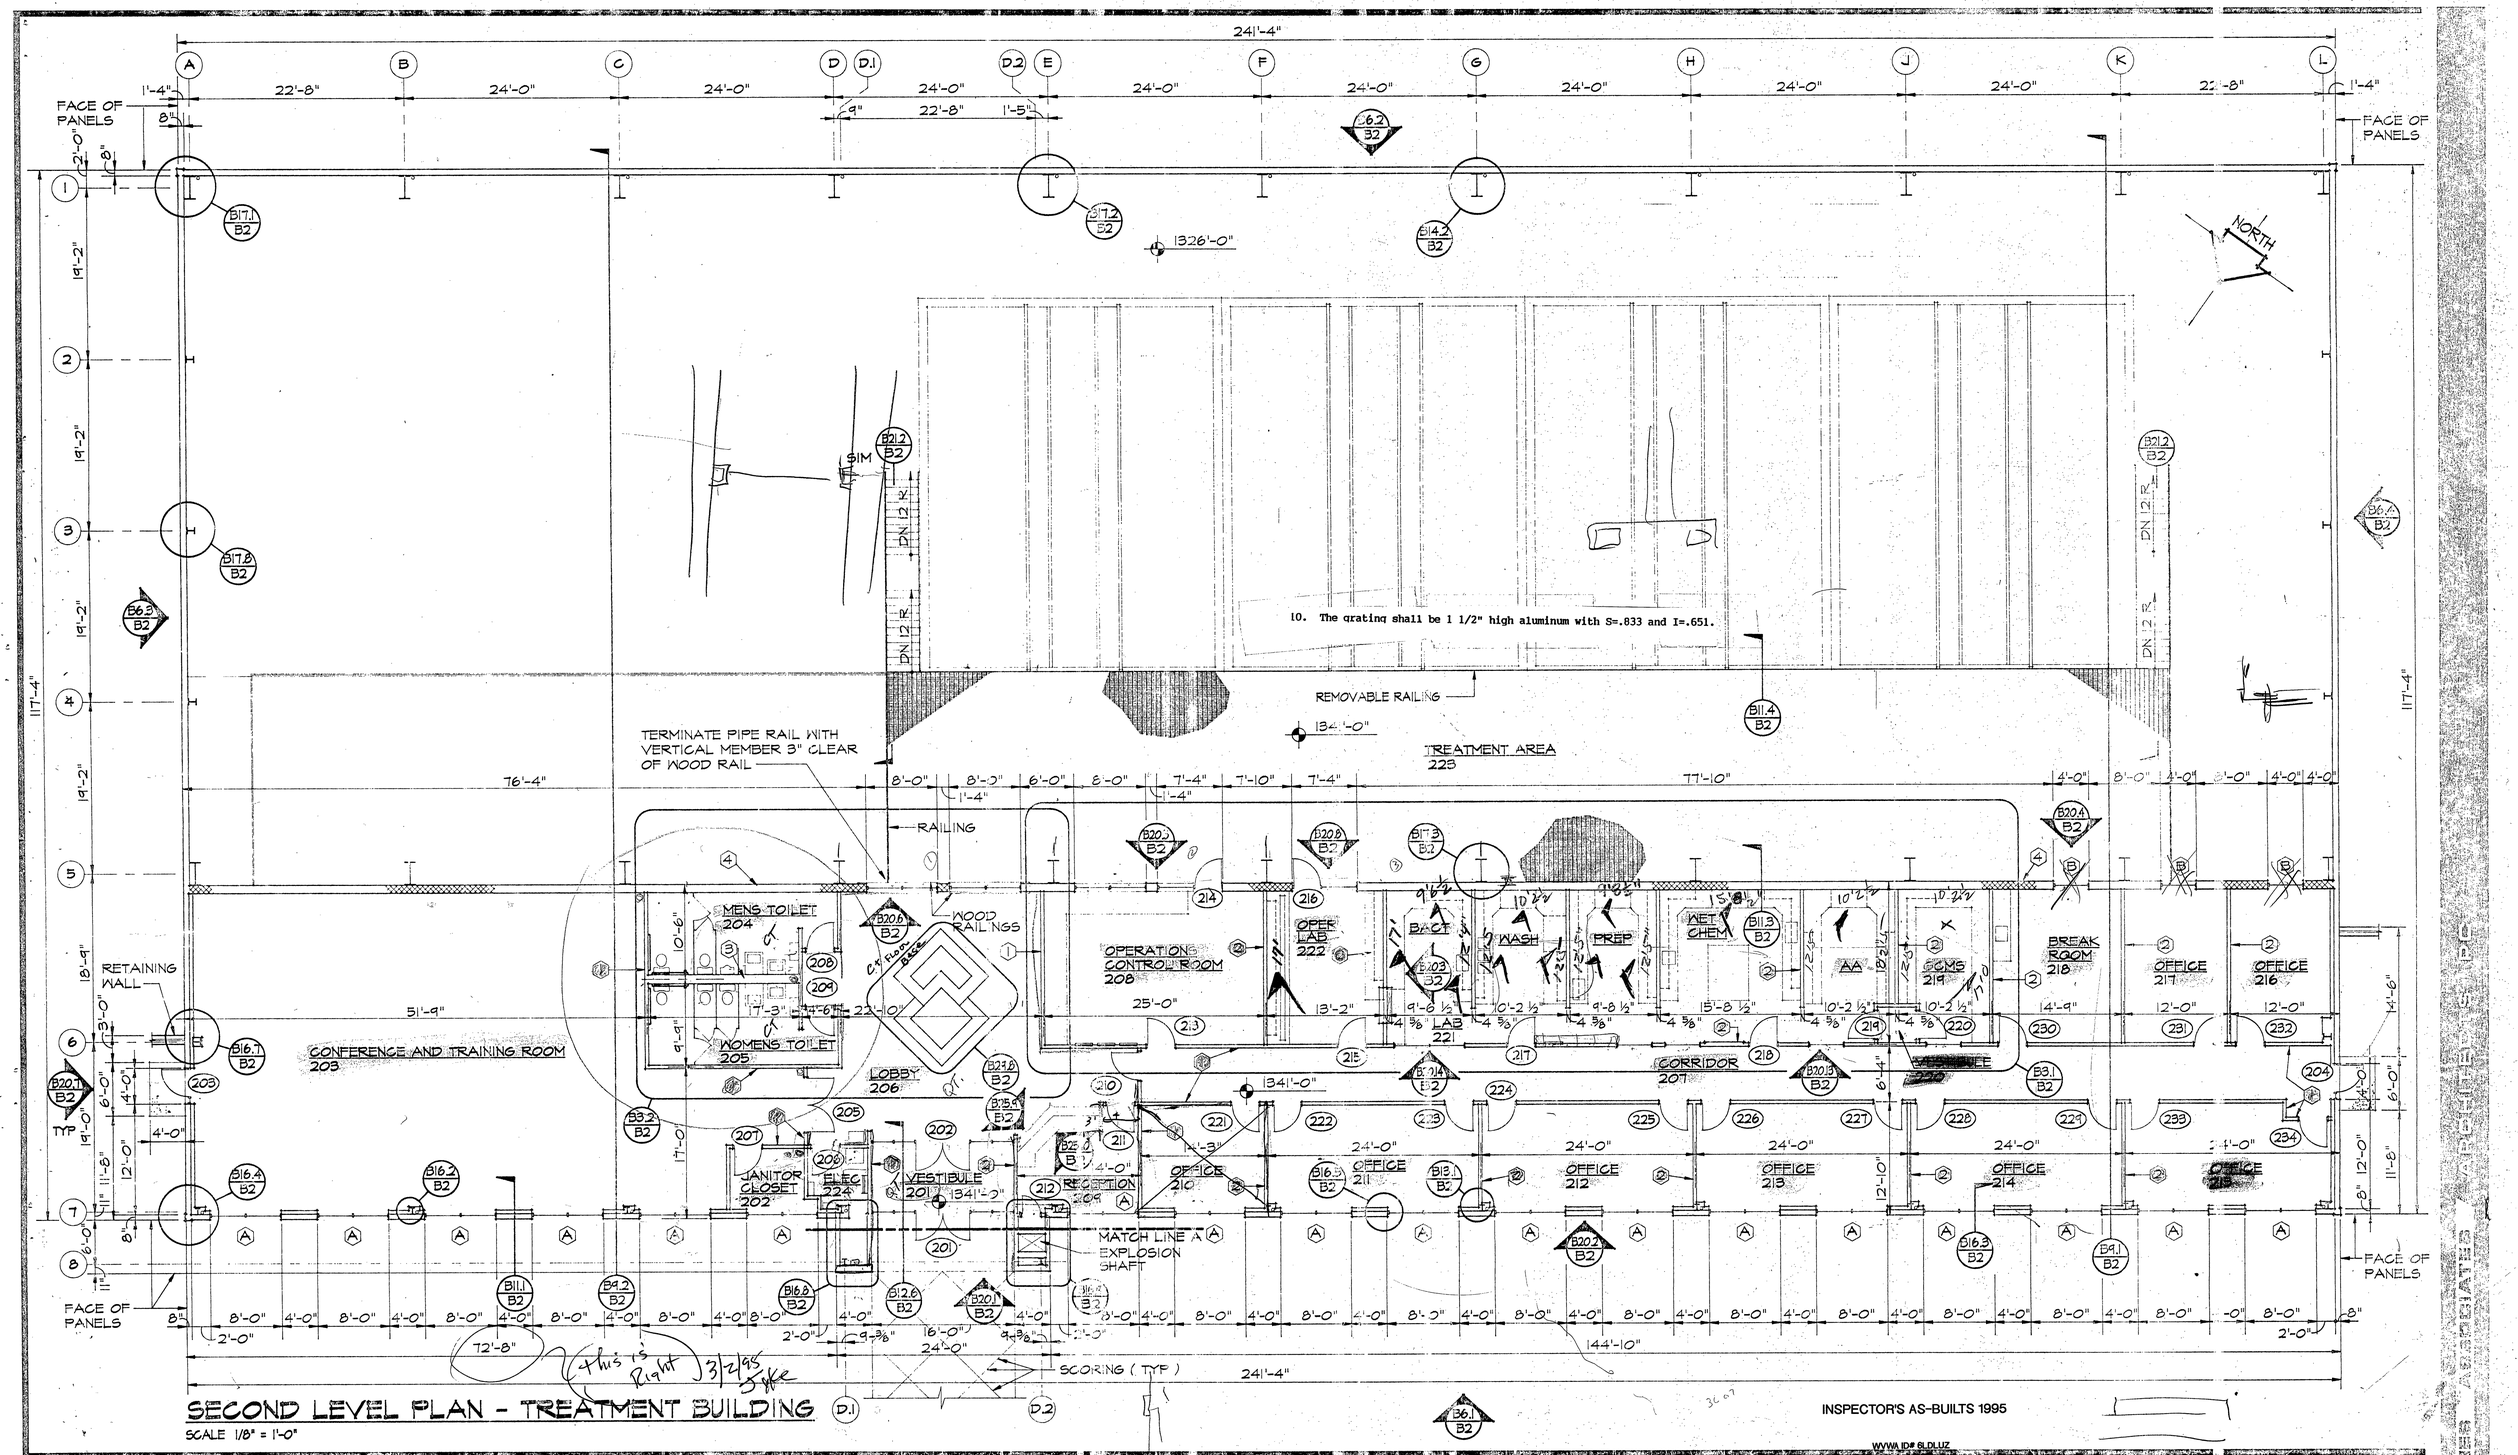

SECOND LEVEL PLAN - TREATMENT BUILDING

SCALE 1/8" = 1'-0"

INSPECTOR'S AS-BUILTS 1995

WVWA ID# SLDLUZ

ROANOKE COUNTY WATER TREATMENT FACILITY

COMMONWEALTH OF VIRGINIA
RICHARD L. JONES, JR.
5957
ARCHITECT

SECOND LEVEL PLAN - TREATMENT BLDG

PROJECT ARCHITECT RLJ JR	COMMISSION NUMBER 1913
TECHNICIANS RWT	DATE 22 SEPT 1994

B2