


## SECTION

SCALE 1" = 1'-0"

B9.3 / B1 B9

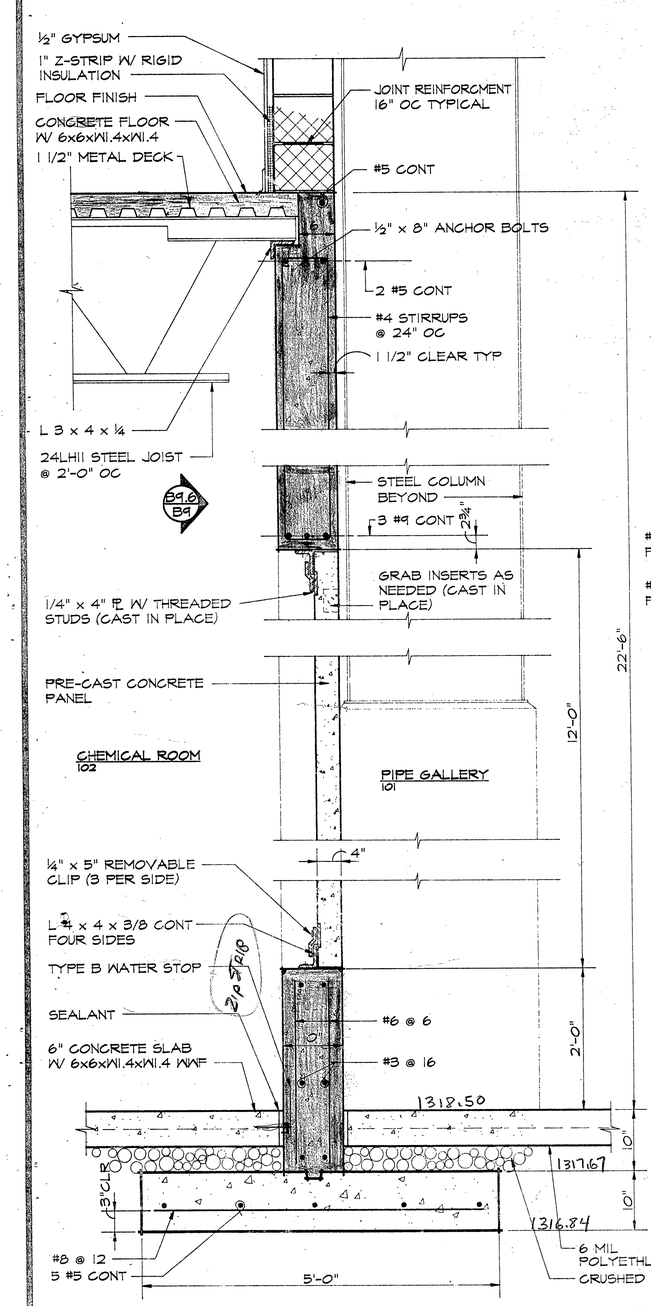


## SECTION

SCALE 1 1/2" = 1'-0"

TYPICAL EDGE FLASHING B9.4 / B12 B28 B29

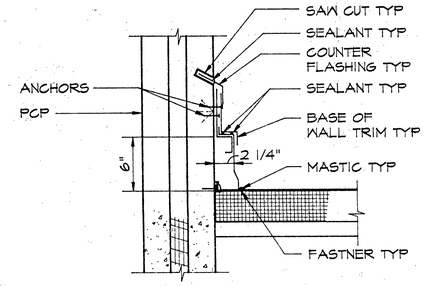


## ELEVATION OF CONC BEAM

SCALE 1/2" = 1'-0"

B9.6 / B9

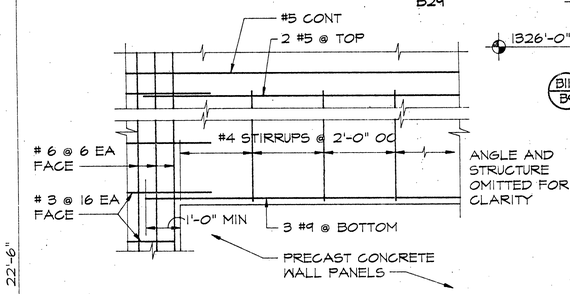


## SECTION

SCALE 3/4" = 1'-0"

B9.5 / B1 S1 B9

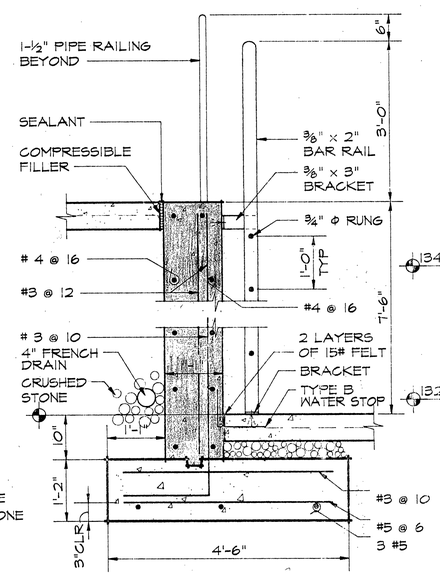


## BUILDING SECTION - TREATMENT BUILDING

SCALE 1/8" = 1'-0"

B9.1 / B1 S1 B2 S5 B28

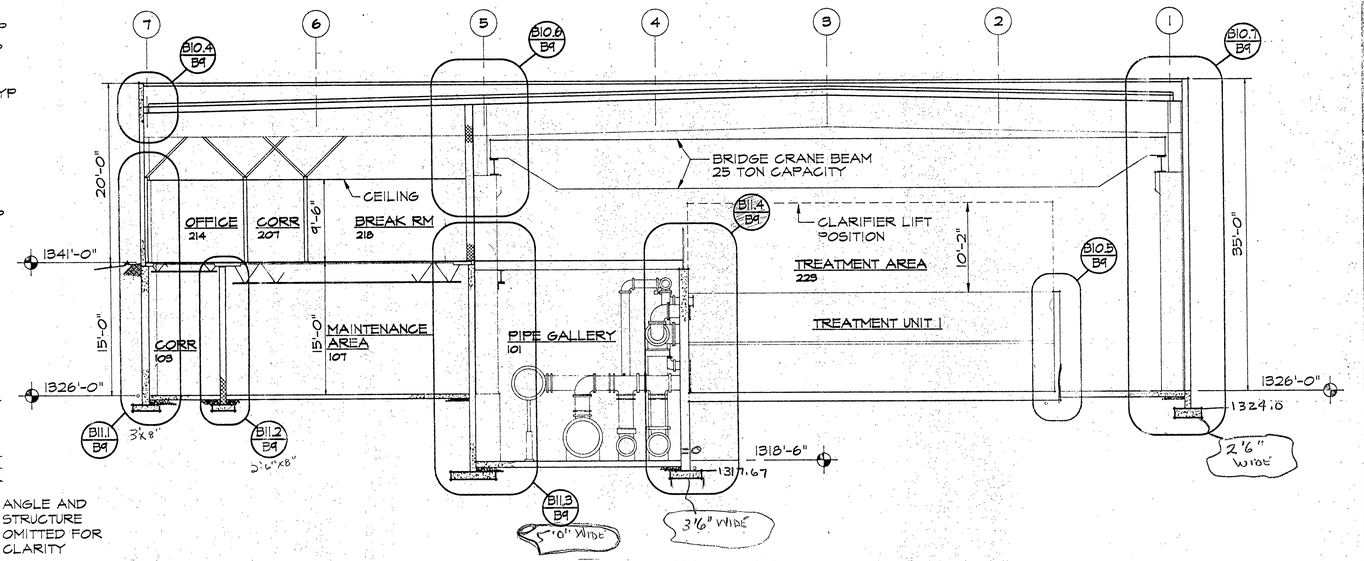


## BUILDING SECTION - TREATMENT BUILDING

SCALE 1/8" = 1'-0"

B9.2 / B1 S1 B2 S5 B28 B6

INSPECTOR'S AS-BUILTS 1995

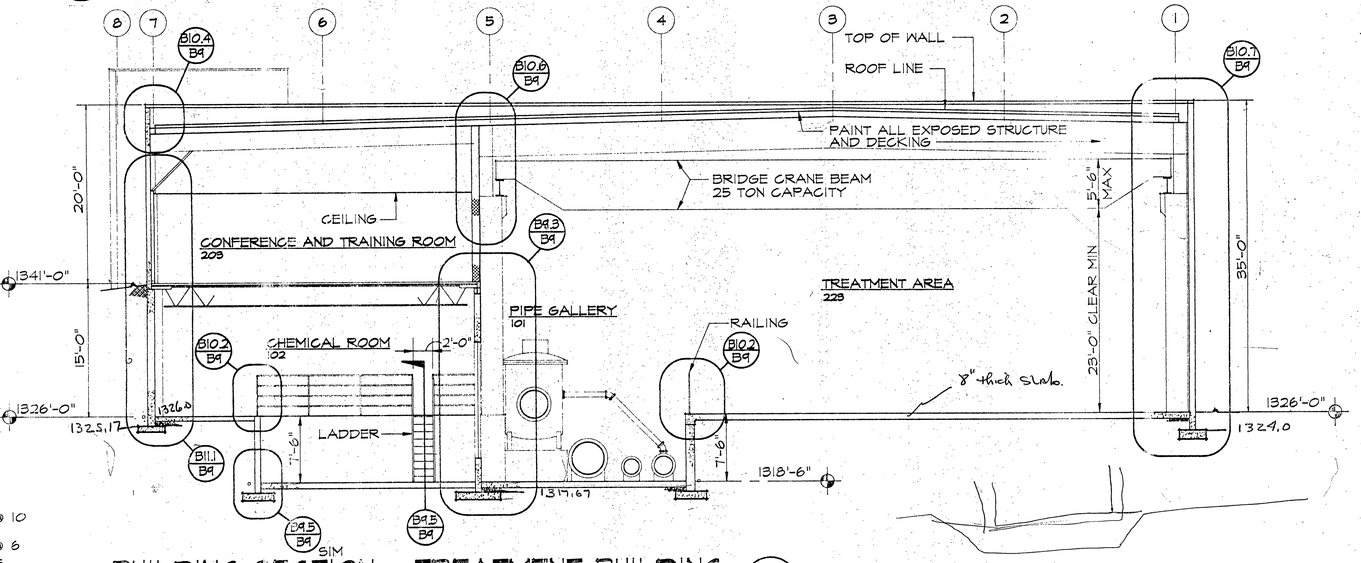WVWA ID# 8LDLUZ

ROANOKE COUNTY WATER TREATMENT FACILITY

COMMONWEALTH OF VIRGINIA
RICHARD L. JONES, JR.
5957
ARCHITECT

BUILDING SECTIONS - TREATMENT

| | |
|---|---|
| PROJECT ARCHITECT: RLJ JR | COMMISSION NUMBER: 1913 |
| TECHNICIANS: RWT | DATE: 22 SEPT 1994 |

B9

RICHARD L. JONES & ASSOCIATES ARCHITECTS