

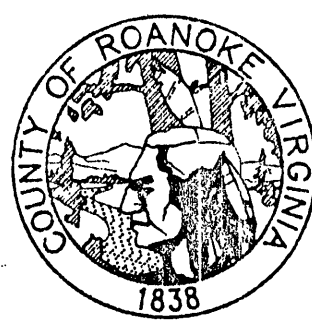
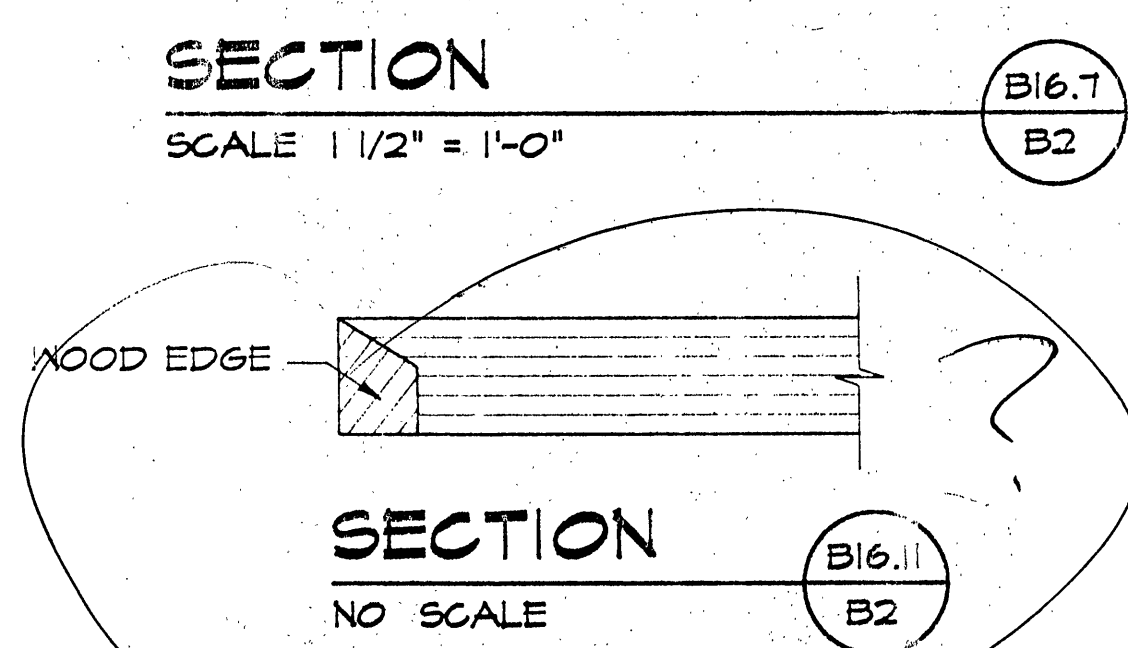
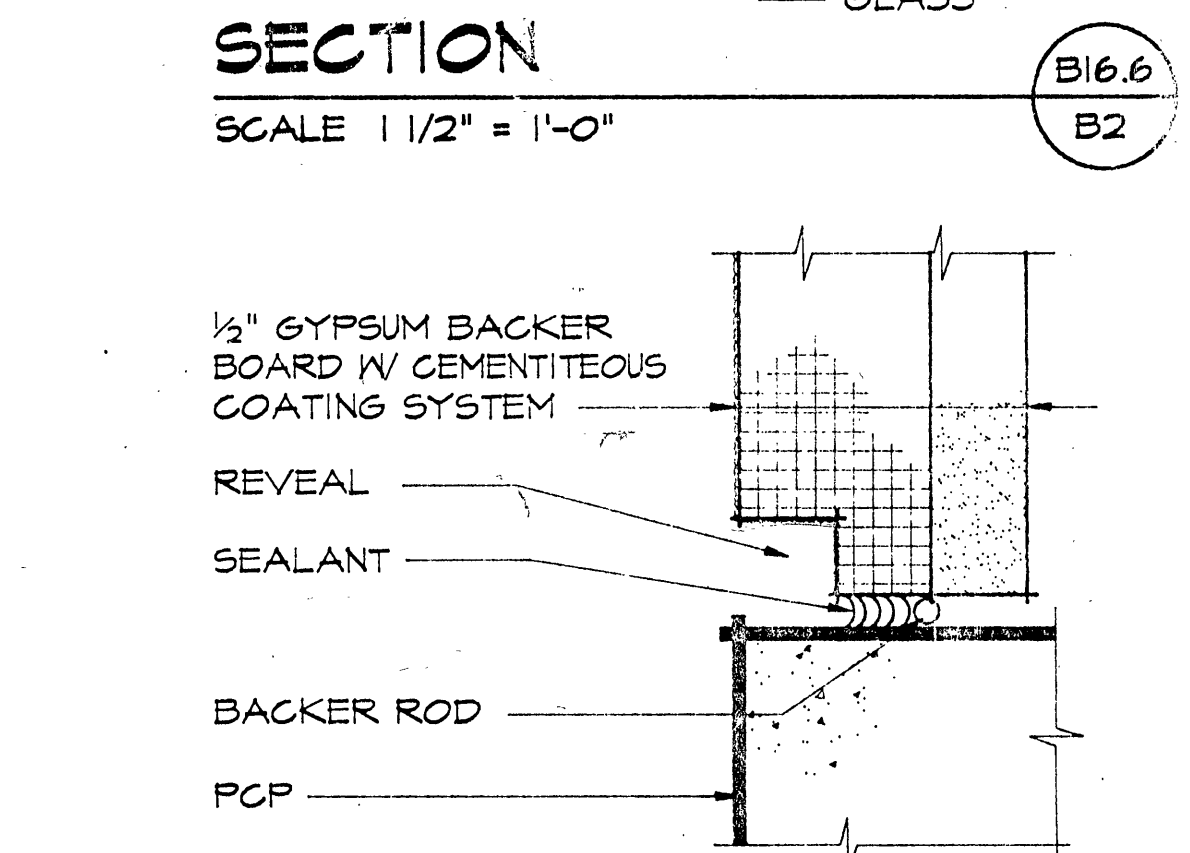
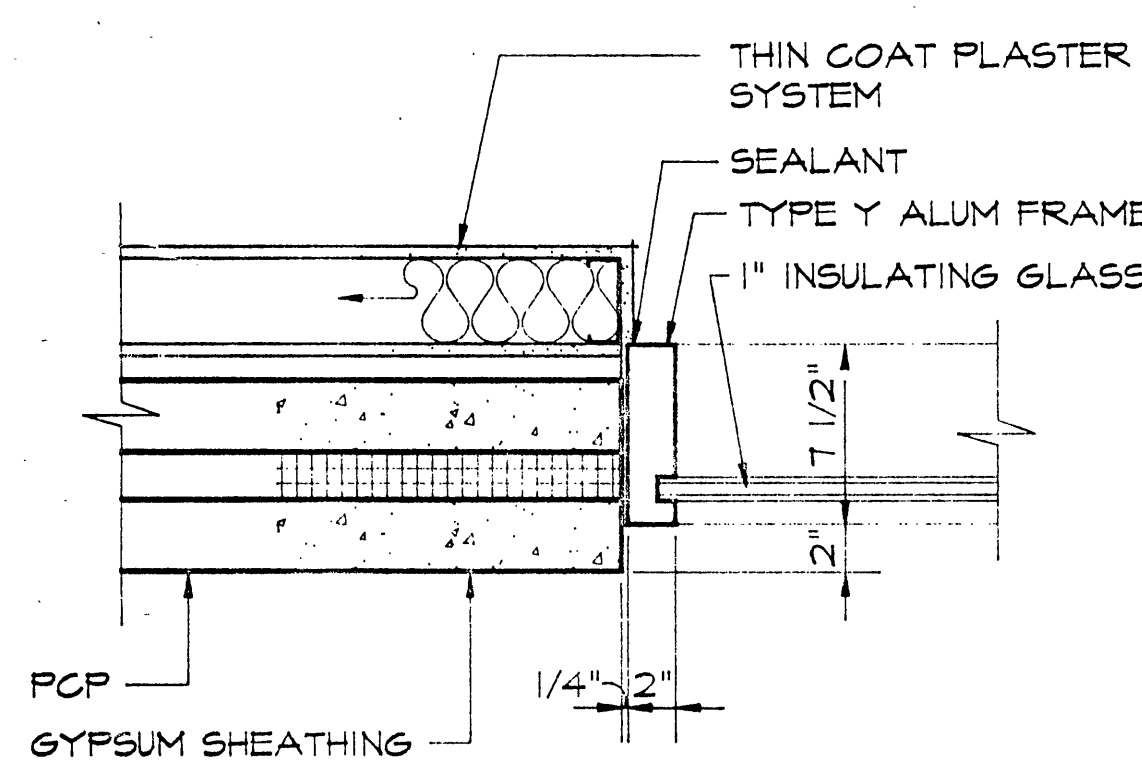
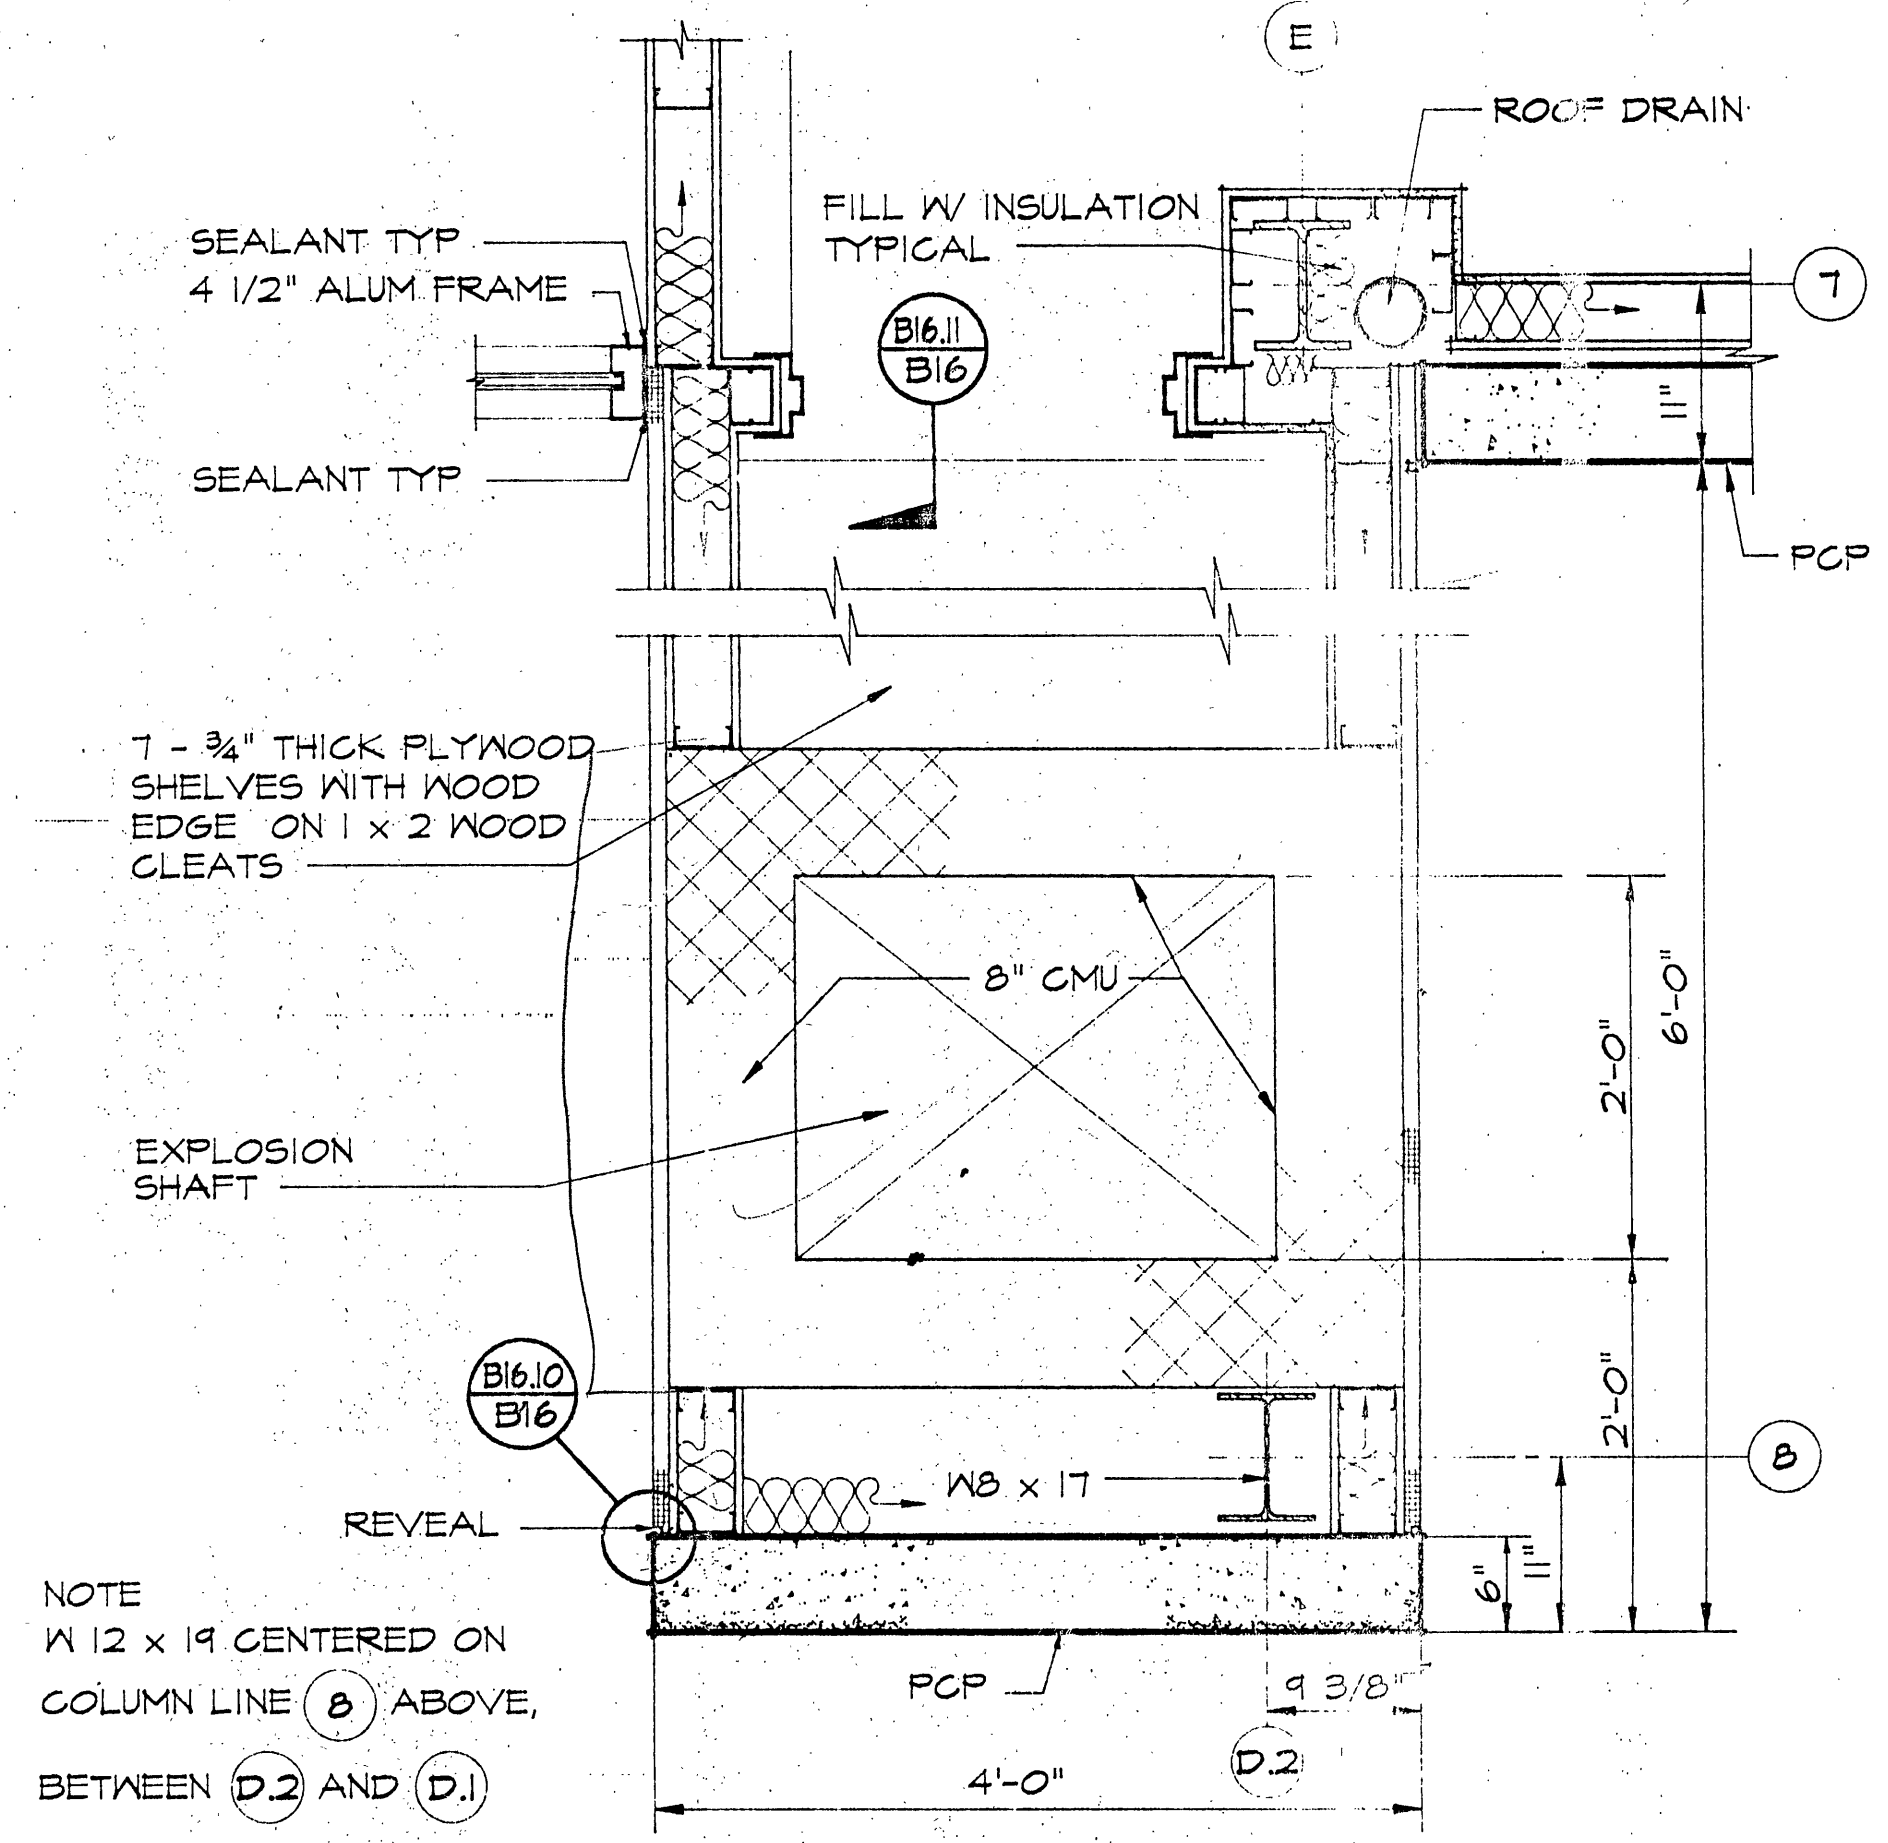
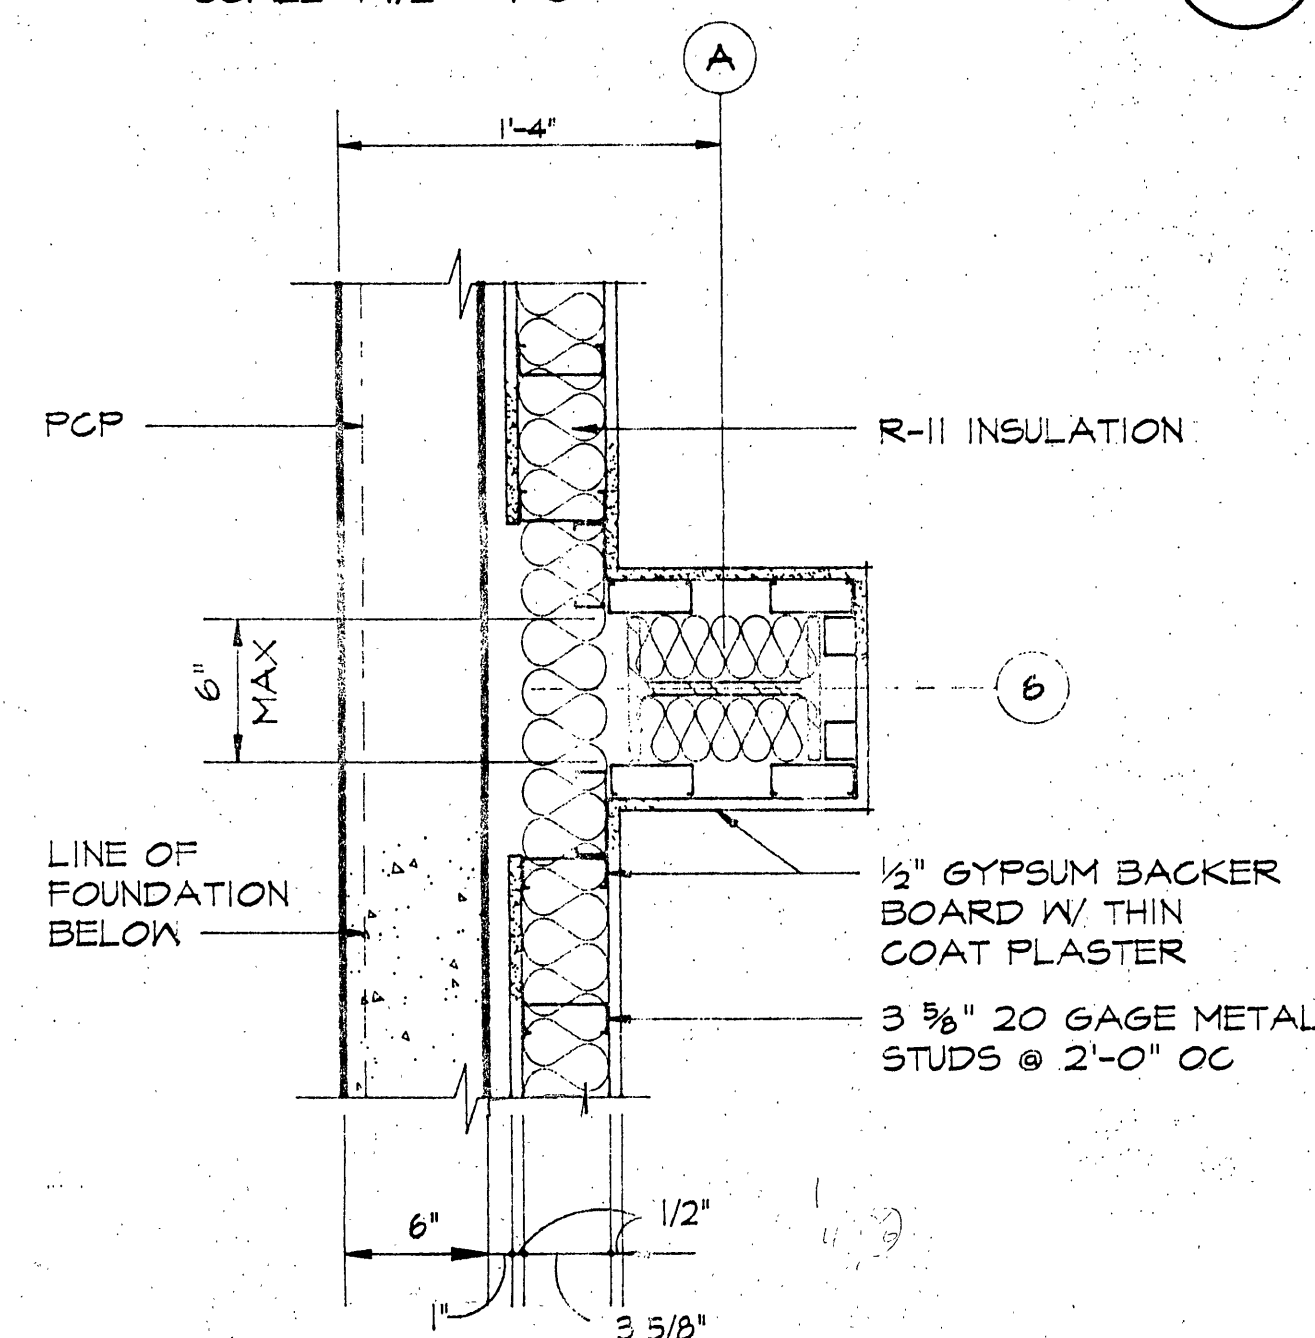
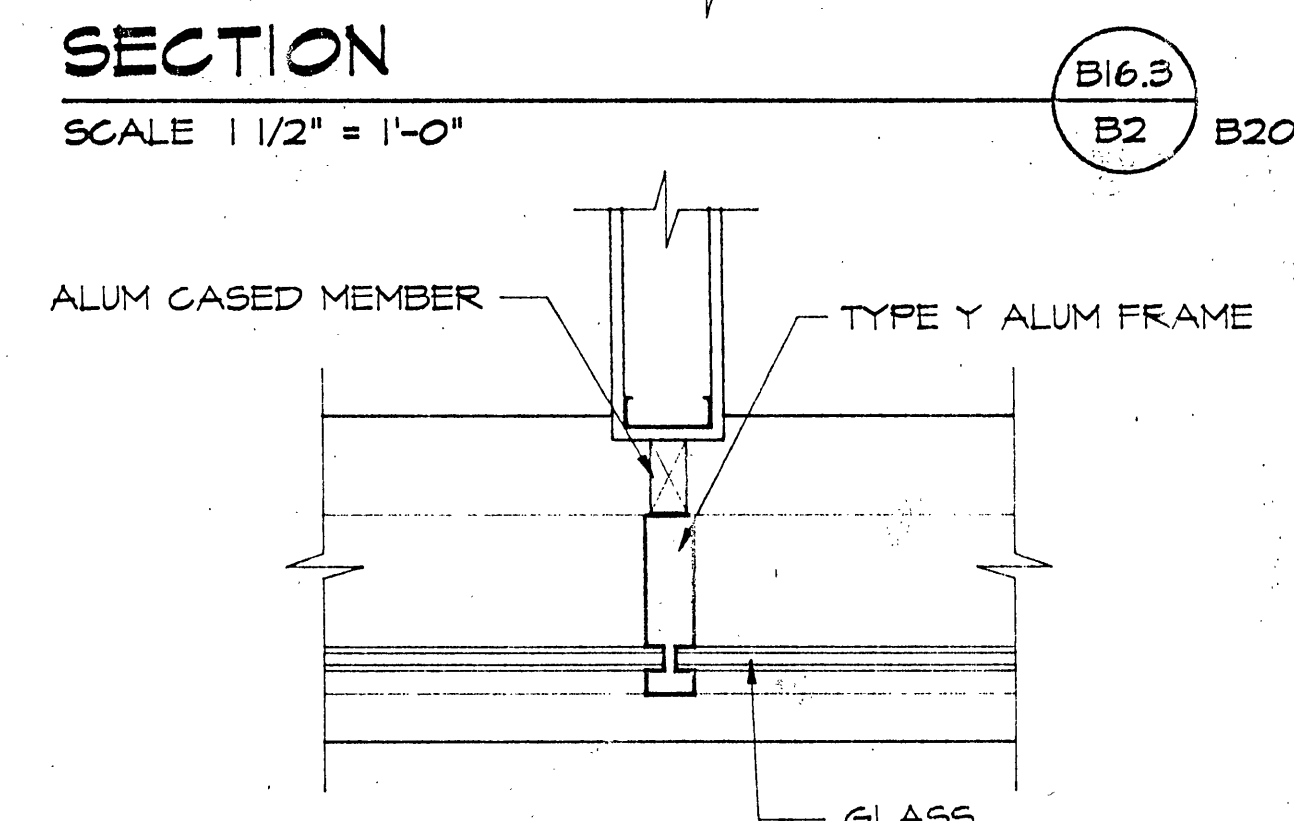
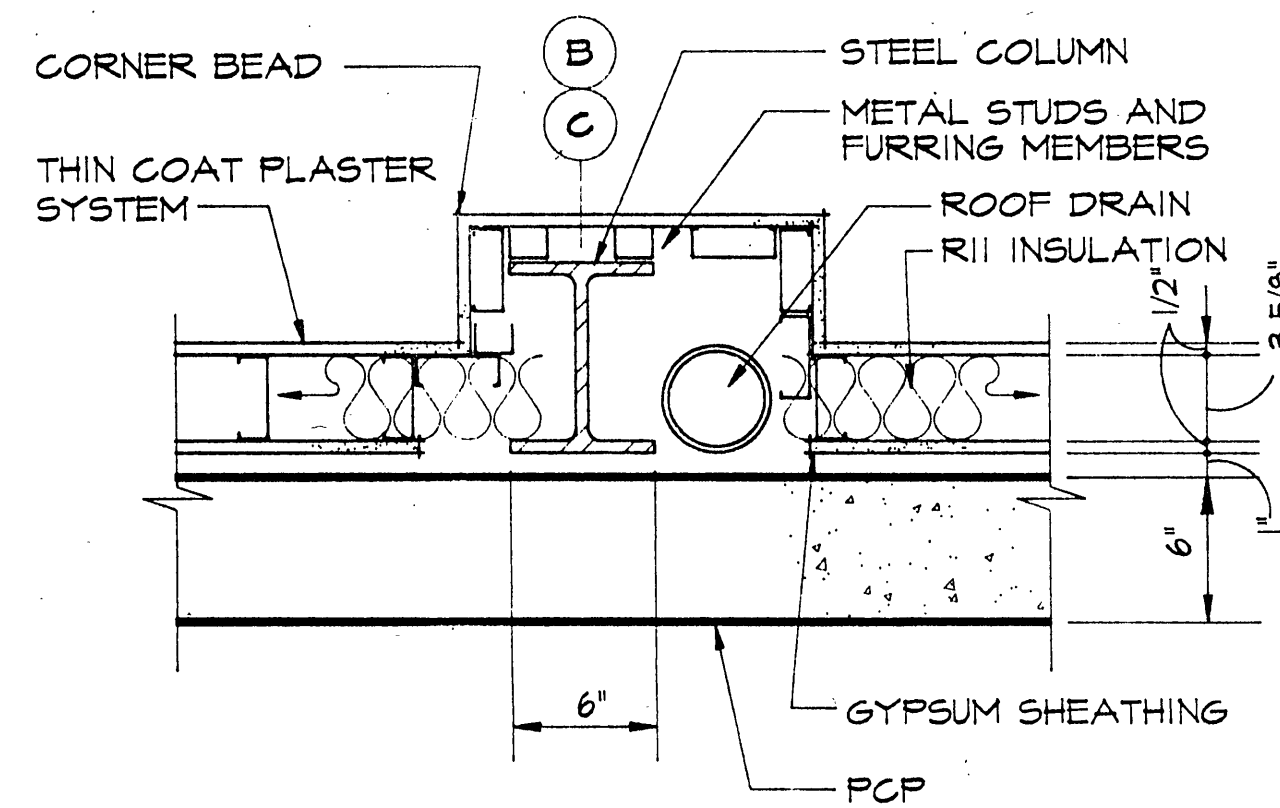
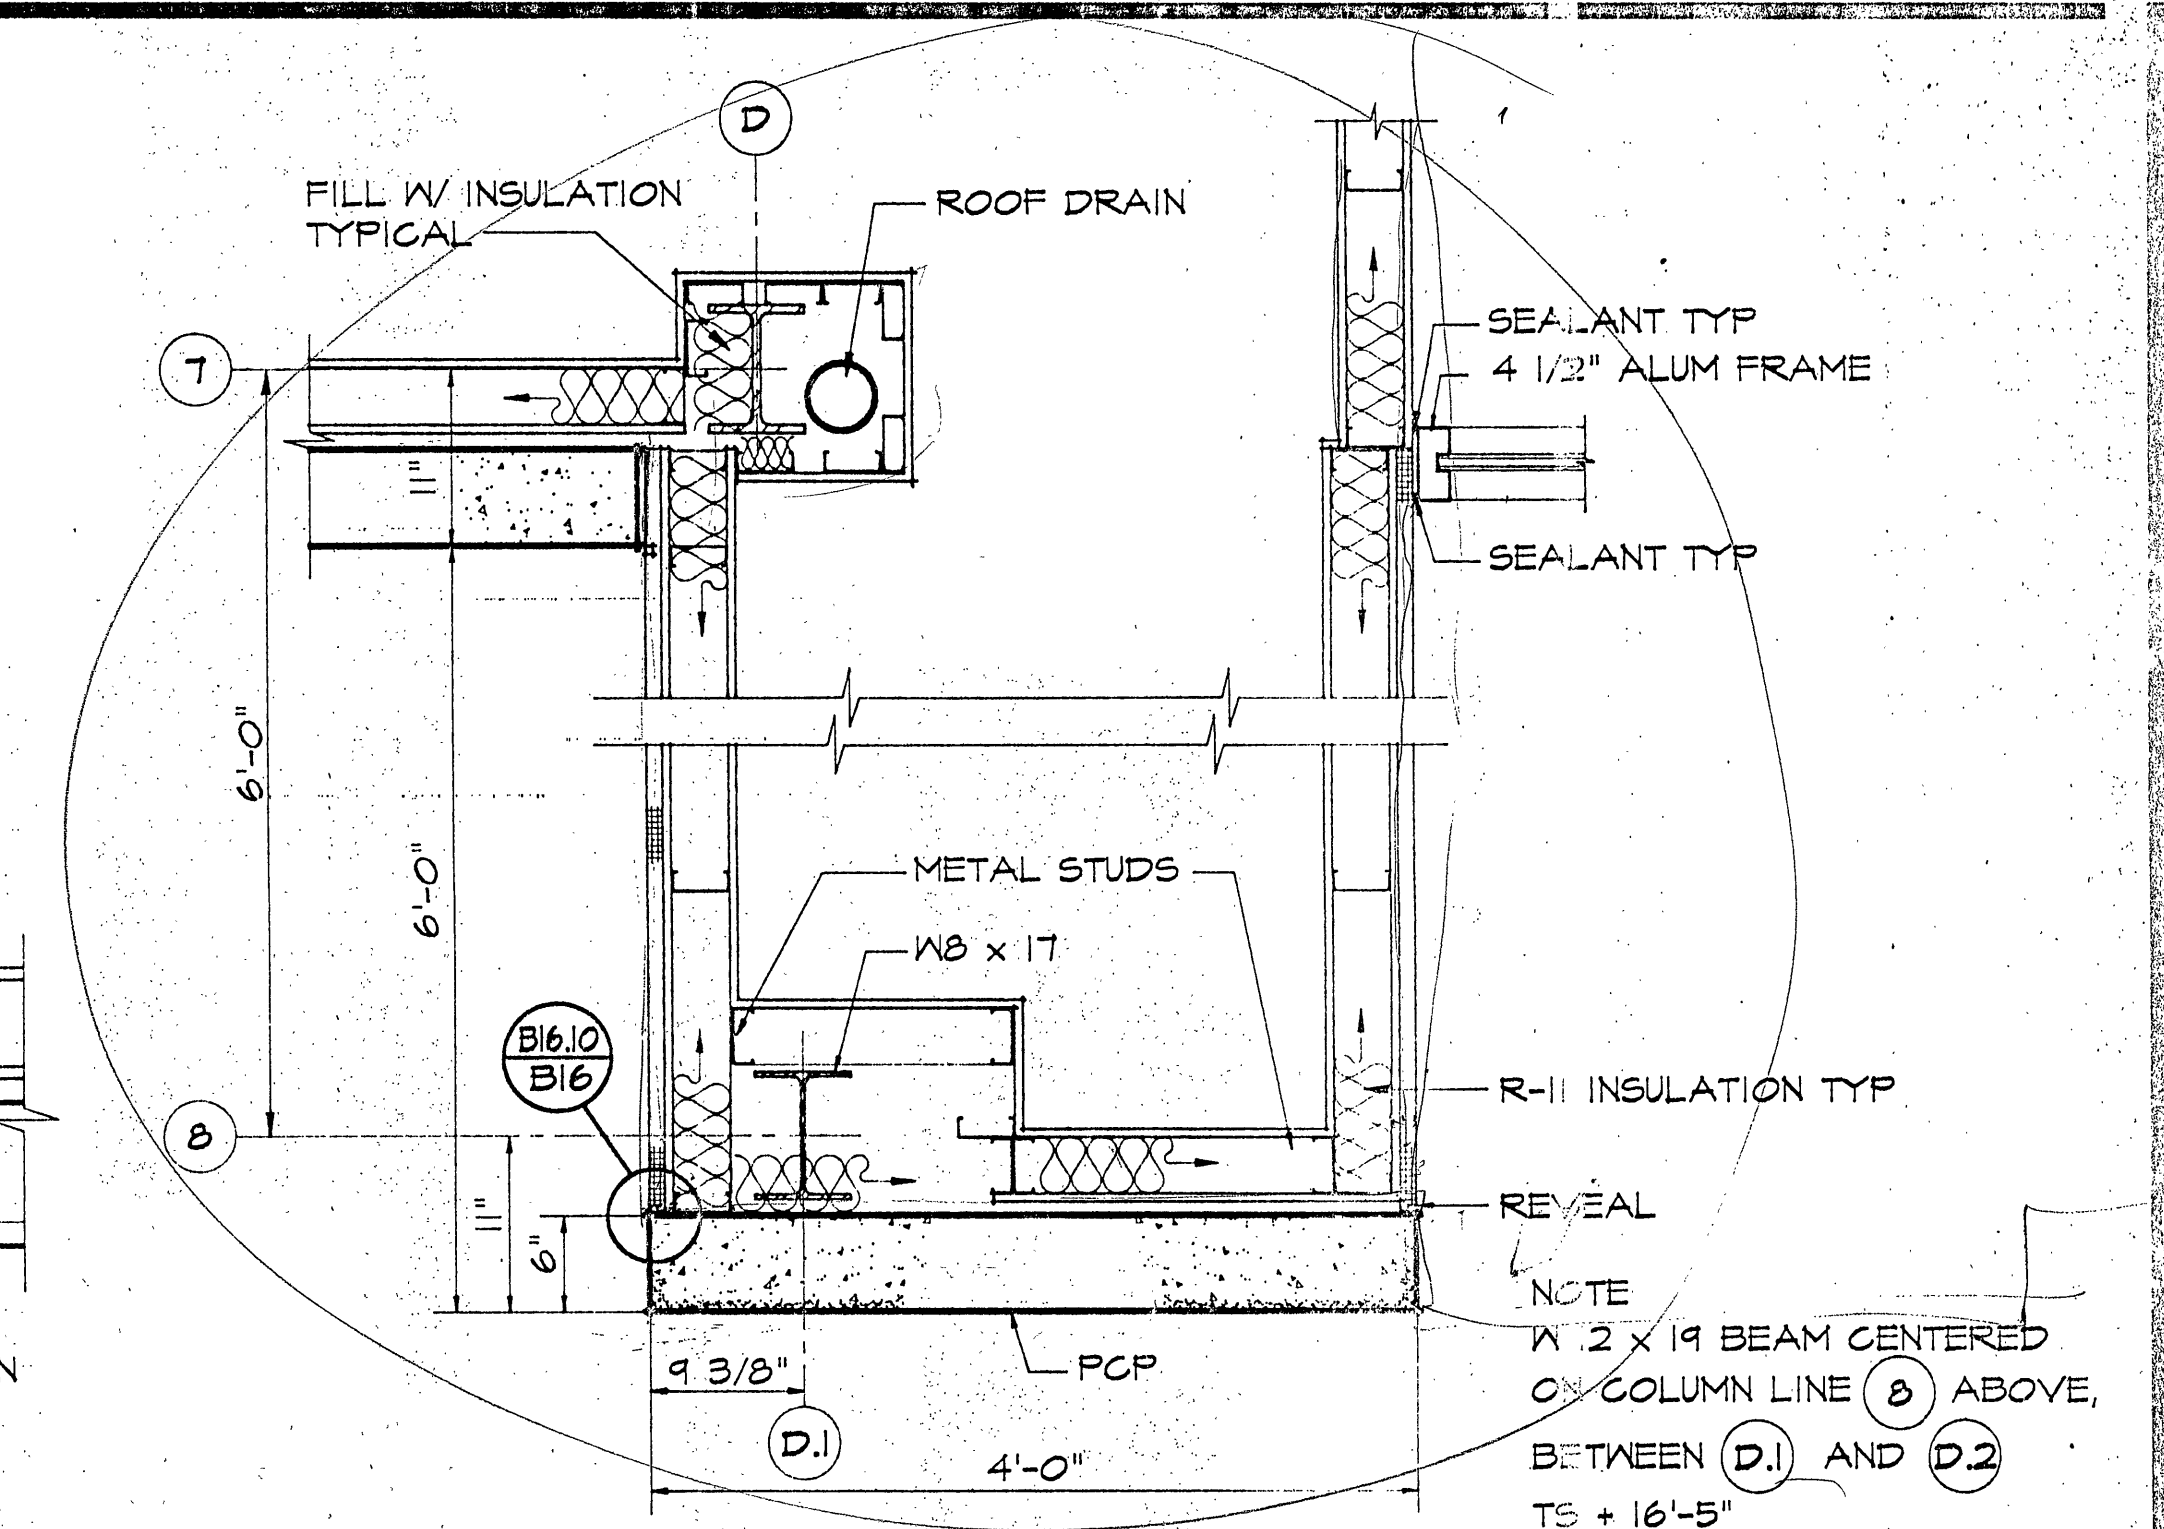
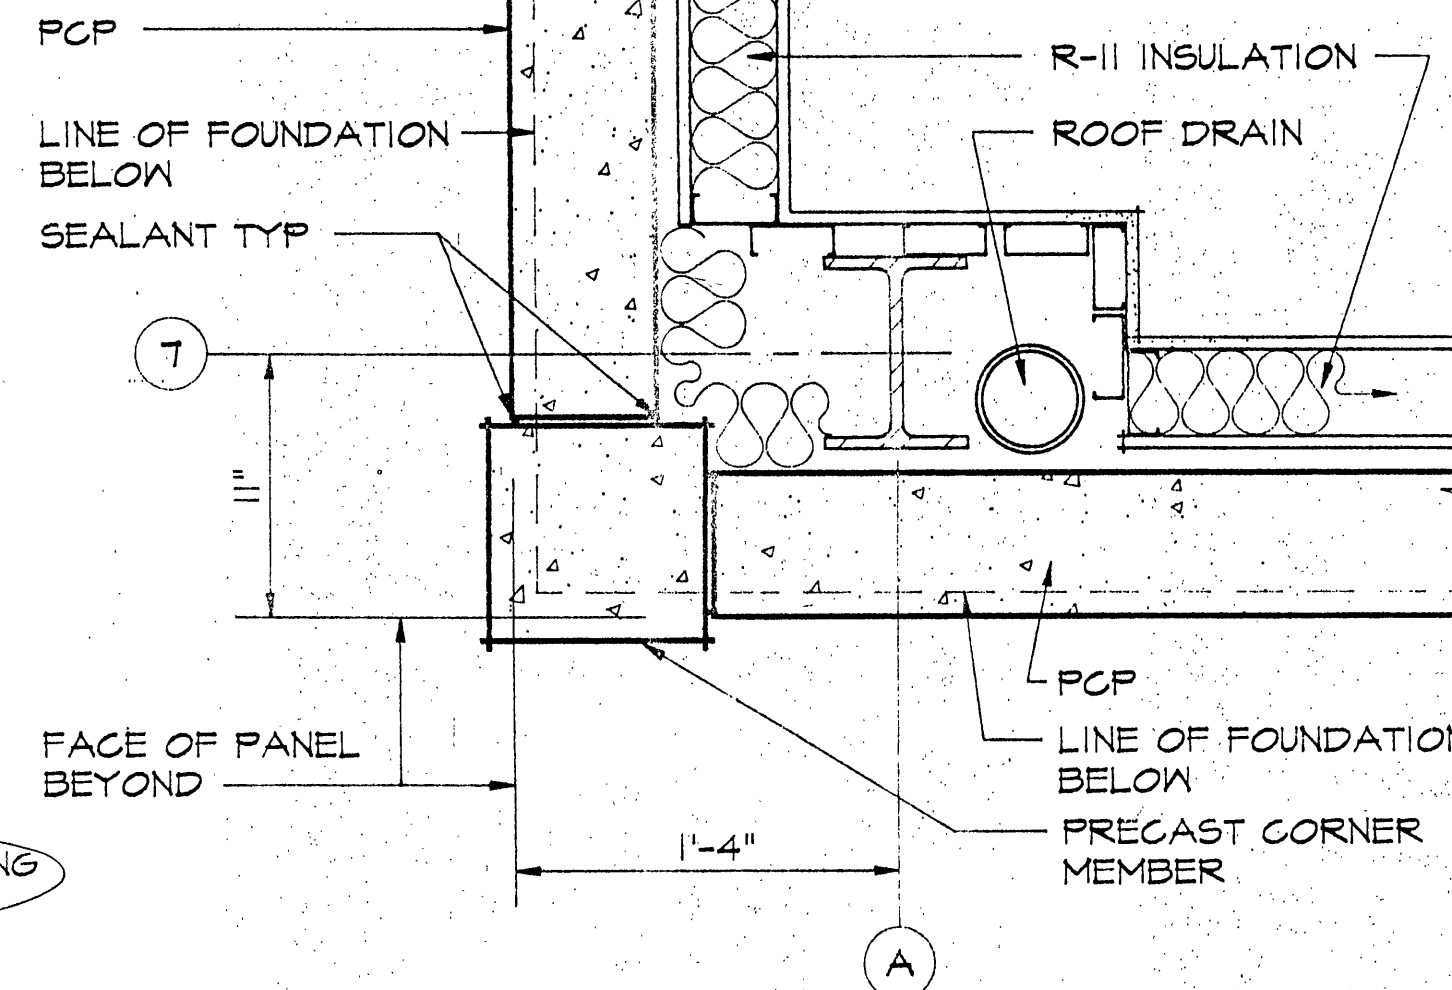
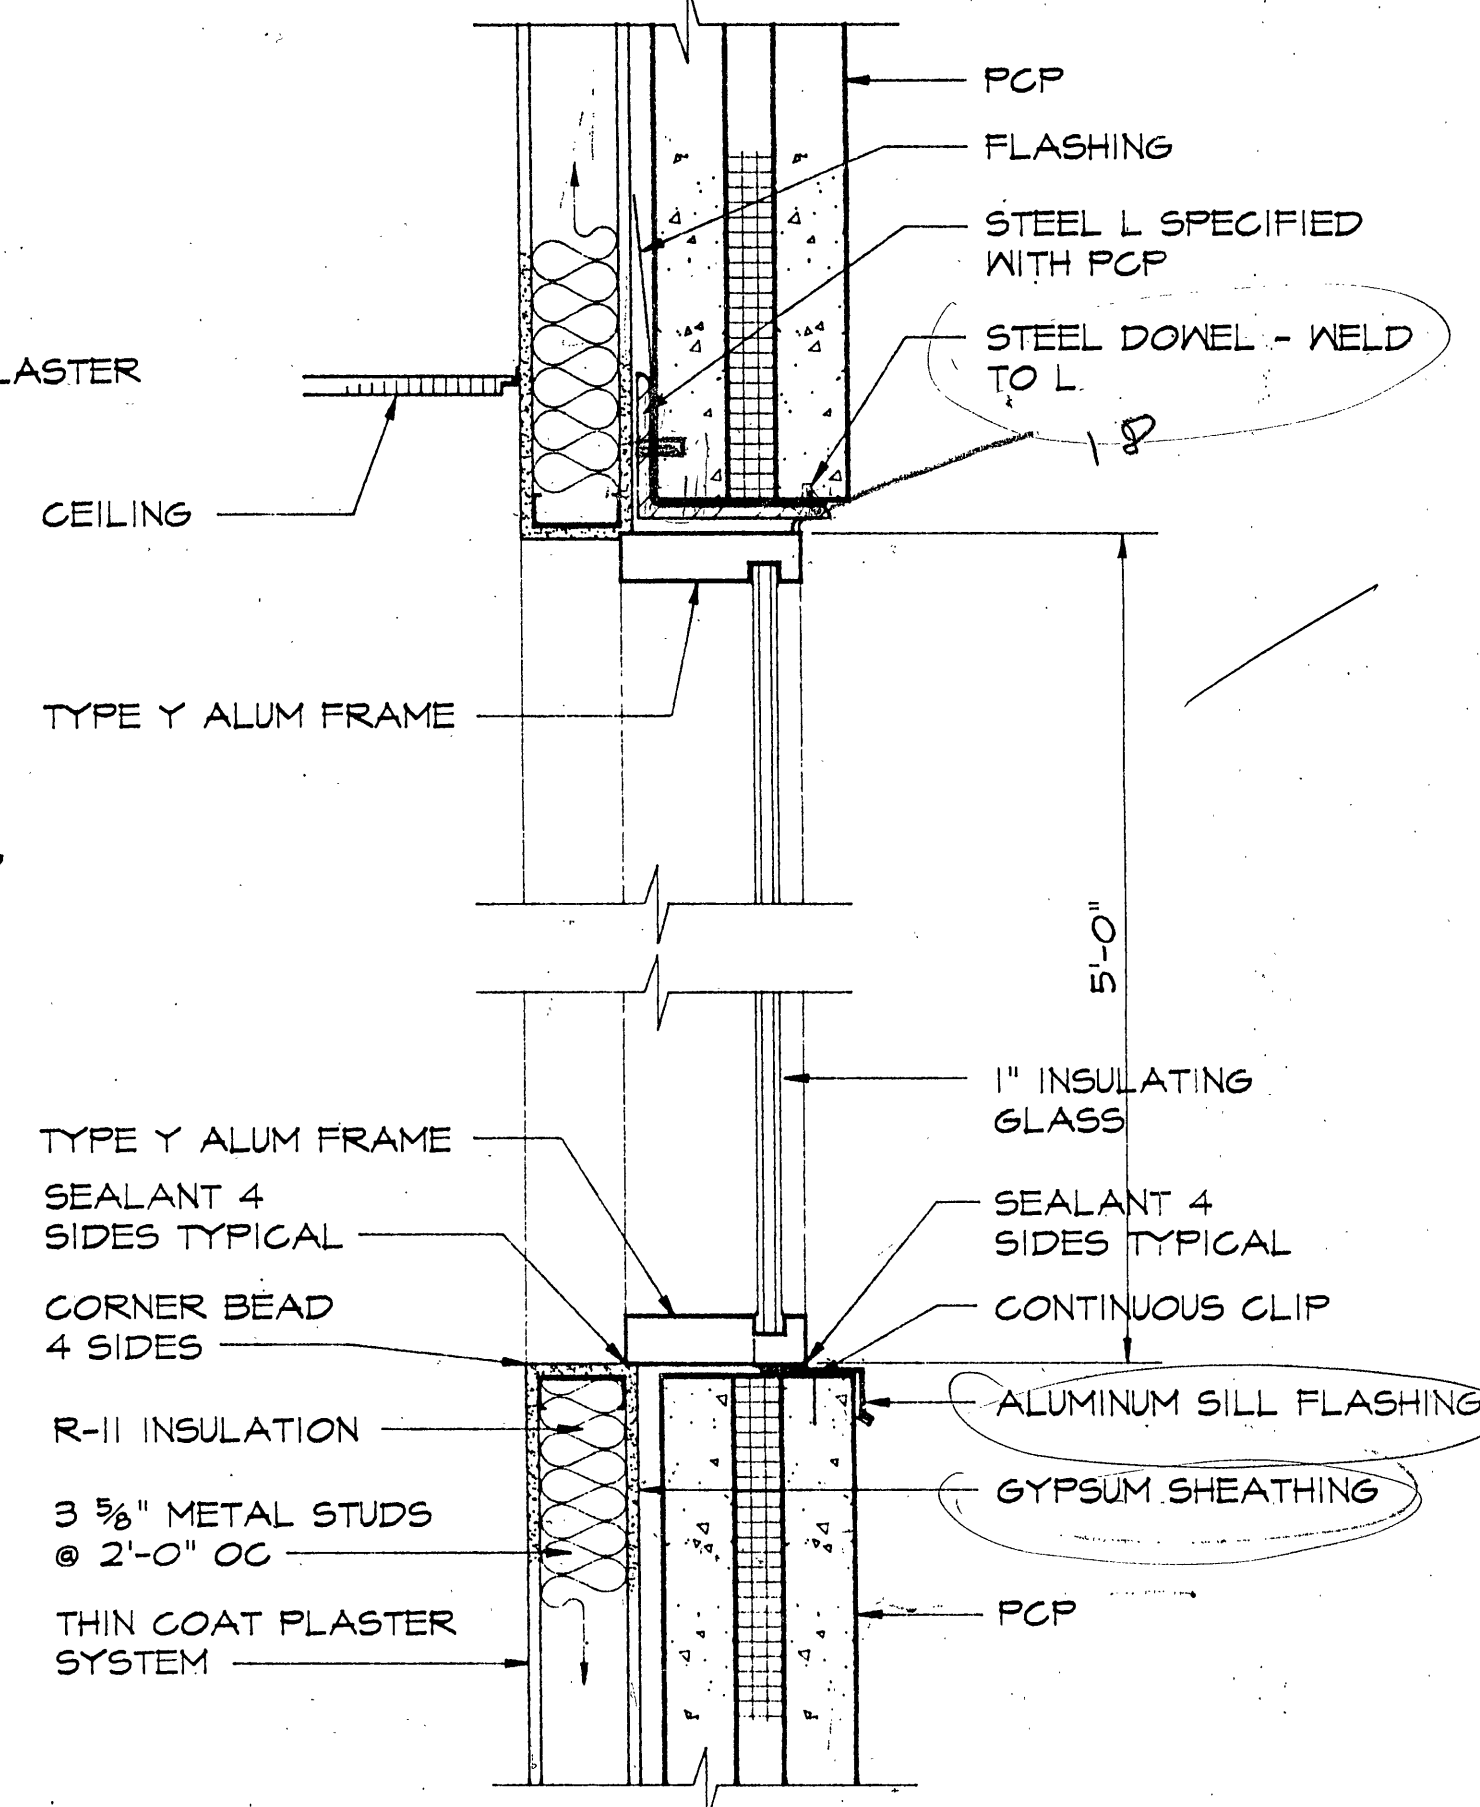


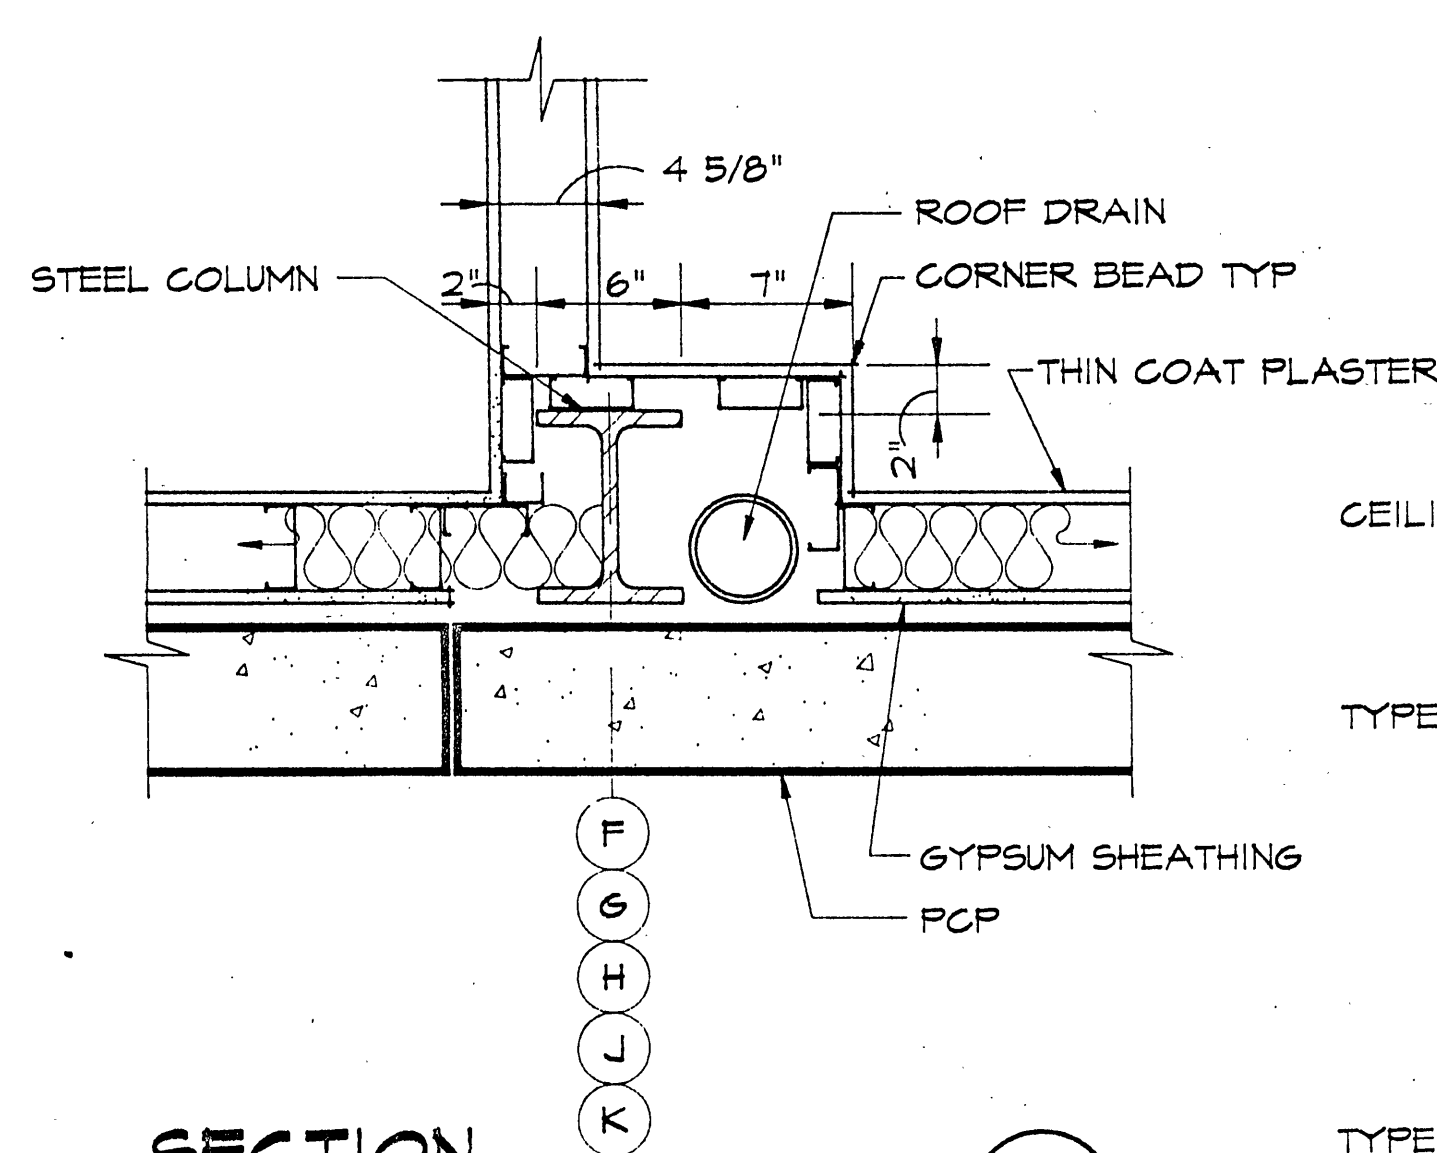

# ROANOKE COUNTY WATER TREATMENT FACILITY

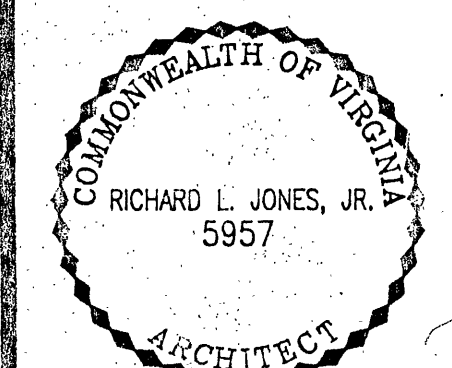

| SECTIONS                 |                           |
|--------------------------|---------------------------|
| PROJECT ARCHITECT<br>RLJ | COMMISSION NUMBER<br>1913 |
| TECHNICIANS<br>RAT       | DATE<br>22 SEPT 1994      |

B16