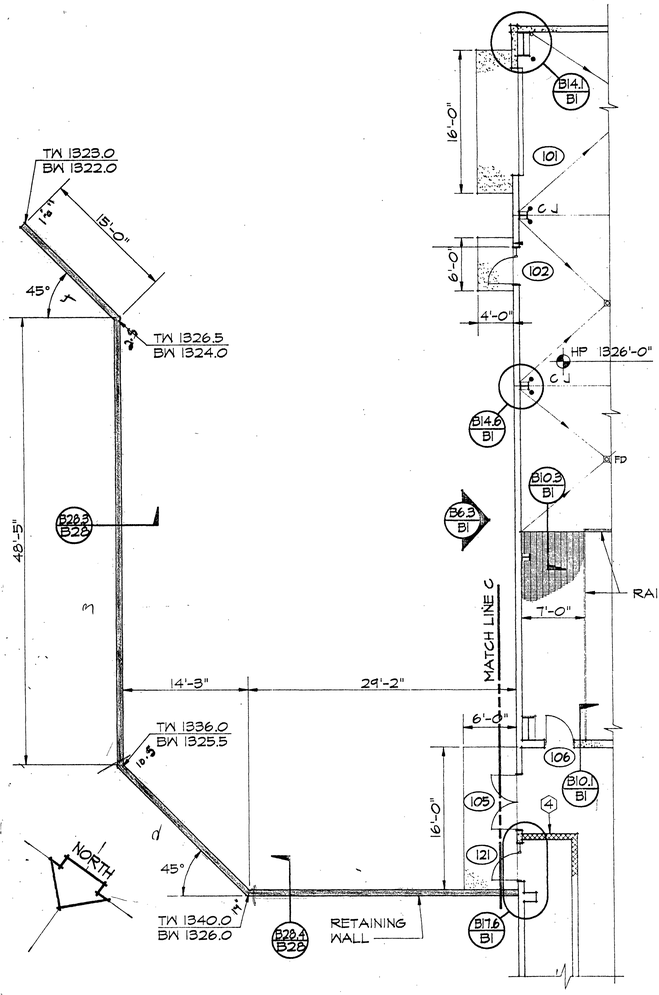

PLAN

SCALE 1/8" = 1'-0"

B28.1 / B3/1

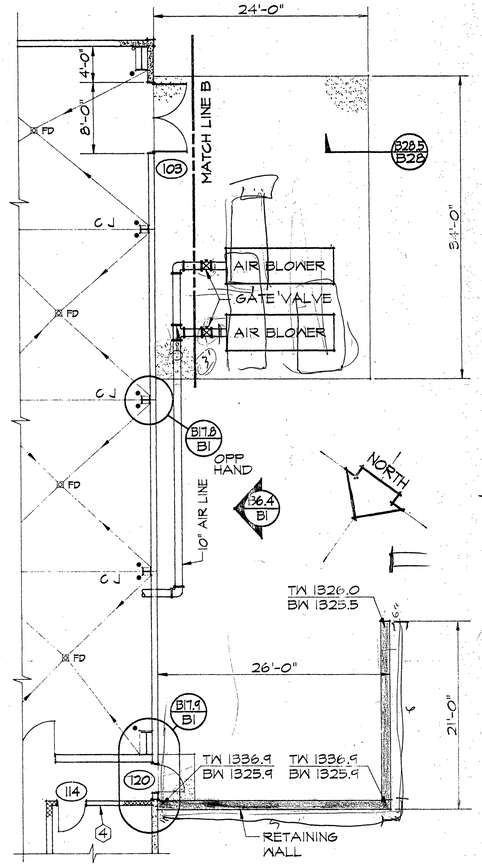

PLAN

SCALE 1/8" = 1'-0"

B28.2 / B3/1

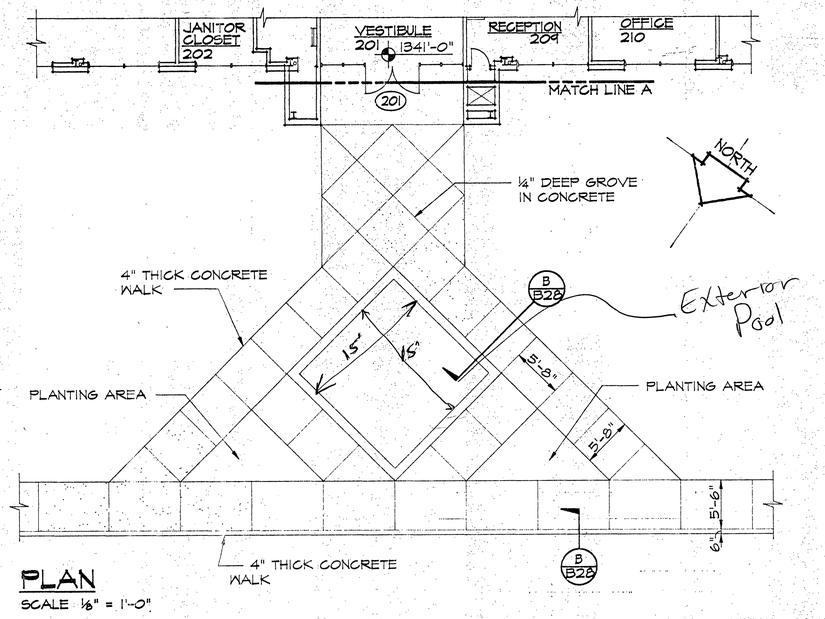

PLAN

SCALE 1/8" = 1'-0"

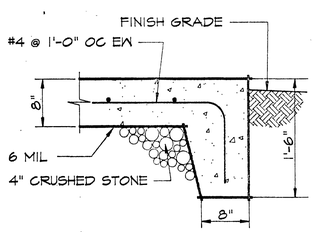

SECTION

SCALE 1" = 1'-0"

B28.5 / B4

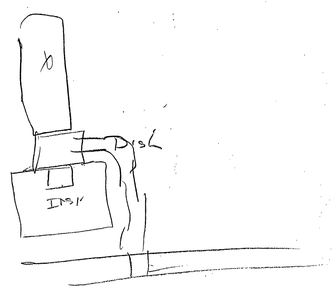

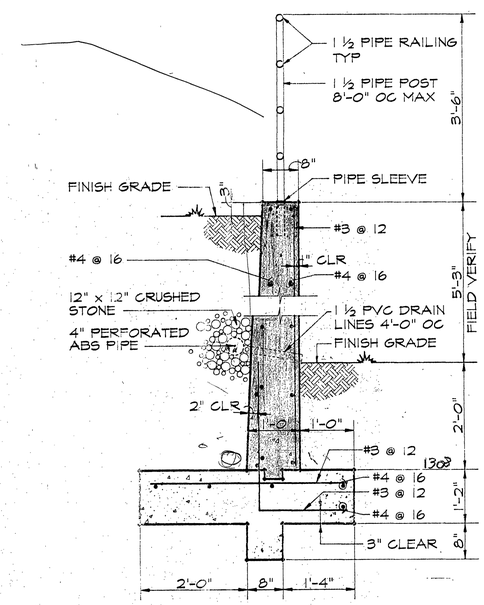

SECTION

SCALE 3/4" = 1'-0"

B28.3 / B4 B5

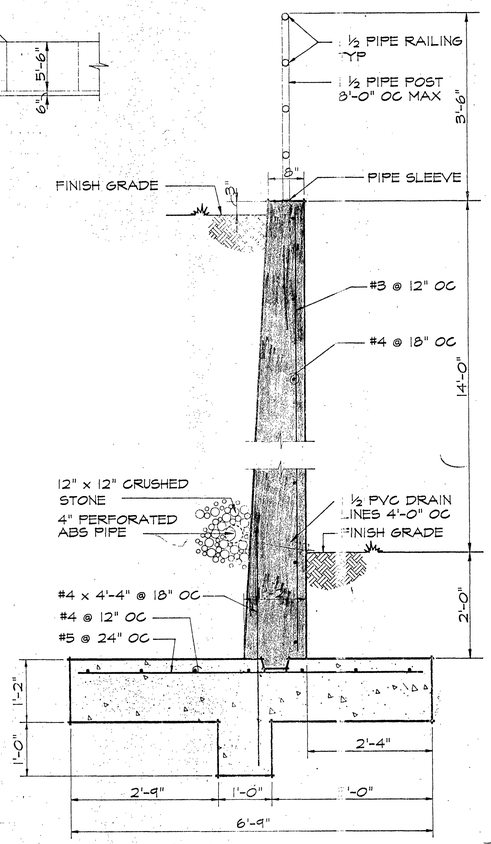

SECTION

SCALE 3/4" = 1'-0"

B28.4 / B4

INSPECTOR'S AS-BUILTS 1995

WVWA ID# 6LDLUZ

ROANOKE COUNTY WATER TREATMENT FACILITY

COUNTY OF ROANOKE VIRGINIA 1838

COMMONWEALTH OF VIRGINIA
RICHARD L. JONES, JR.
5957
ARCHITECT

PLANS AND SECTIONS - TREATMENT BLDG

PROJECT ARCHITECT	COMMISSION NUMBER
RLJ Jr	1913
TECHNICIANS	DATE
RVT	22 SEPT 1994

B28

ALBERT SHEFFIELD & ASSOCIATES
JONES & SHEFFIELD ASSOCIATES