

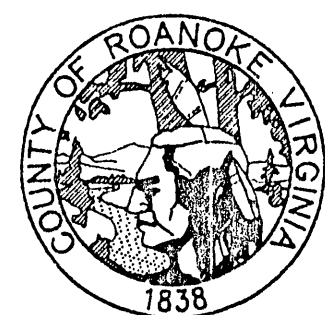


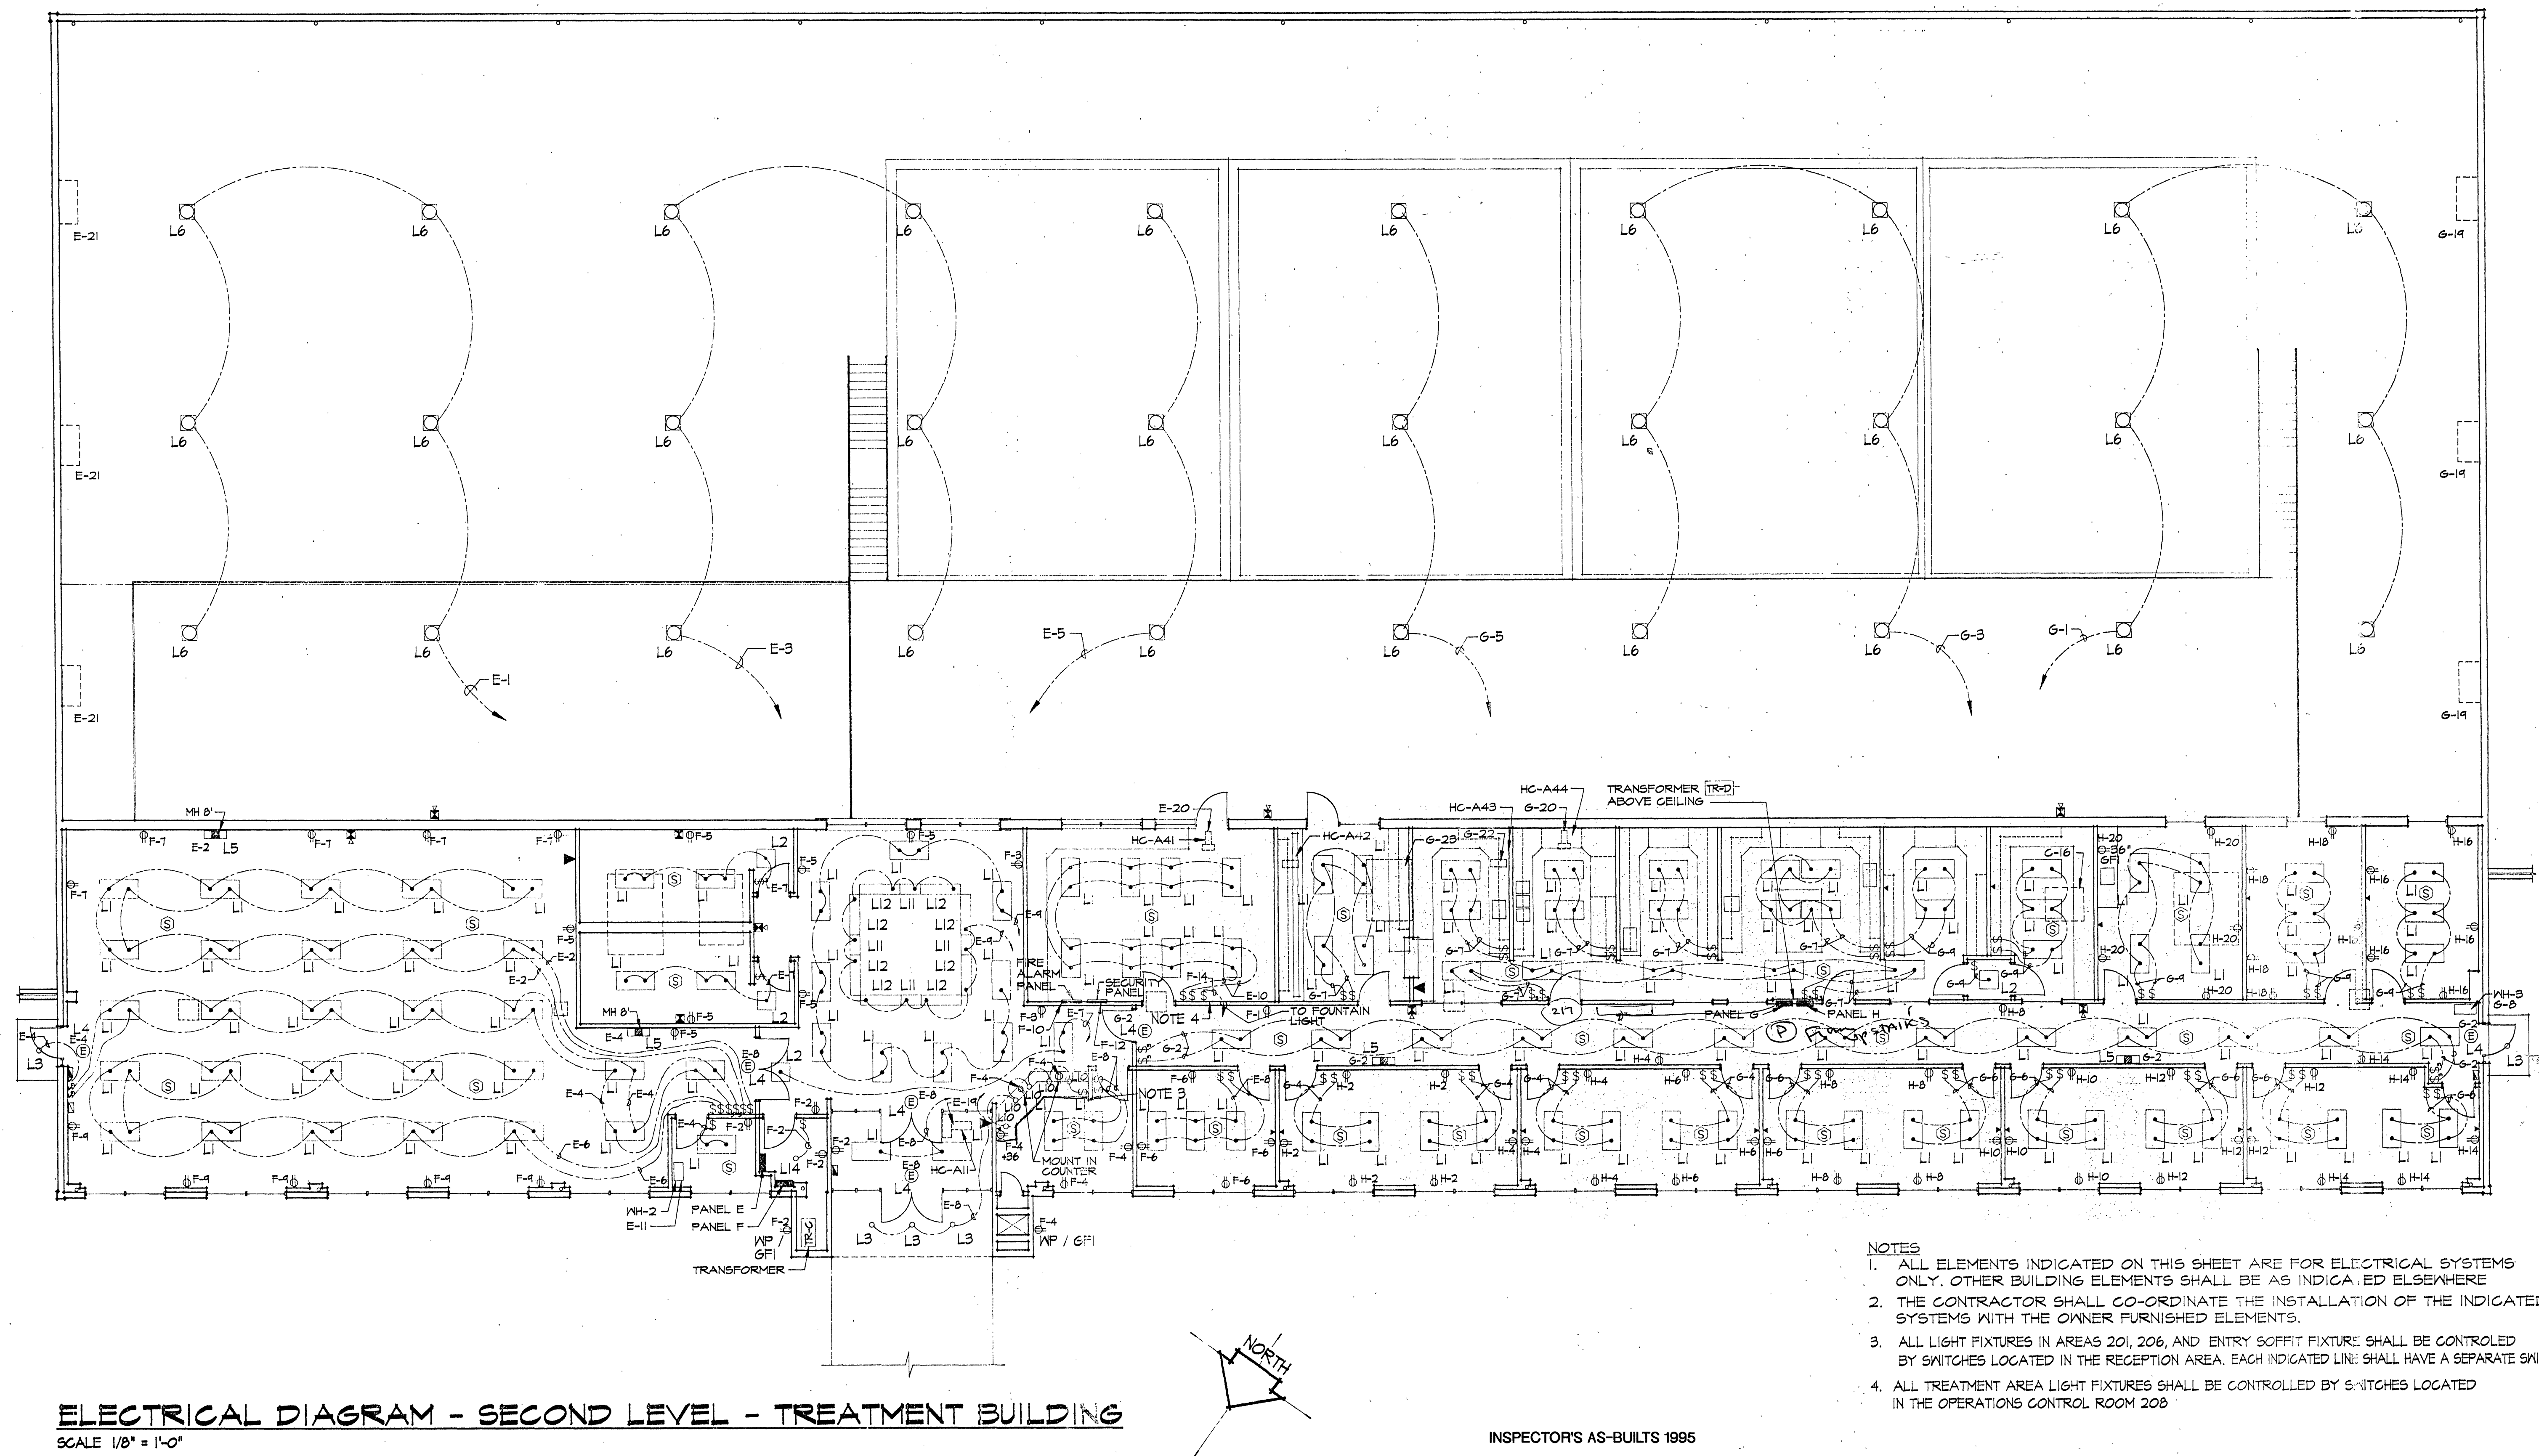

ROANOKE COUNTY WATER TREATMENT FACILITY

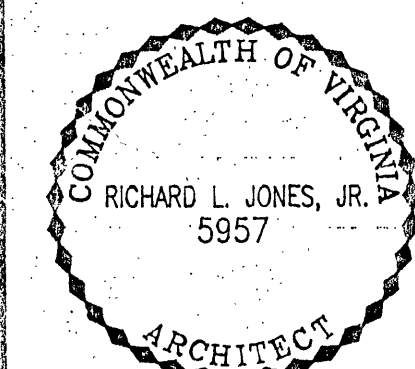

ELECTRICAL DIAGRAM - TREATMENT

PROJECT ARCHITECT RLJ JR	COMMISSION NUMBER 1913
TECHNICIAN RAT	DATE 22 SEPT 1994

E2