

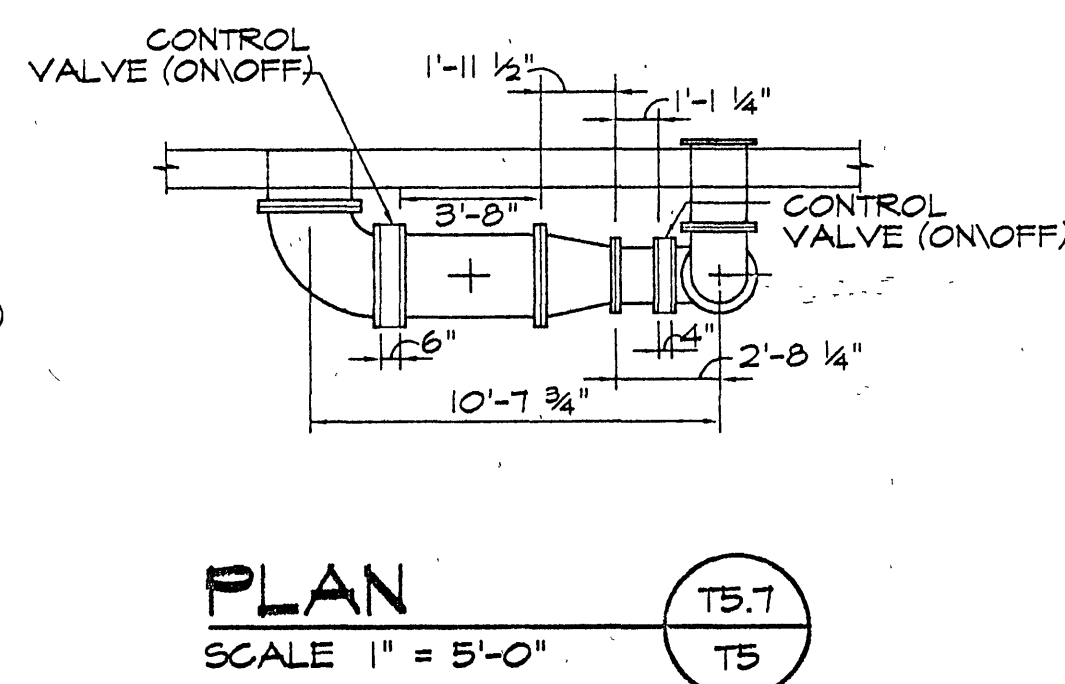
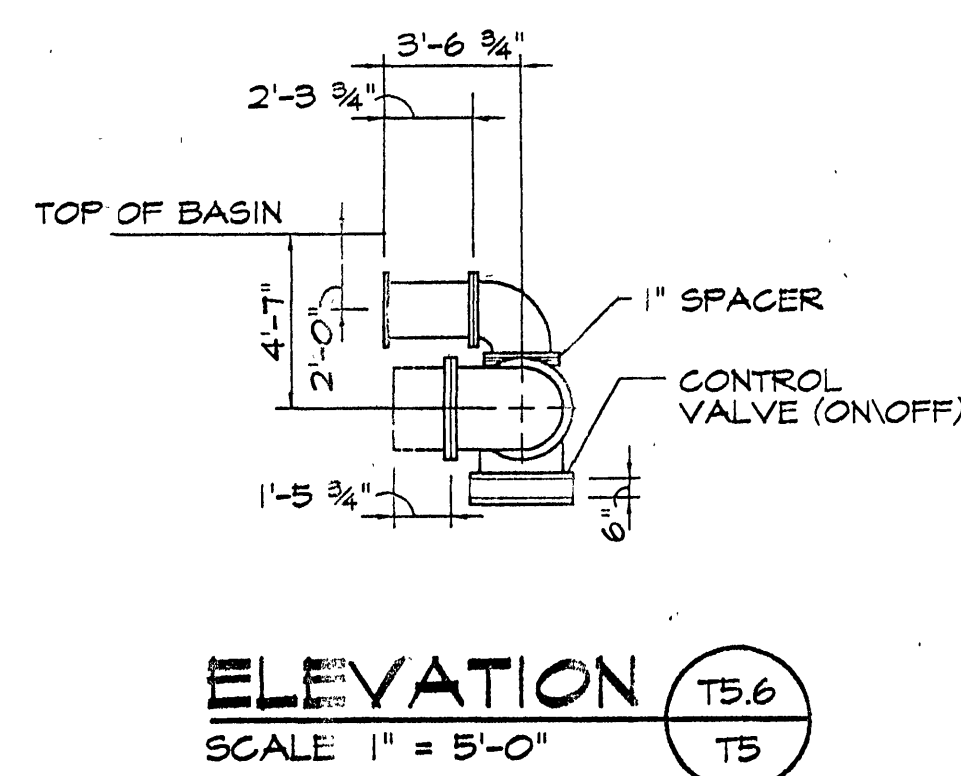
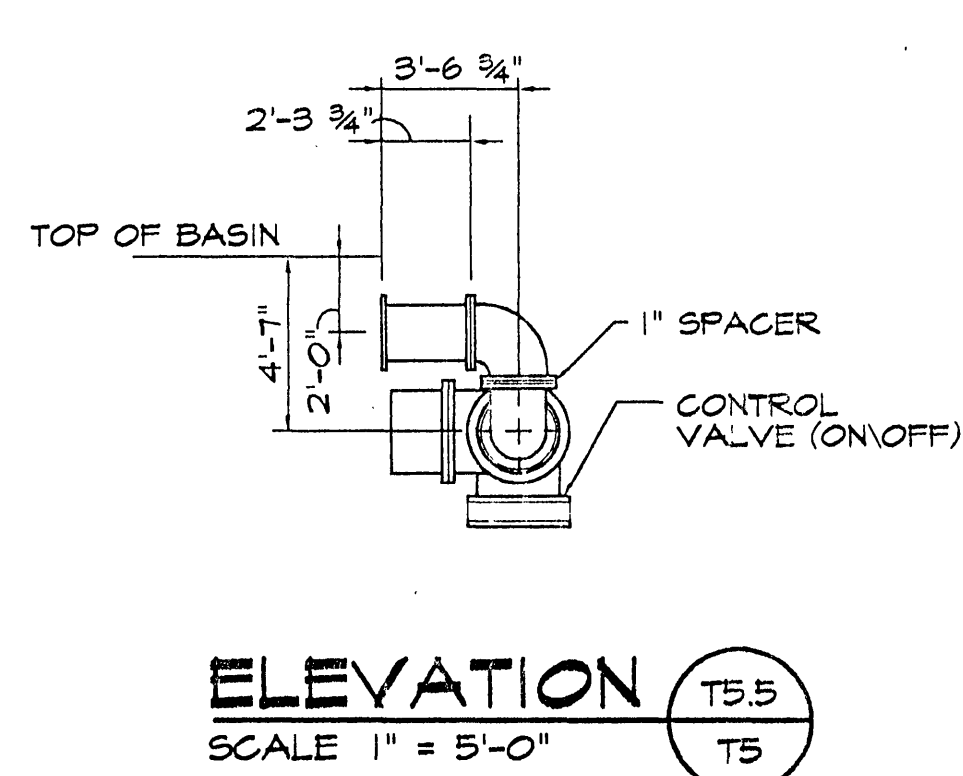
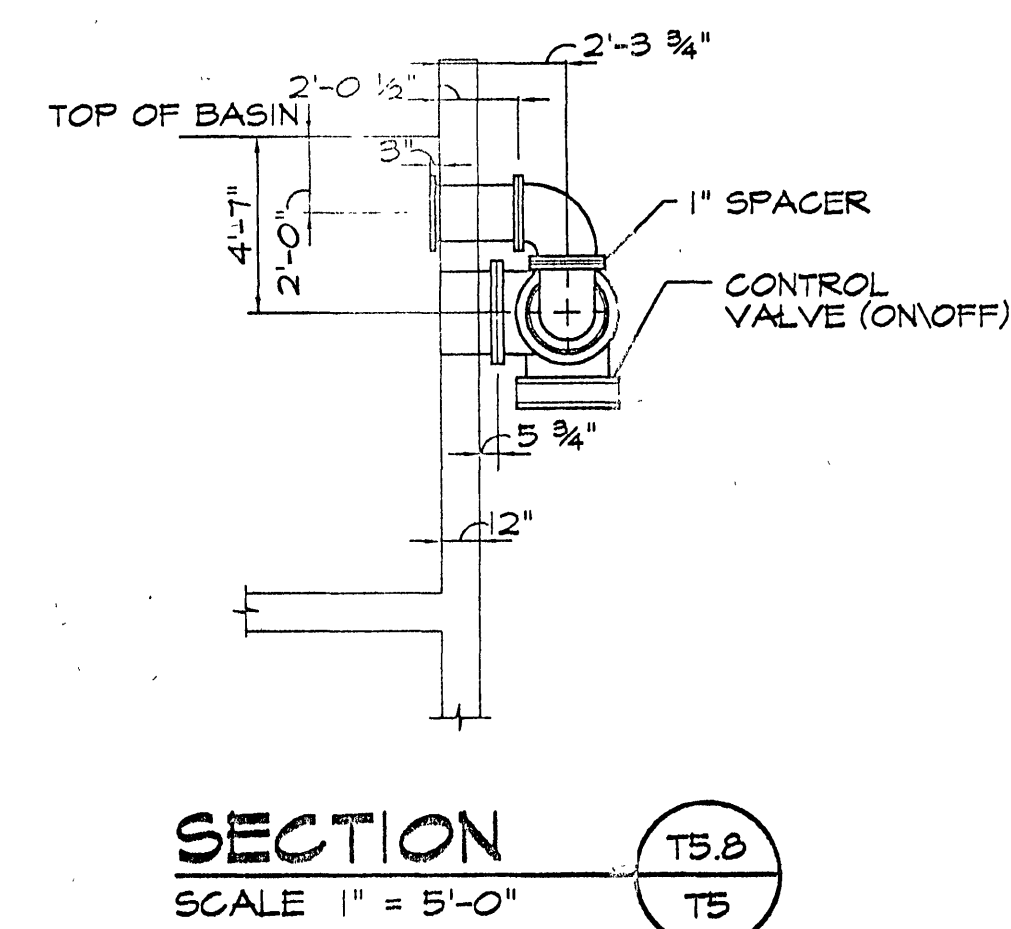
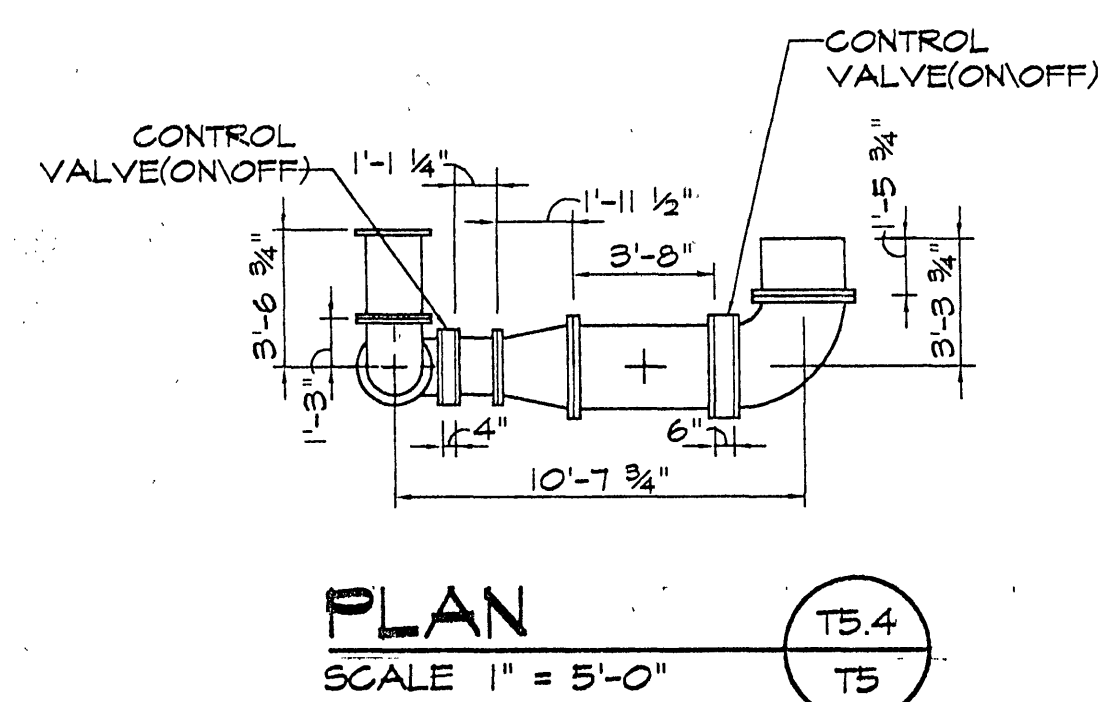
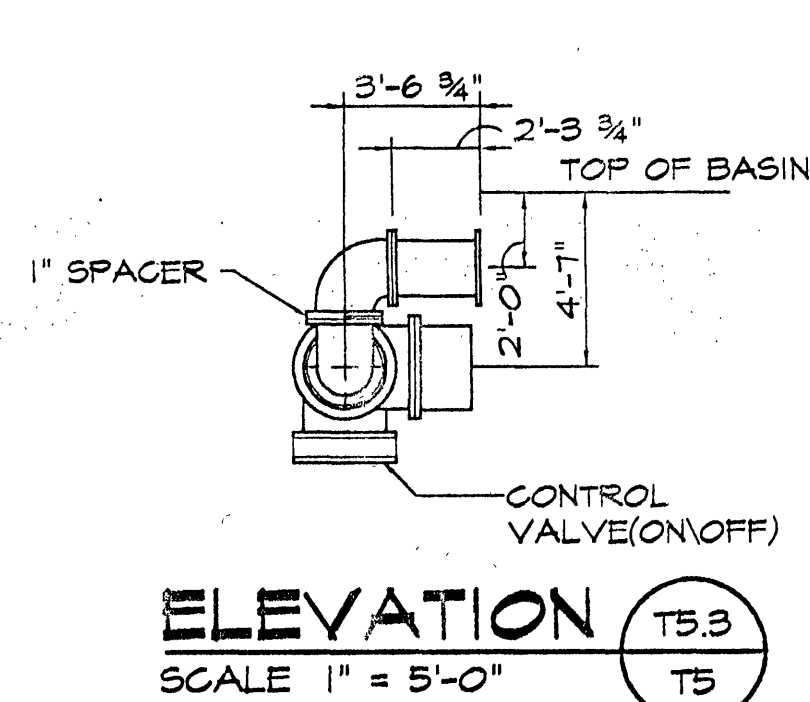
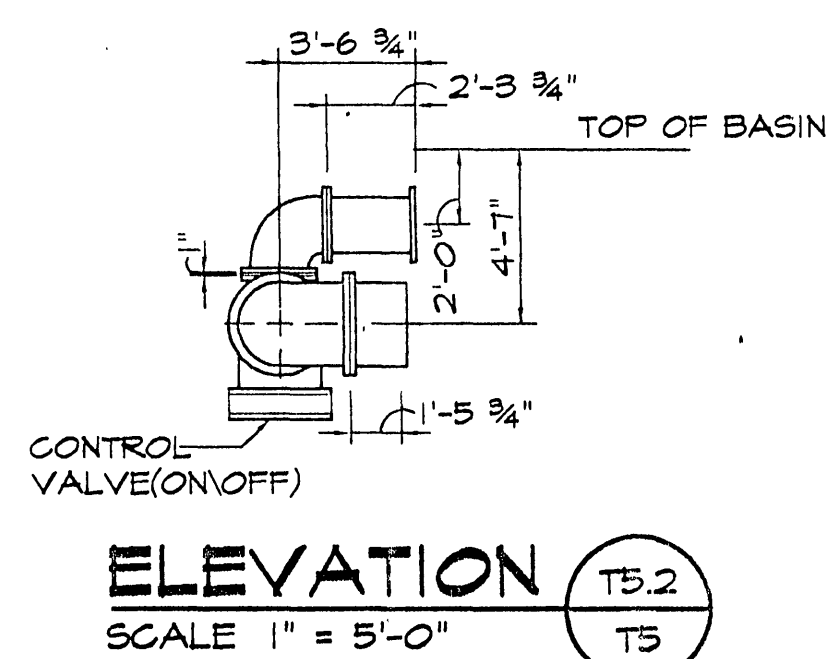
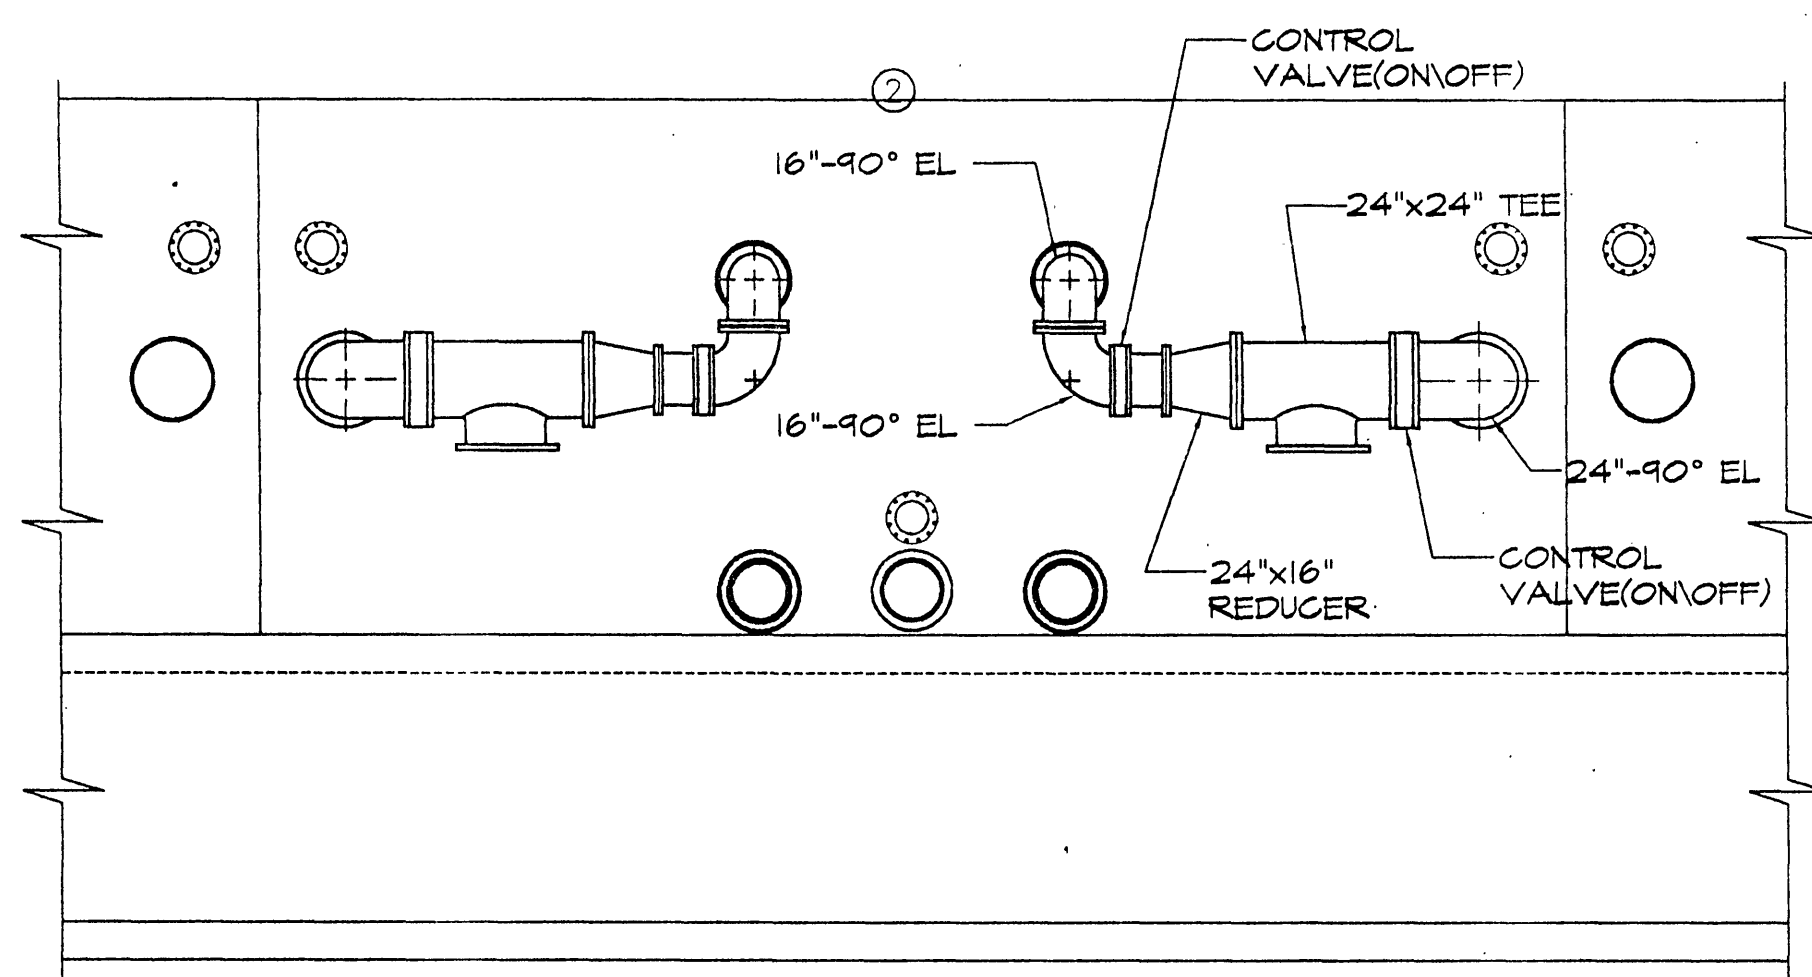



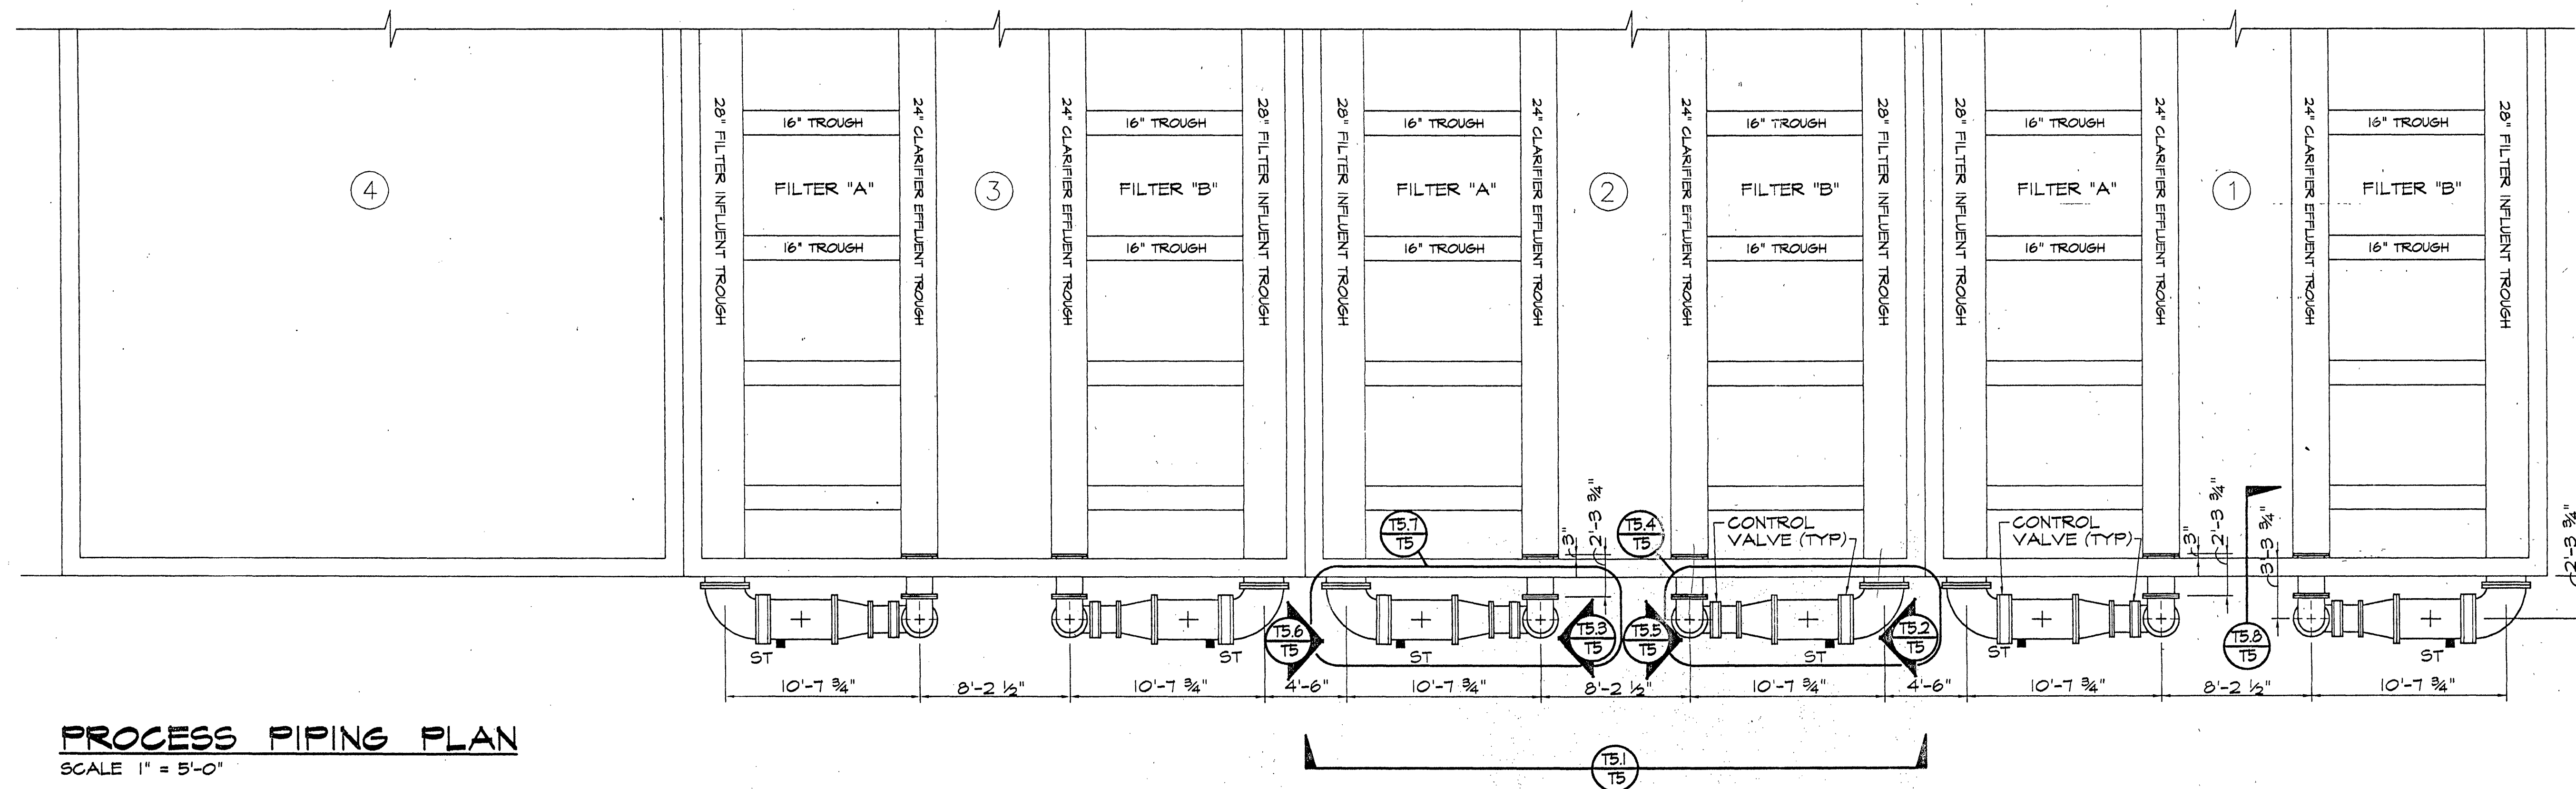


- NOTES**
1. ALL PROCESS PIPING AND FITTINGS TO BE 304 STAINLESS STEEL RATED AT 125 PSI
 2. ALL CONTROL VALVES TO BE SUPPLIED BY OTHERS
 3. CONTROL VALVE (ON/OFF): MOTORIZED ON/OFF BUTTERFLY VALVE WITH HAND OPERATOR

INSPECTOR'S AS-BUILTS 1995

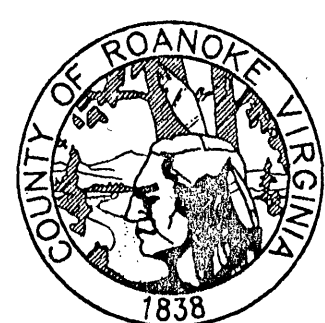

**ROANOKE COUNTY
WATER TREATMENT
FACILITY**

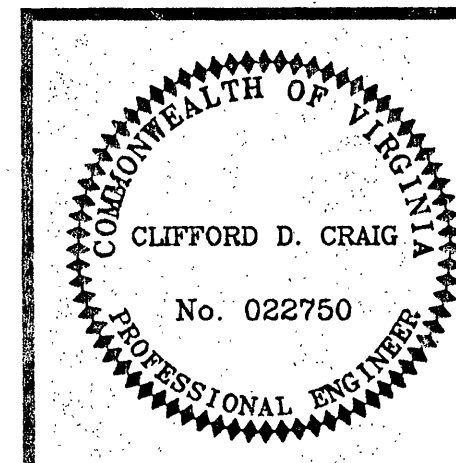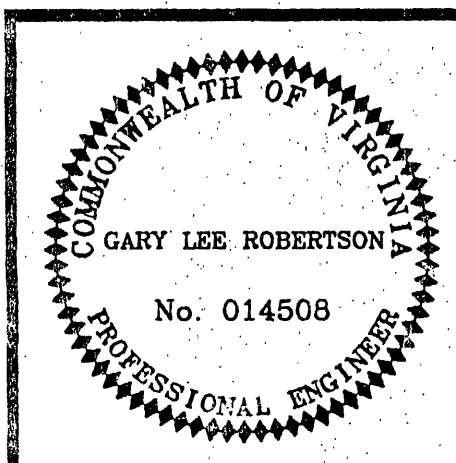

PROCESS PIPING DIAGRAMS	
DESIGN ENGINEER CLIFFORD D. CRAIG	COMMISSION NUMBER 1913
RCUD NUMBER WTF-1	DATE 9 SEPT. 1994

T5

ROANOKE COUNTY UTILITY DEPARTMENT