
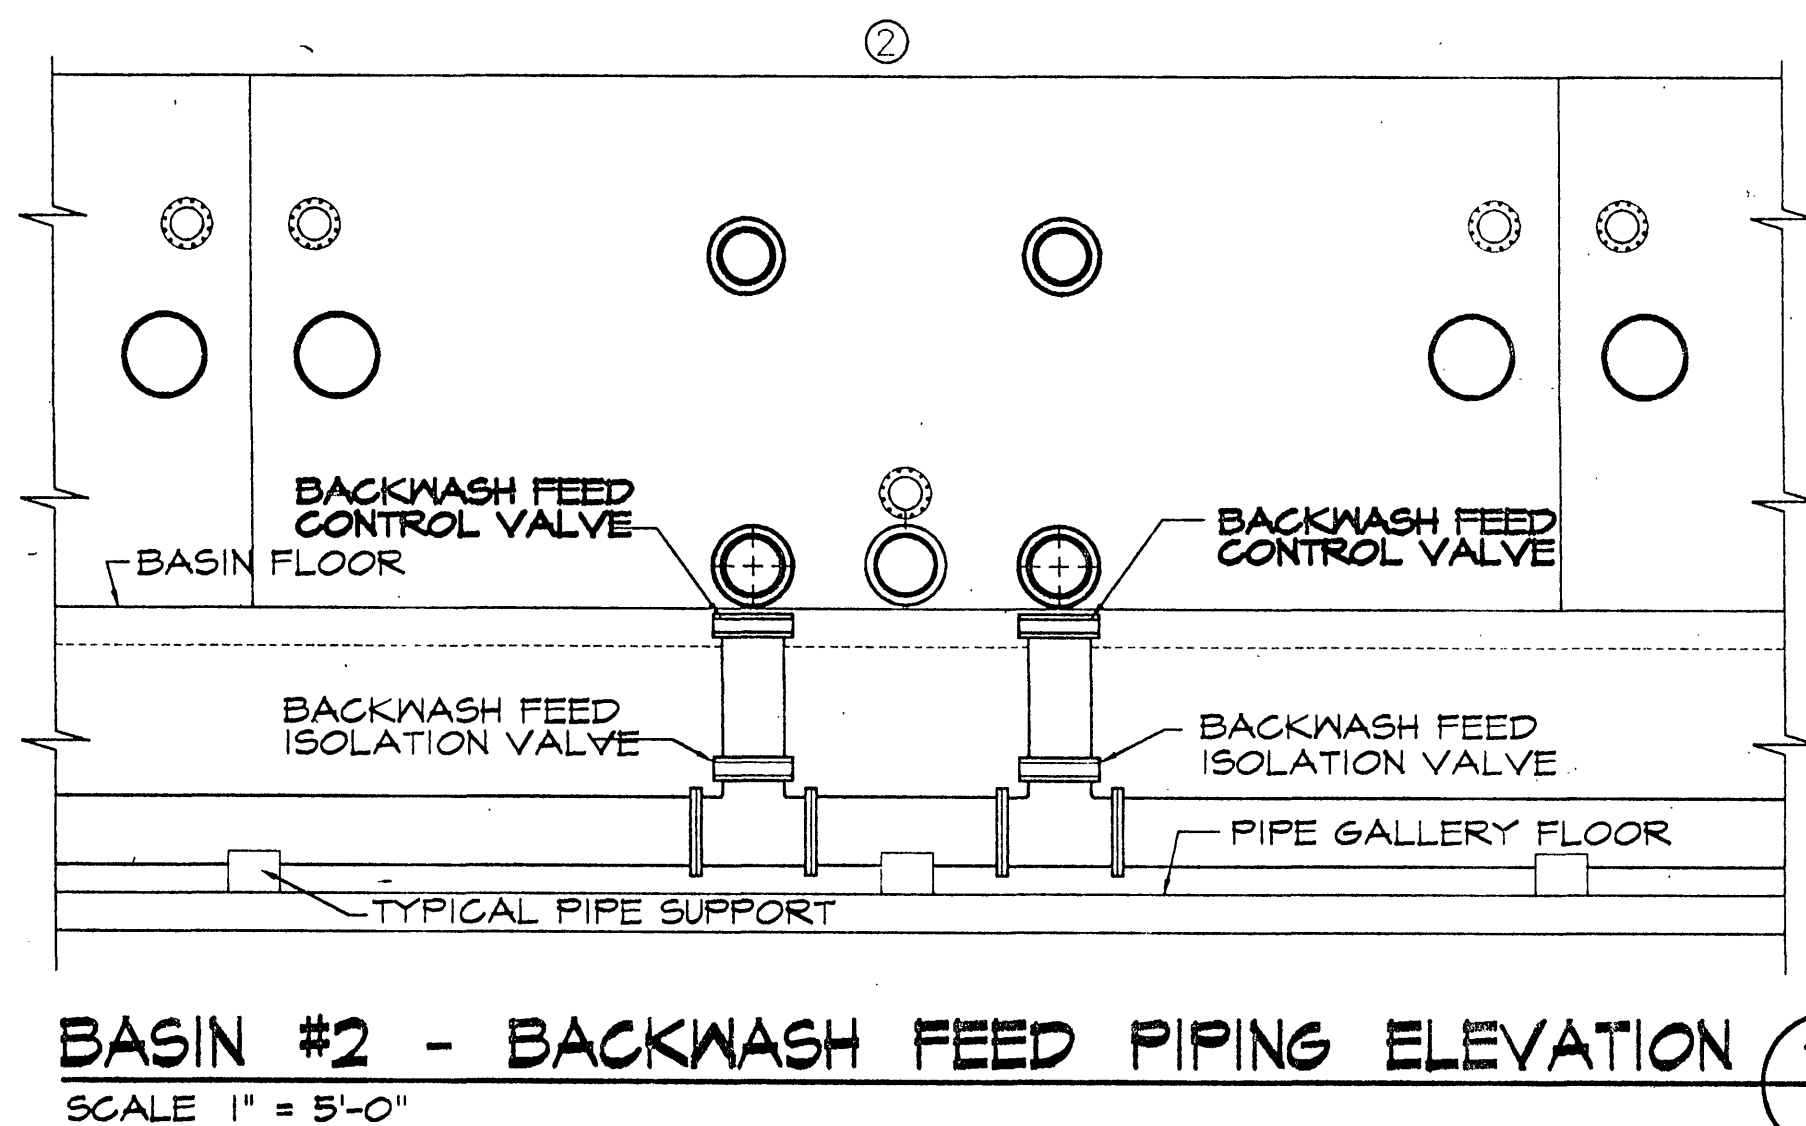
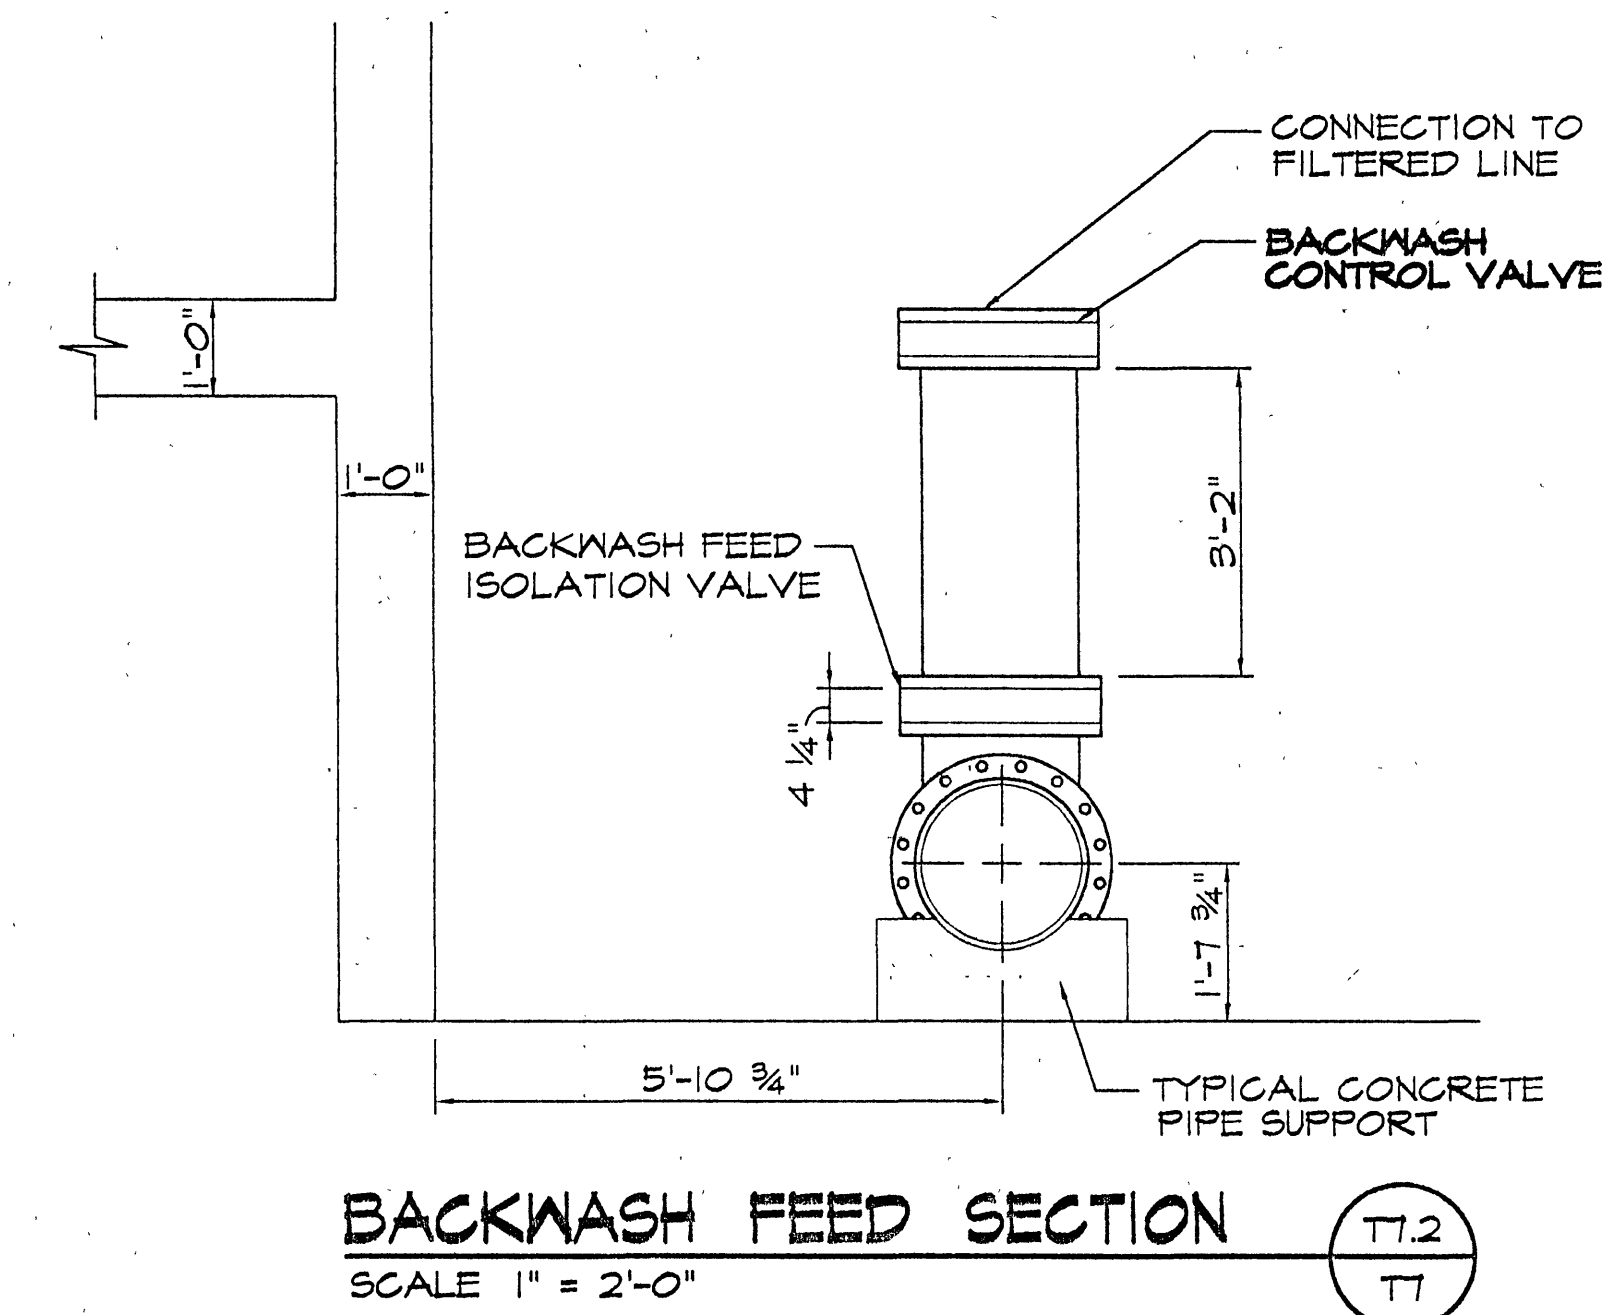
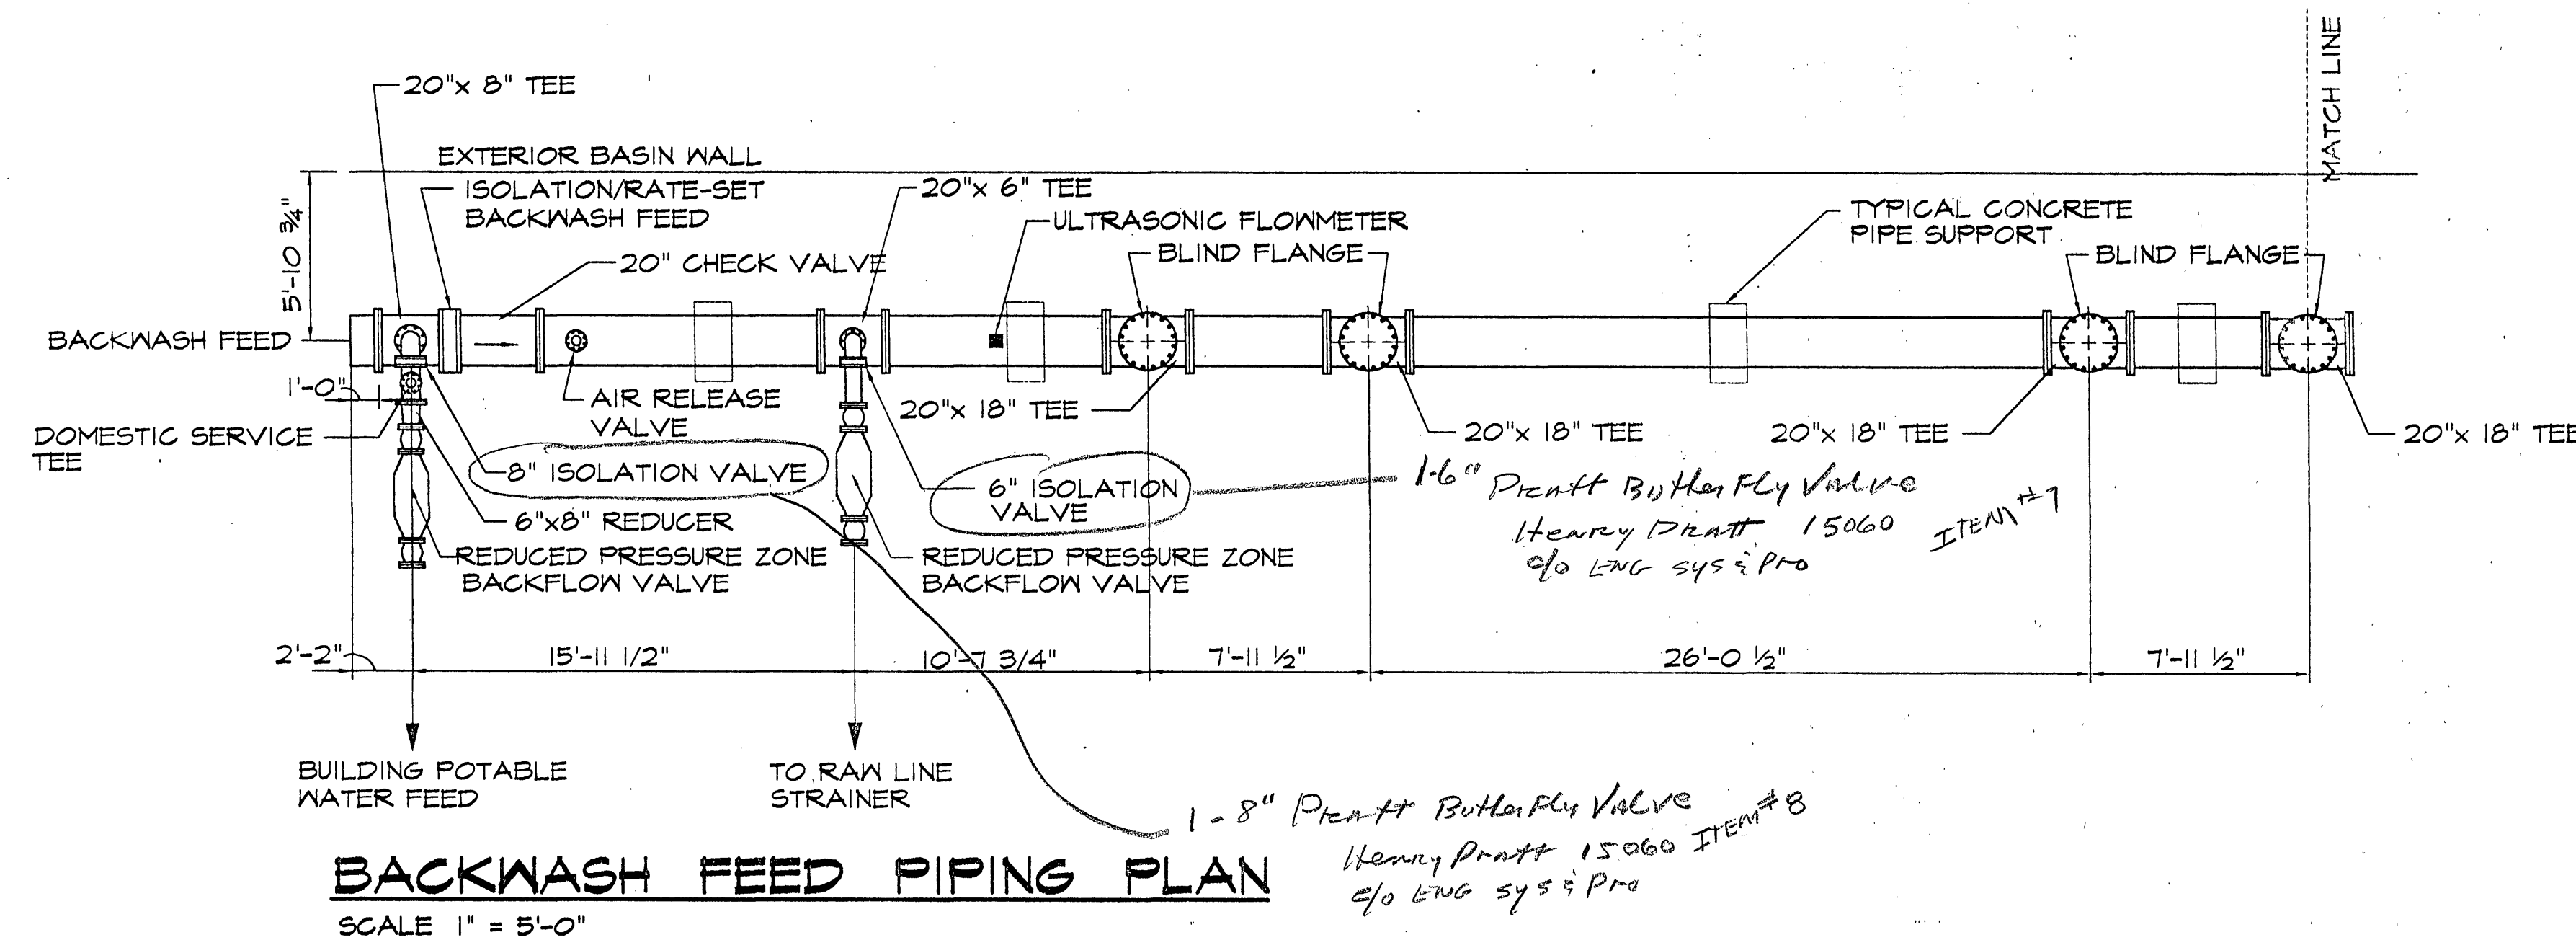




- NOTES:
1. ALL BACKWASH FEED PIPING AND FITTINGS TO BE 304 STAINLESS STEEL RATED AT 200 PSI
 2. ALL CONTROL VALVES TO BE SUPPLIED BY OTHERS
 3. CONTROL VALVE: MOTORIZED MODULATING BUTTERFLY VALVE WITH HAND OPERATOR

INSPECTOR'S AS-BUILTS 1995

WWW.ID#8DLUZ

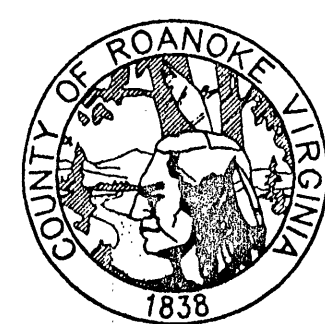

**ROANOKE COUNTY
WATER TREATMENT
FACILITY**

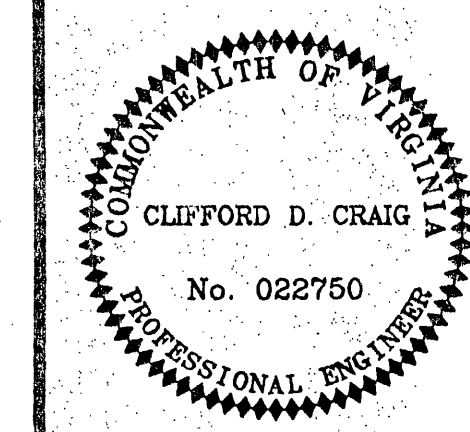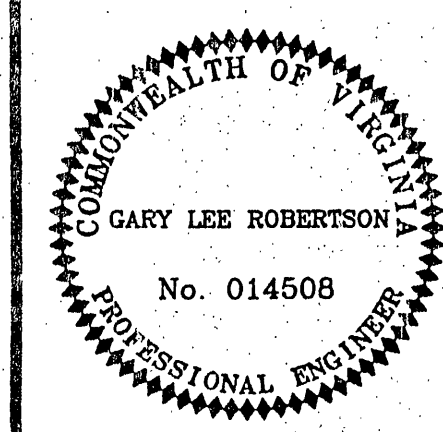

BACKWASH FEED PIPING DIAGRAM

DESIGN ENGINEER
CLIFFORD D. CRAIG

COMMISSION NUMBER
1913

RCUD NUMBER
WTF-1

DATE
9 SEPT. 1994

T7

ROANOKE COUNTY UTILITY DEPARTMENT