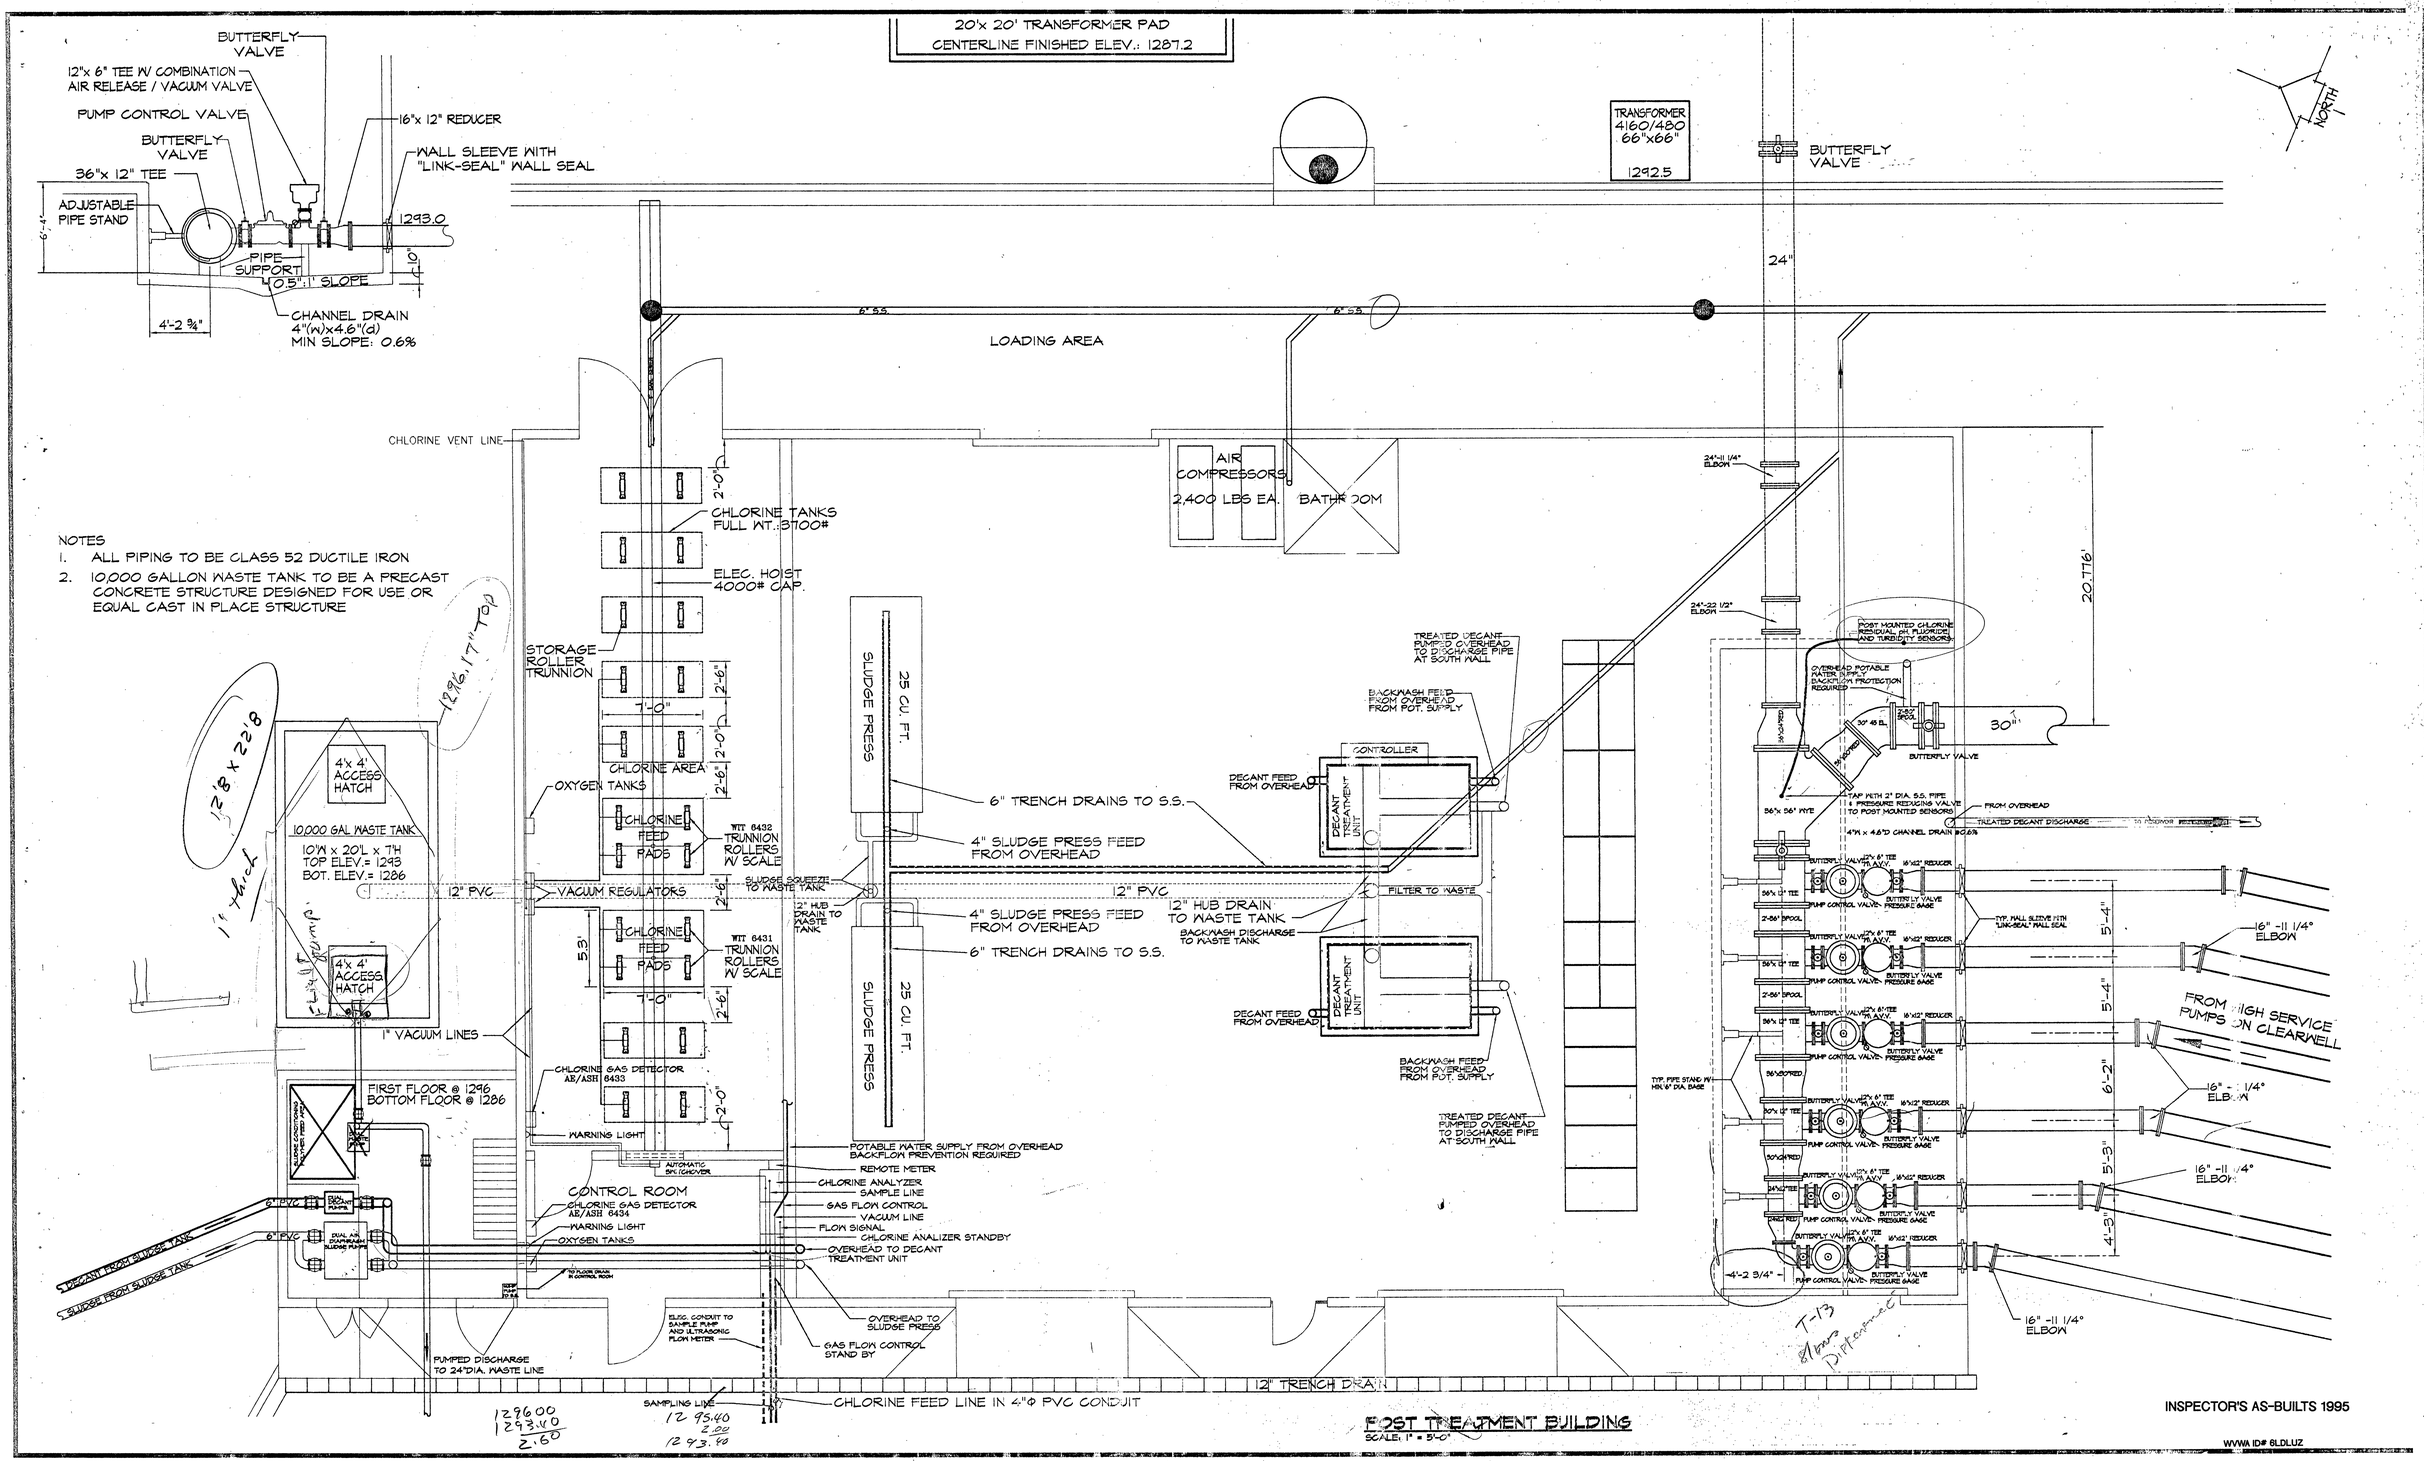

NOTES
1. ALL PIPING TO BE CLASS 52 DUCTILE IRON
2. 10,000 GALLON WASTE TANK TO BE A PRECAST CONCRETE STRUCTURE DESIGNED FOR USE OR EQUAL CAST IN PLACE STRUCTURE

INSPECTOR'S AS-BUILTS 1995

WWW ID# 6LDLUZ

POST TREATMENT BUILDING
SCALE: 1" = 5'-0"

ROANOKE COUNTY WATER TREATMENT FACILITY

COMMONWEALTH OF VIRGINIA — GARY LEE ROBERTSON — No. 014508 — PROFESSIONAL ENGINEER

COMMONWEALTH OF VIRGINIA — CLIFFORD D. CRAIG — No. 022750 — PROFESSIONAL ENGINEER

POST TREATMENT BUILDING
TREATMENT SYSTEM PLAN

DESIGN ENGINEER: CLIFFORD D. CRAIG	COMMISSION NUMBER: 1913
RCUD NUMBER: WTF-1	DATE: 12 SEPT. 1994

T11

ROANOKE COUNTY UTILITY DEPARTMENT