
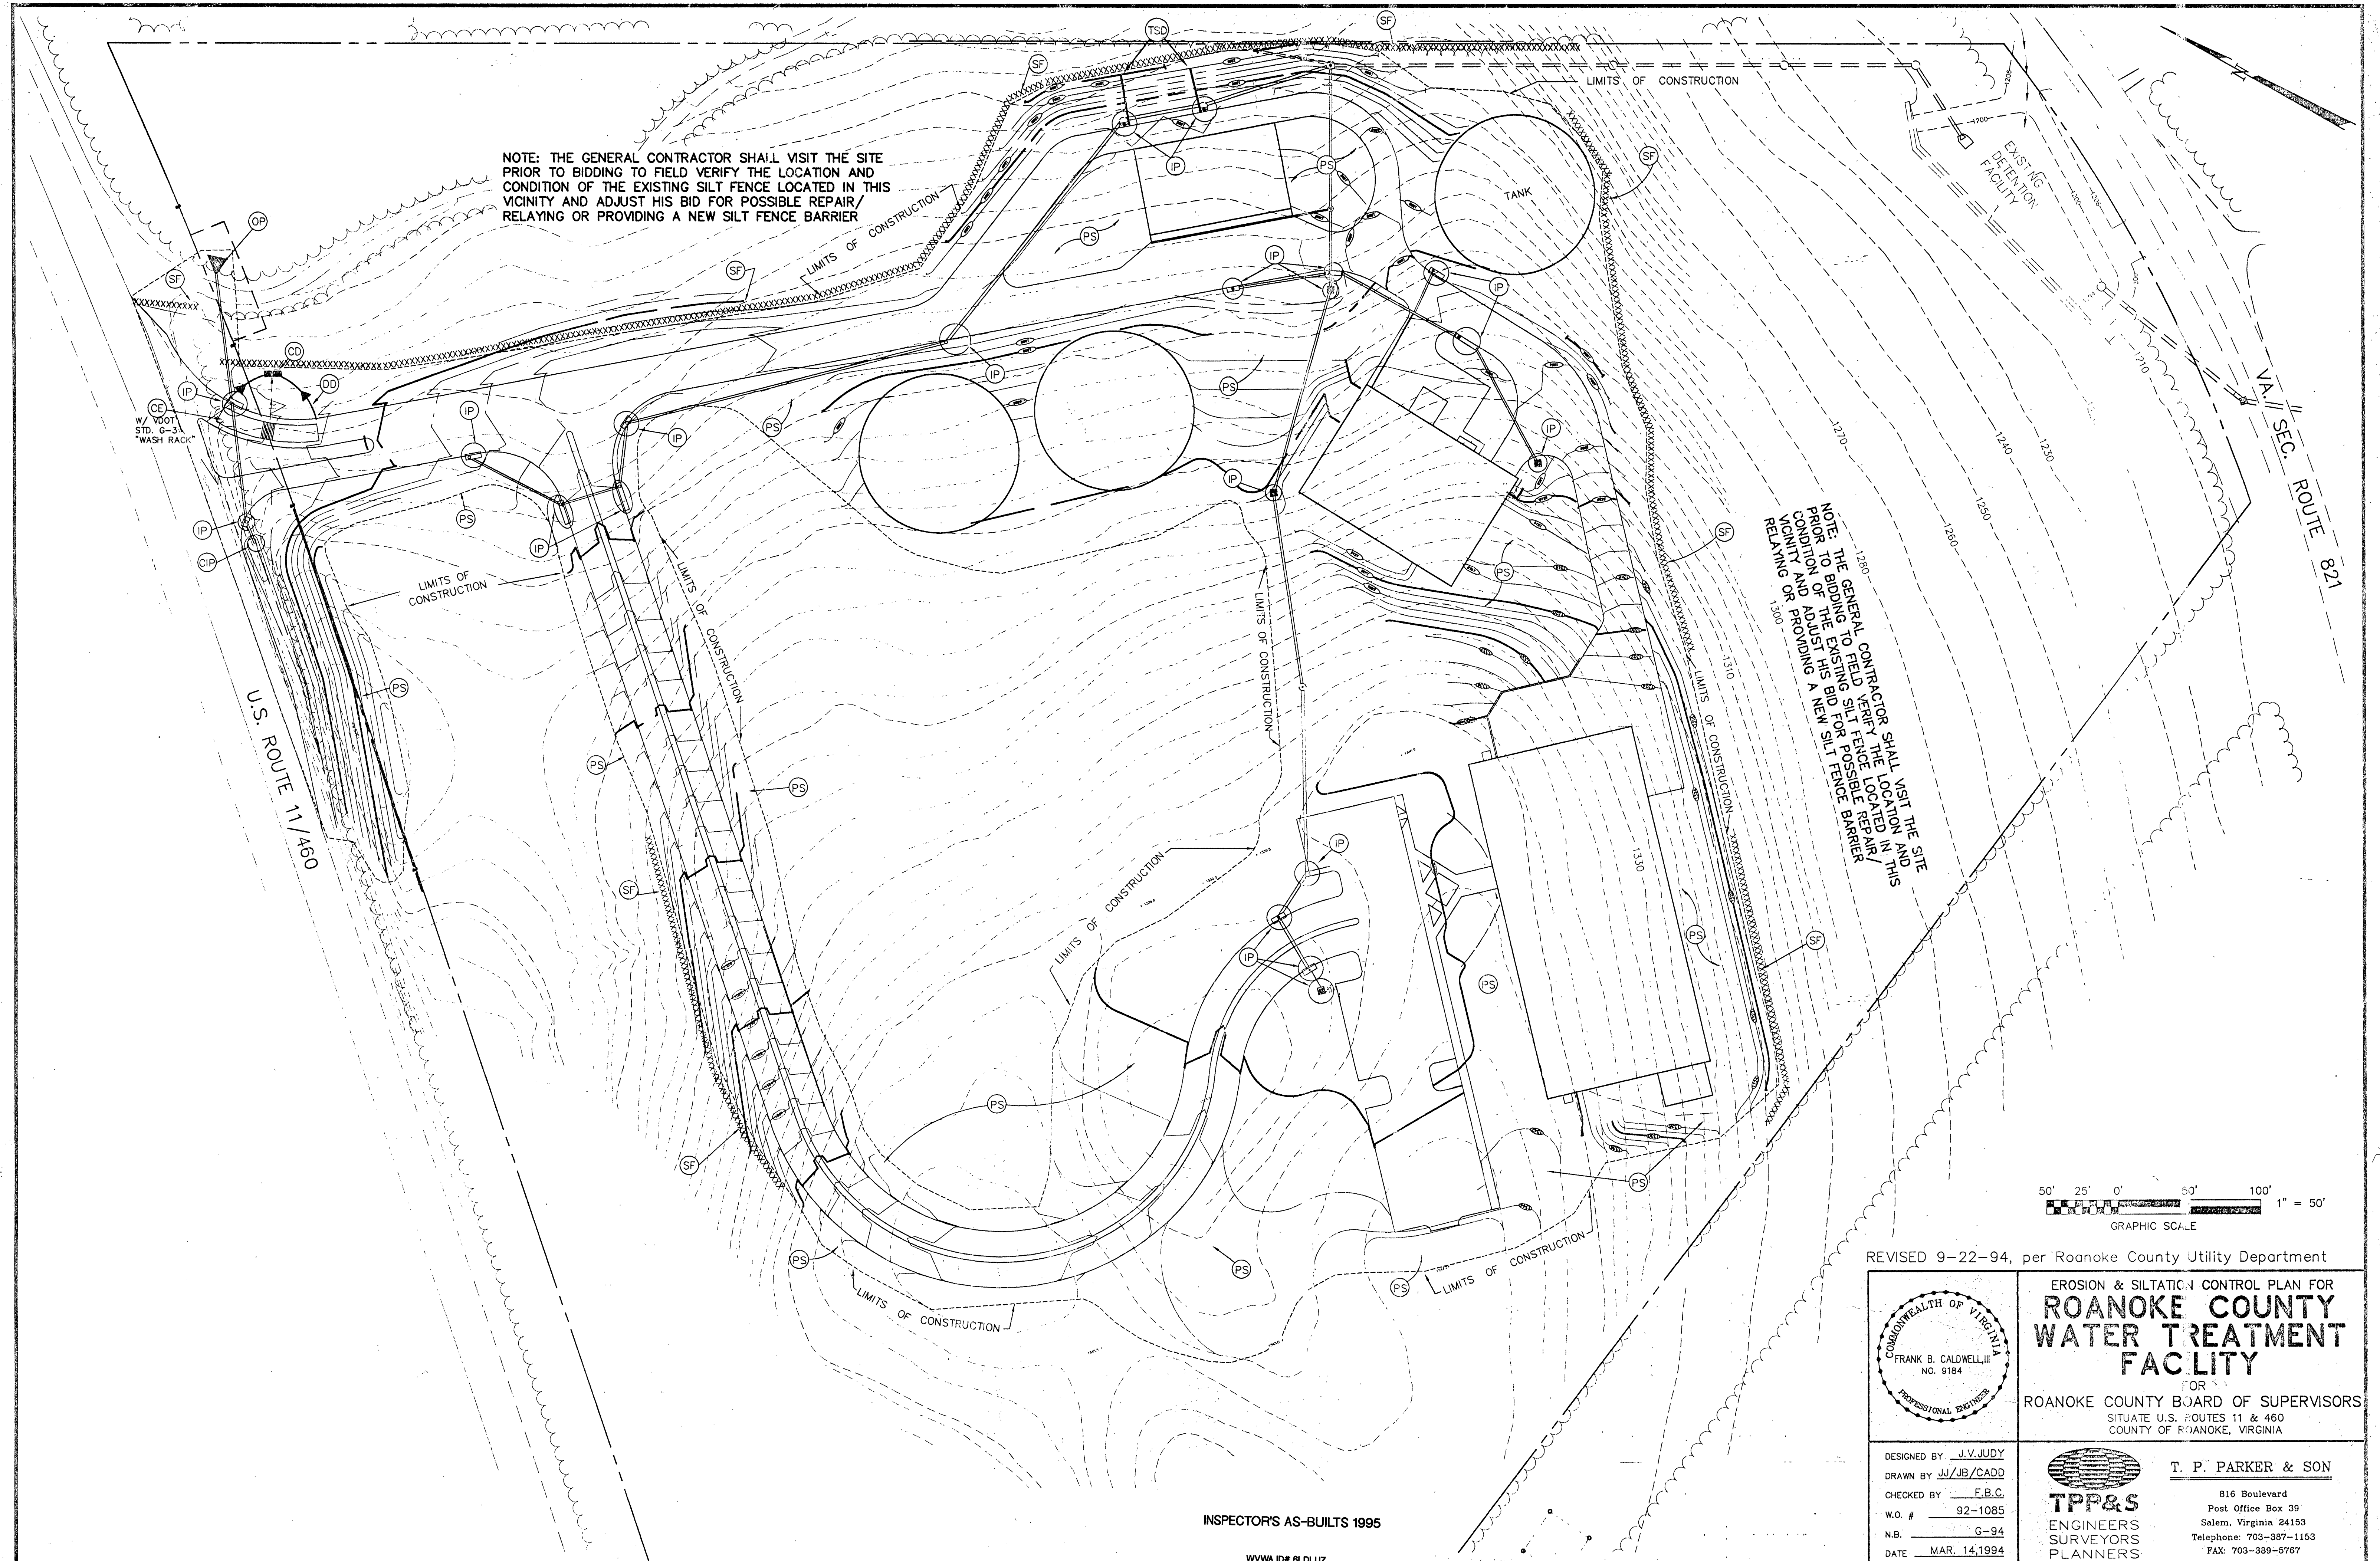
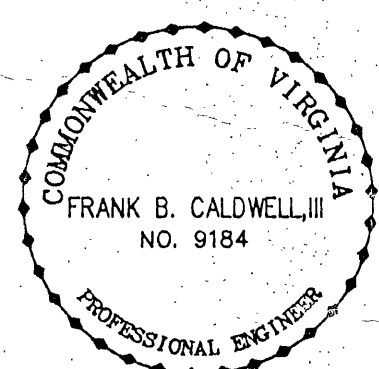


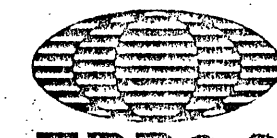

REVISED 9-22-94, per Roanoke County Utility Department

	EROSION & SILTATION CONTROL PLAN FOR ROANOKE COUNTY WATER TREATMENT FACILITY	
	FOR ROANOKE COUNTY BOARD OF SUPERVISORS SITUATE U.S. ROUTES 11 & 460 COUNTY OF ROANOKE, VIRGINIA	
DESIGNED BY <u>J.V. JUDY</u> DRAWN BY <u>JJ/JB/CADD</u> CHECKED BY <u>F.B.C.</u> W.O. # <u>92-1085</u> N.B. <u>G-94</u> DATE <u>MAR. 14, 1994</u>	 TPP&S ENGINEERS SURVEYORS PLANNERS	T. P. PARKER & SON 816 Boulevard Post Office Box 39 Salem, Virginia 24153 Telephone: 703-387-1153 FAX: 703-389-5767