

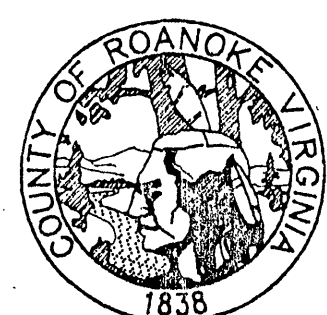


PLANT SCHEDULE

KEY	SCIENTIFIC NAME	MIN SIZE	SPACING	REMARKS	DETAIL
DT	DECIDUOUS TREES				
DT-1	PRUNUS CERASIFERA "THUNDERCLOUD"	2 CAL	AS SHOWN	B & B	A
DT-2	LARGESTROEMIA INDICA "NATCHEZ"	8' HT	AS SHOWN	B & B	A
DT-3	KOELREUTERIA PANICULATA	2 1/2" CAL	AS SHOWN	B & B	A
DT-4	FRAXINUS AMERICANA	2 1/2" CAL	AS SHOWN	B & B	A
DT-5	QUERCUS MACROCARPA	2 1/2" CAL	AS SHOWN	B & B	A
DT-6	QUERCUS RUBRA	2 1/2" CAL	AS SHOWN	B & B	A
DT-7	CORNUS MAS	7' HT	10' OC	B & B	A
DT-8	CORNUS SERICEA	9'	5' OC	CONTAINER	B
DT-9	CERCIS CANADENSIS	5' HT	AS SHOWN	B & B	A
DT-10	CORNUS KOUSA	5' HT	AS SHOWN	B & B	A
DT-11	ACER ACCHARUM "LEGACY"	2 1/2" CAL	AS SHOWN	B & B	A
ET	EVERGREEN TREES				
ET-1	CYPRESSOCYPARIS LEYLANDII	5' - 7' GAL	6' OC	CONTAINER	B
ET-2	ILEX OPACA (FEMALE)	6'	AS SHOWN	B & B	B
ET-3	ILEX OPACA (MALE)	6'	AS SHOWN	B & B	B
ET-4	ILEX X " NELLIE R. STEVENSON "	5'	AS SHOWN	B & B	B
ET-5	PINUS STROBUS	7' HT	AS SHOWN	B & B	B
ES	EVERGREEN SHRUBS				
ES-1	ILEXGRENATA " COMPACTA "	30"	42" OC	B & B	B
ES-2	TAXUS X MEDIA " DENSIFORMIS "	36"	AS SHOWN	B & B	B
ES-3	PINUS MUGO	18" 3 GAL	AS SHOWN	CONTAINER	B
ES-4	PHOTINIA X FRASERI	24" 3 GAL	4' OC	CONTAINER	B
ES-5	ILEX GRENATA " HALLERI "	18" 3 GAL	30" OC	CONTAINER	B
ES-6	BERBERIS THUNBERGII " CRIMSON PYGMY "	15" 3 GAL	30" OC	CONTAINER	B
ES-7	JUNIPERUS PROCUMBENS	18" 3 GAL	30" OC	CONTAINER	B
DS	DECIDUOUS SHRUBS				
DS-1	VIBURNUM LENTAGO	24"	5' OC	B & B	B
DS-2	ILEX VERTICILLATA	36"	5' OC	B & B	B
P	PERENNIALS				
P-1	LIRIOPE MUSCARI " MAJESTIC "	1 QT	10" OC		C,6
P-2	LIRIOPE MUSCARI " VARIEGATED "	1 QT	10" OC		C,6
P-3	HEMEROCALLIS " STELLA DE ORA "	1" POT	30" OC		C,6
P-4	HEMEROCALLIS " PINK CHARM "	1 GAL	30" OC		C,6
P-5	HEMEROCALLIS " MARY ELIZABETH "	1 GAL	30" OC		C,6
P-6	HEMEROCALLIS " SAMMY RUSSELL "	1 GAL	30" OC		C,6
P-7	IRIS SIBERICA " SNOW QUEEN "	1 GAL	30" OC		C,6
P-8	PENNISETUM ALOPECURIPIDES " HAMELN "	1 GAL	30" OC		C,6
P-9	SEDUM SPECTABILE " BRILLIANT "	1 GAL	30" OC		C,6
P-10	MISCANTHUS SINENSIS	1 GAL	36" OC		C,6
P-11	RUDBECKIA	1 GAL	30" OC		C,6
P-12	COREOPSIS GRANDIFLORA " EARLY SUNRISE "	1 QT	24" OC		C,6
B	BULBS				
B-1	DAFFODIL " DUCH MASTER "	TOP DN II	4		C,6
B-2	DAFFODIL " PRIMEUR "	TOP DN II	4		C,6
B-3	MIXED CROCUS	TOP DN II	15		C,6
B-4	MIXED ANEMONE BLANDA	TOP DN II	15		C,6

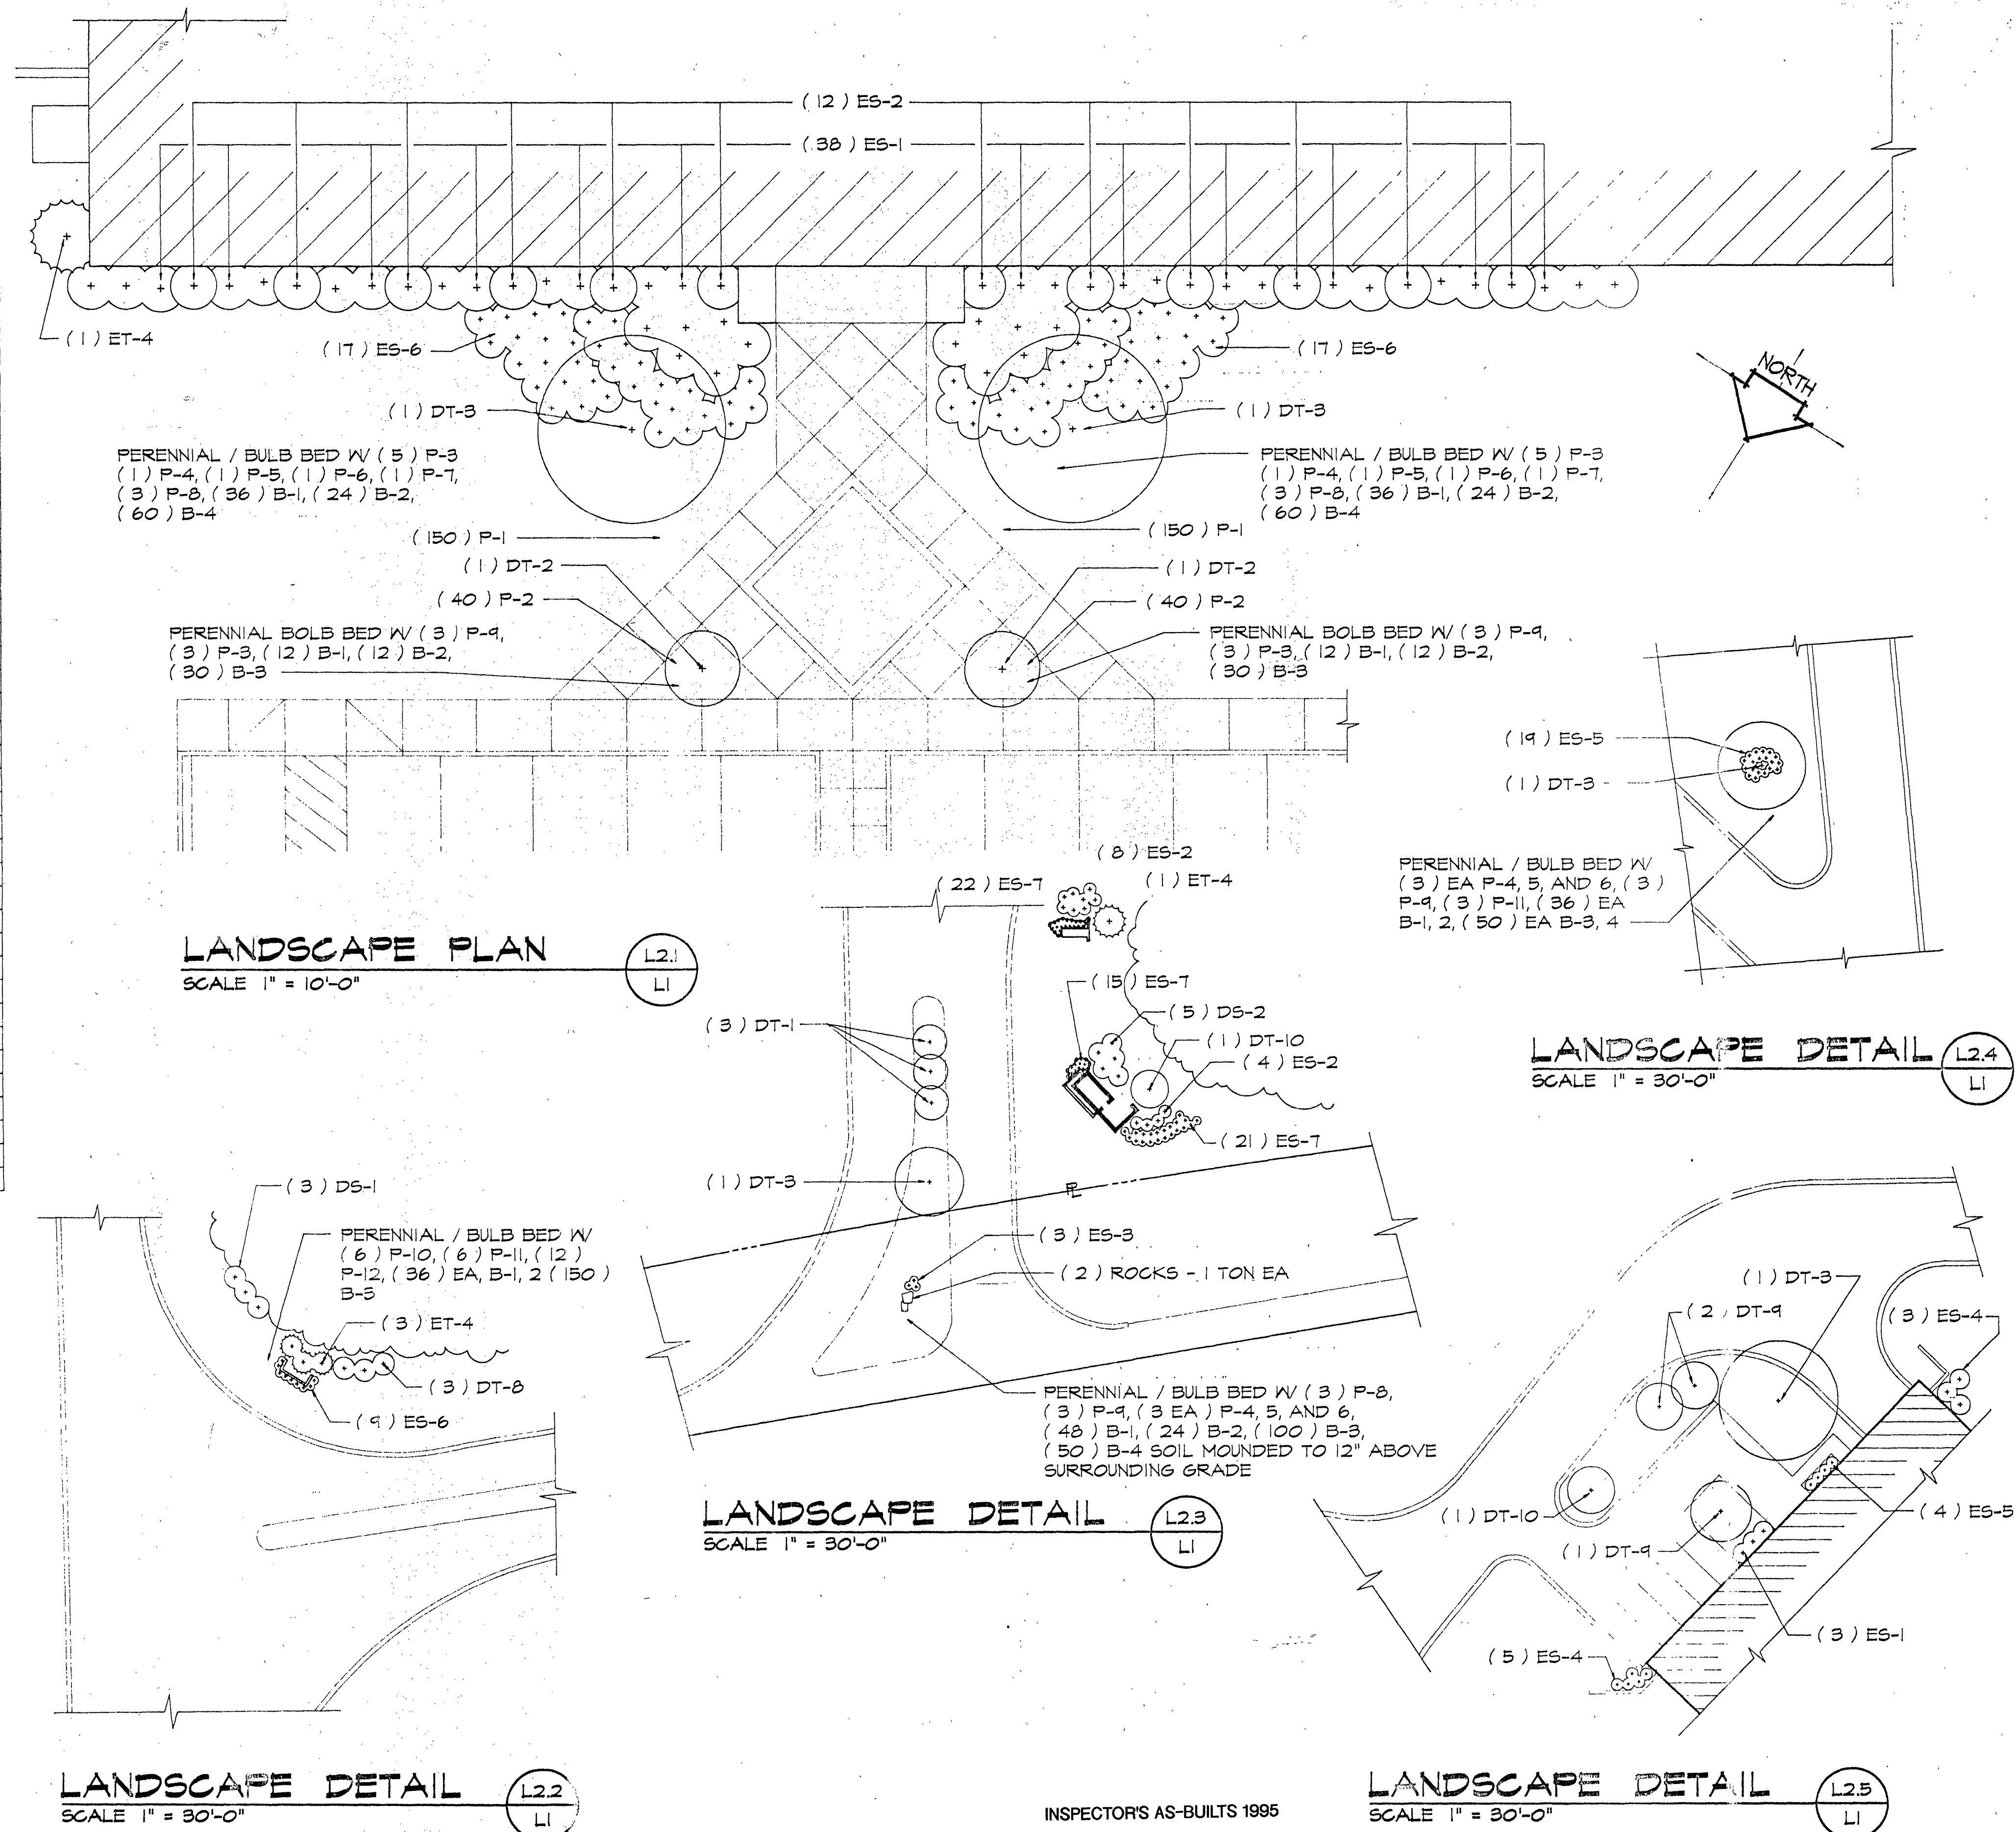

ROANOKE COUNTY WATER TREATMENT FACILITY

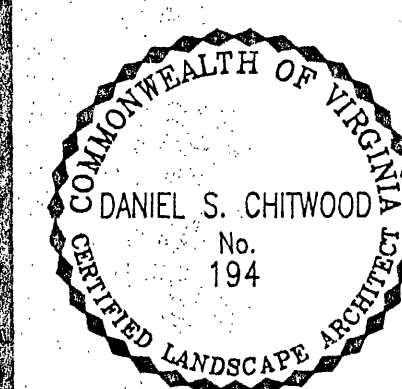

LANDSCAPING PLAN	
PROJECT ARCHITECT RLJ JR. DSC	COMMISSION NUMBER 1913
TECHNICIAN RAT	DATE 22 SEPT 1994

L2