

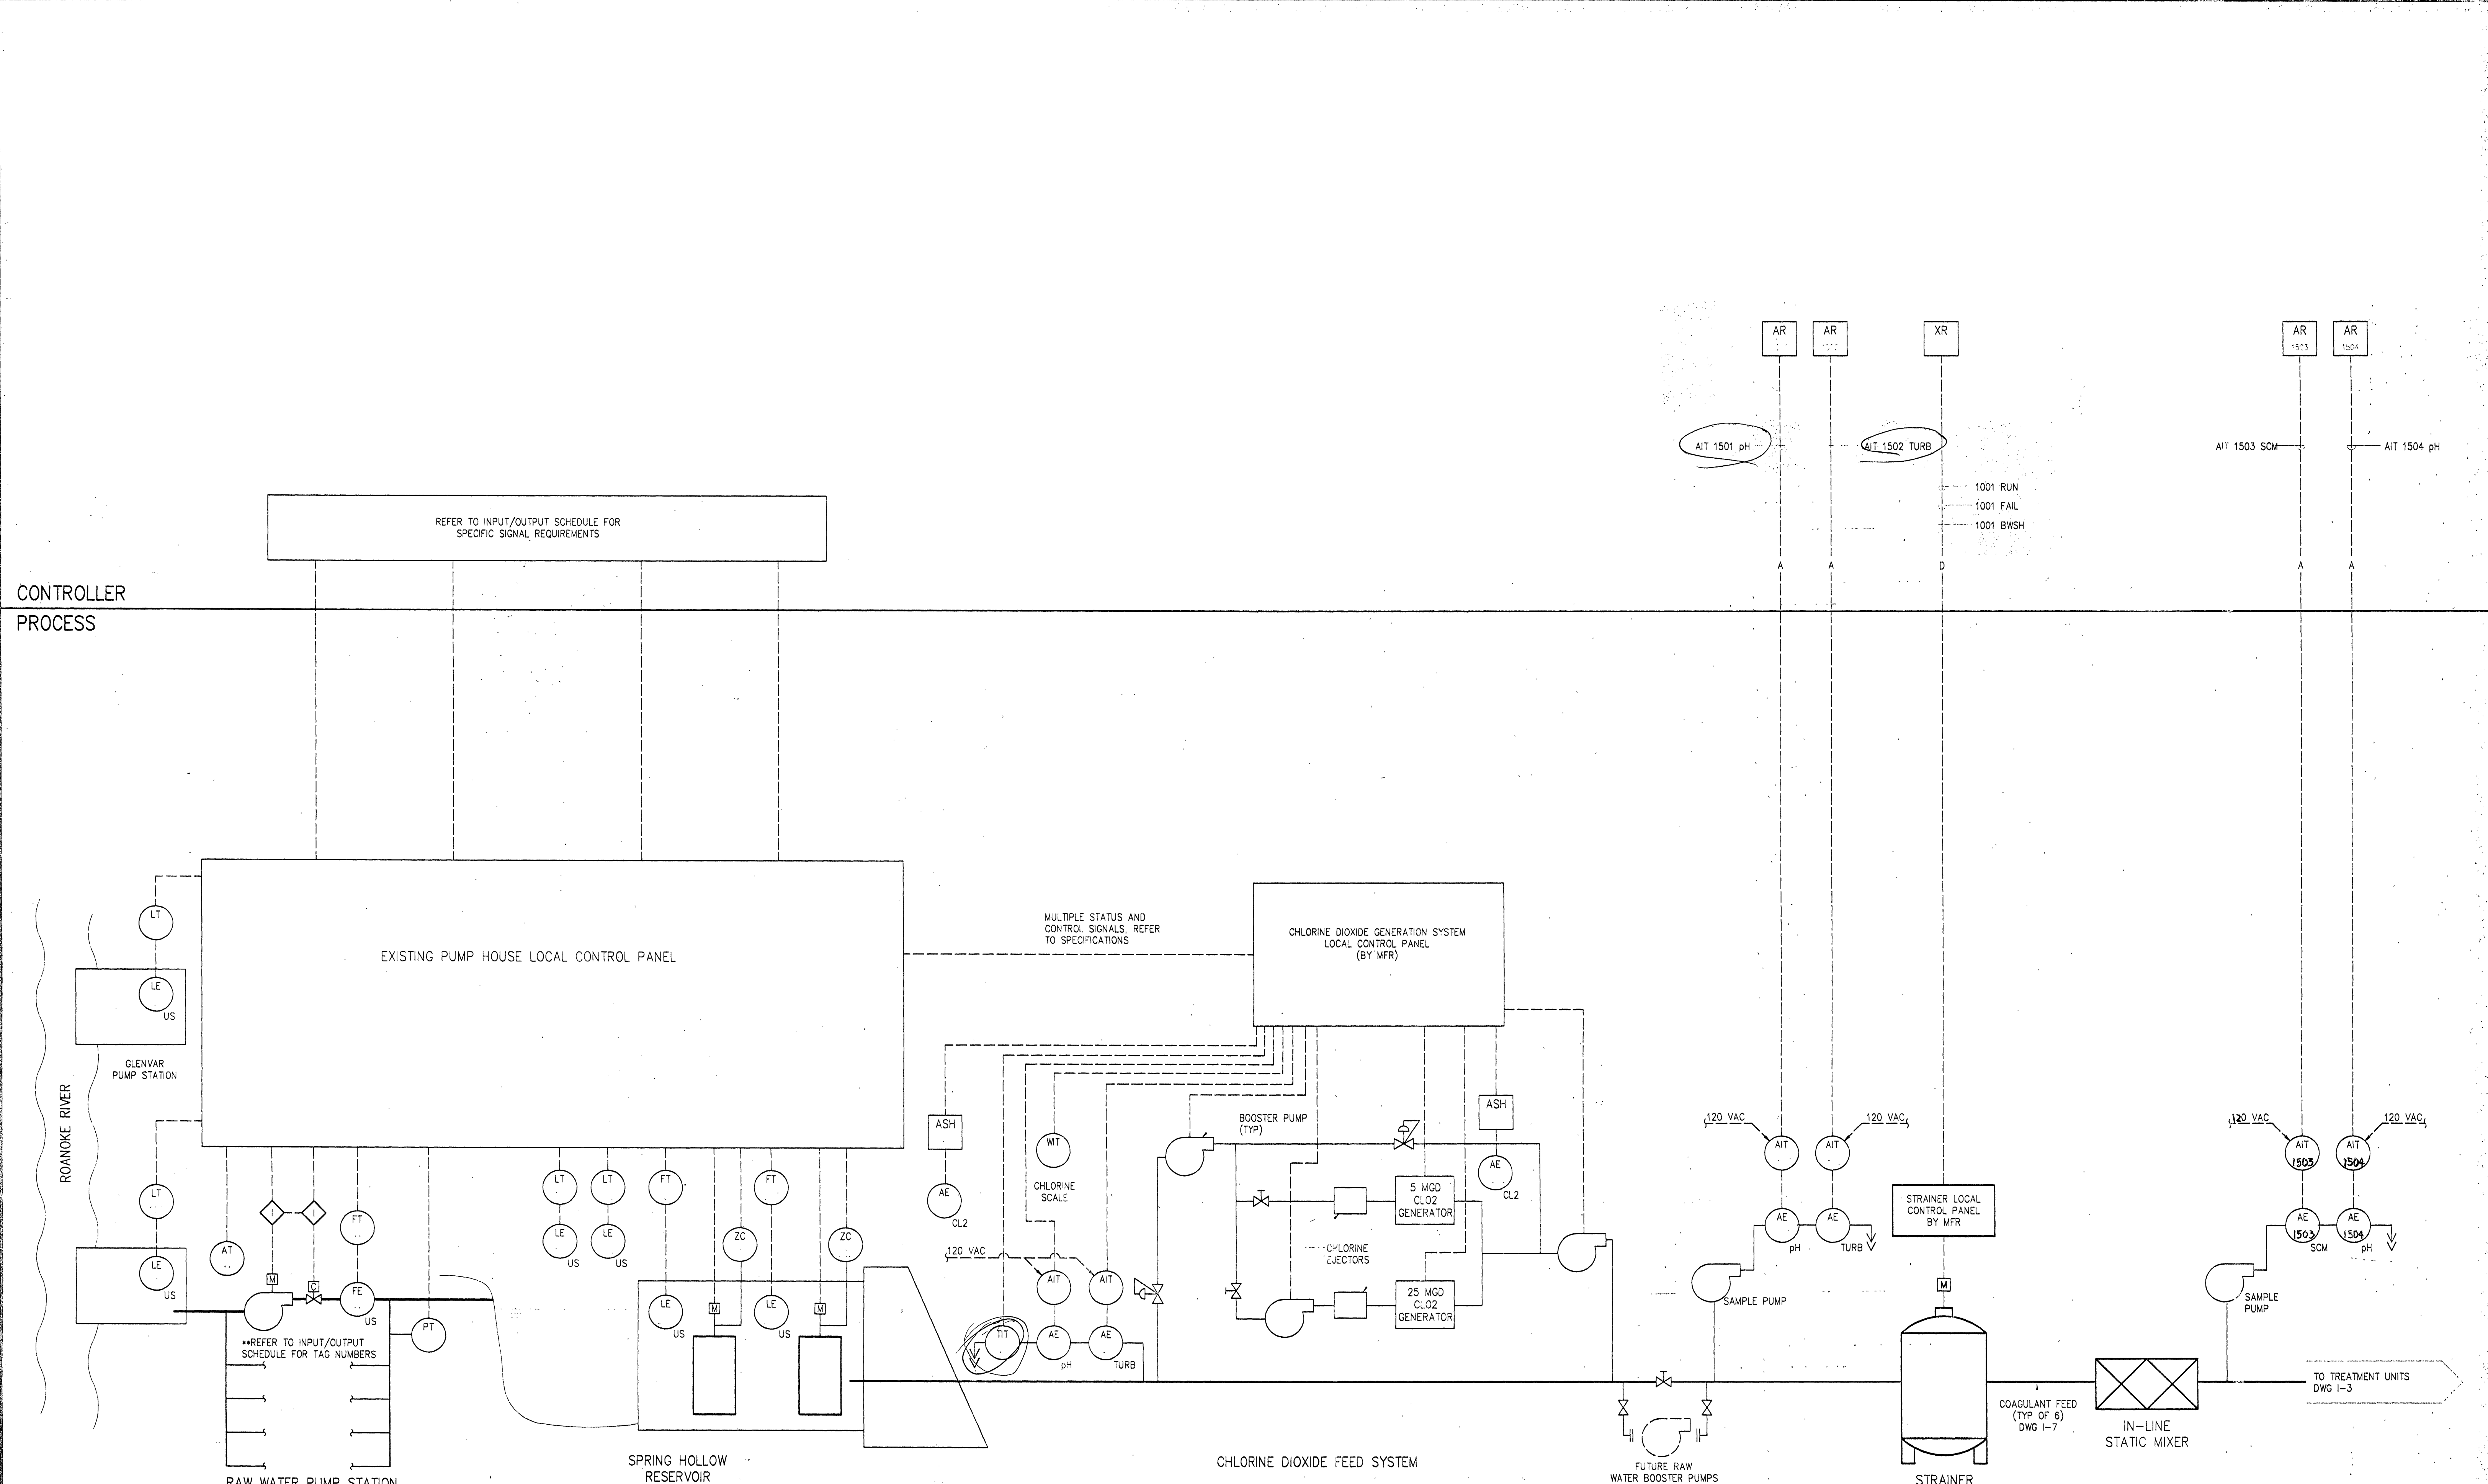


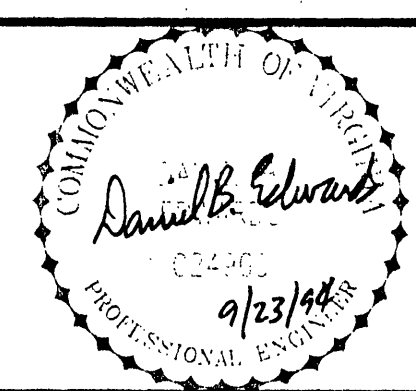

DESIGNED	DBE
DRAWN	AMD
CHECKED	DBE
PROJ. ENGR.	DBE
APPROVED	<i>[Signature]</i>
NO.	ISSUED FOR
2	CONSTRUCTION
1	REGULATORY APPROVAL
DATE	BY
9-23-94	DBE
8-9-94	DBE

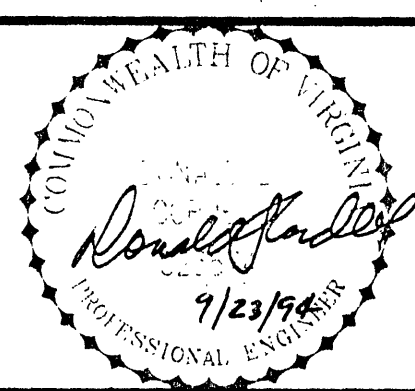

HAZEN AND SAWYER
Environmental Engineers & Scientists
RALEIGH, NC CHARLOTTE, NC RICHMOND, VA

ROANOKE COUNTY, VIRGINIA
UTILITY DEPARTMENT
WATER TREATMENT FACILITY

RAW WATER FEED
INSTRUMENTATION
PROCESS & INSTRUMENTATION DIAGRAM

THE SCALE BAR SHOWN BELOW MEASURES ONE INCH LONG ON THE ORIGINAL DRAWING.	DATE	SEPT 1994
	H & S JOB NUMBER	3276
	CONTRACT NUMBER	
	DRAWING NUMBER	1-2
	SHEET	OF