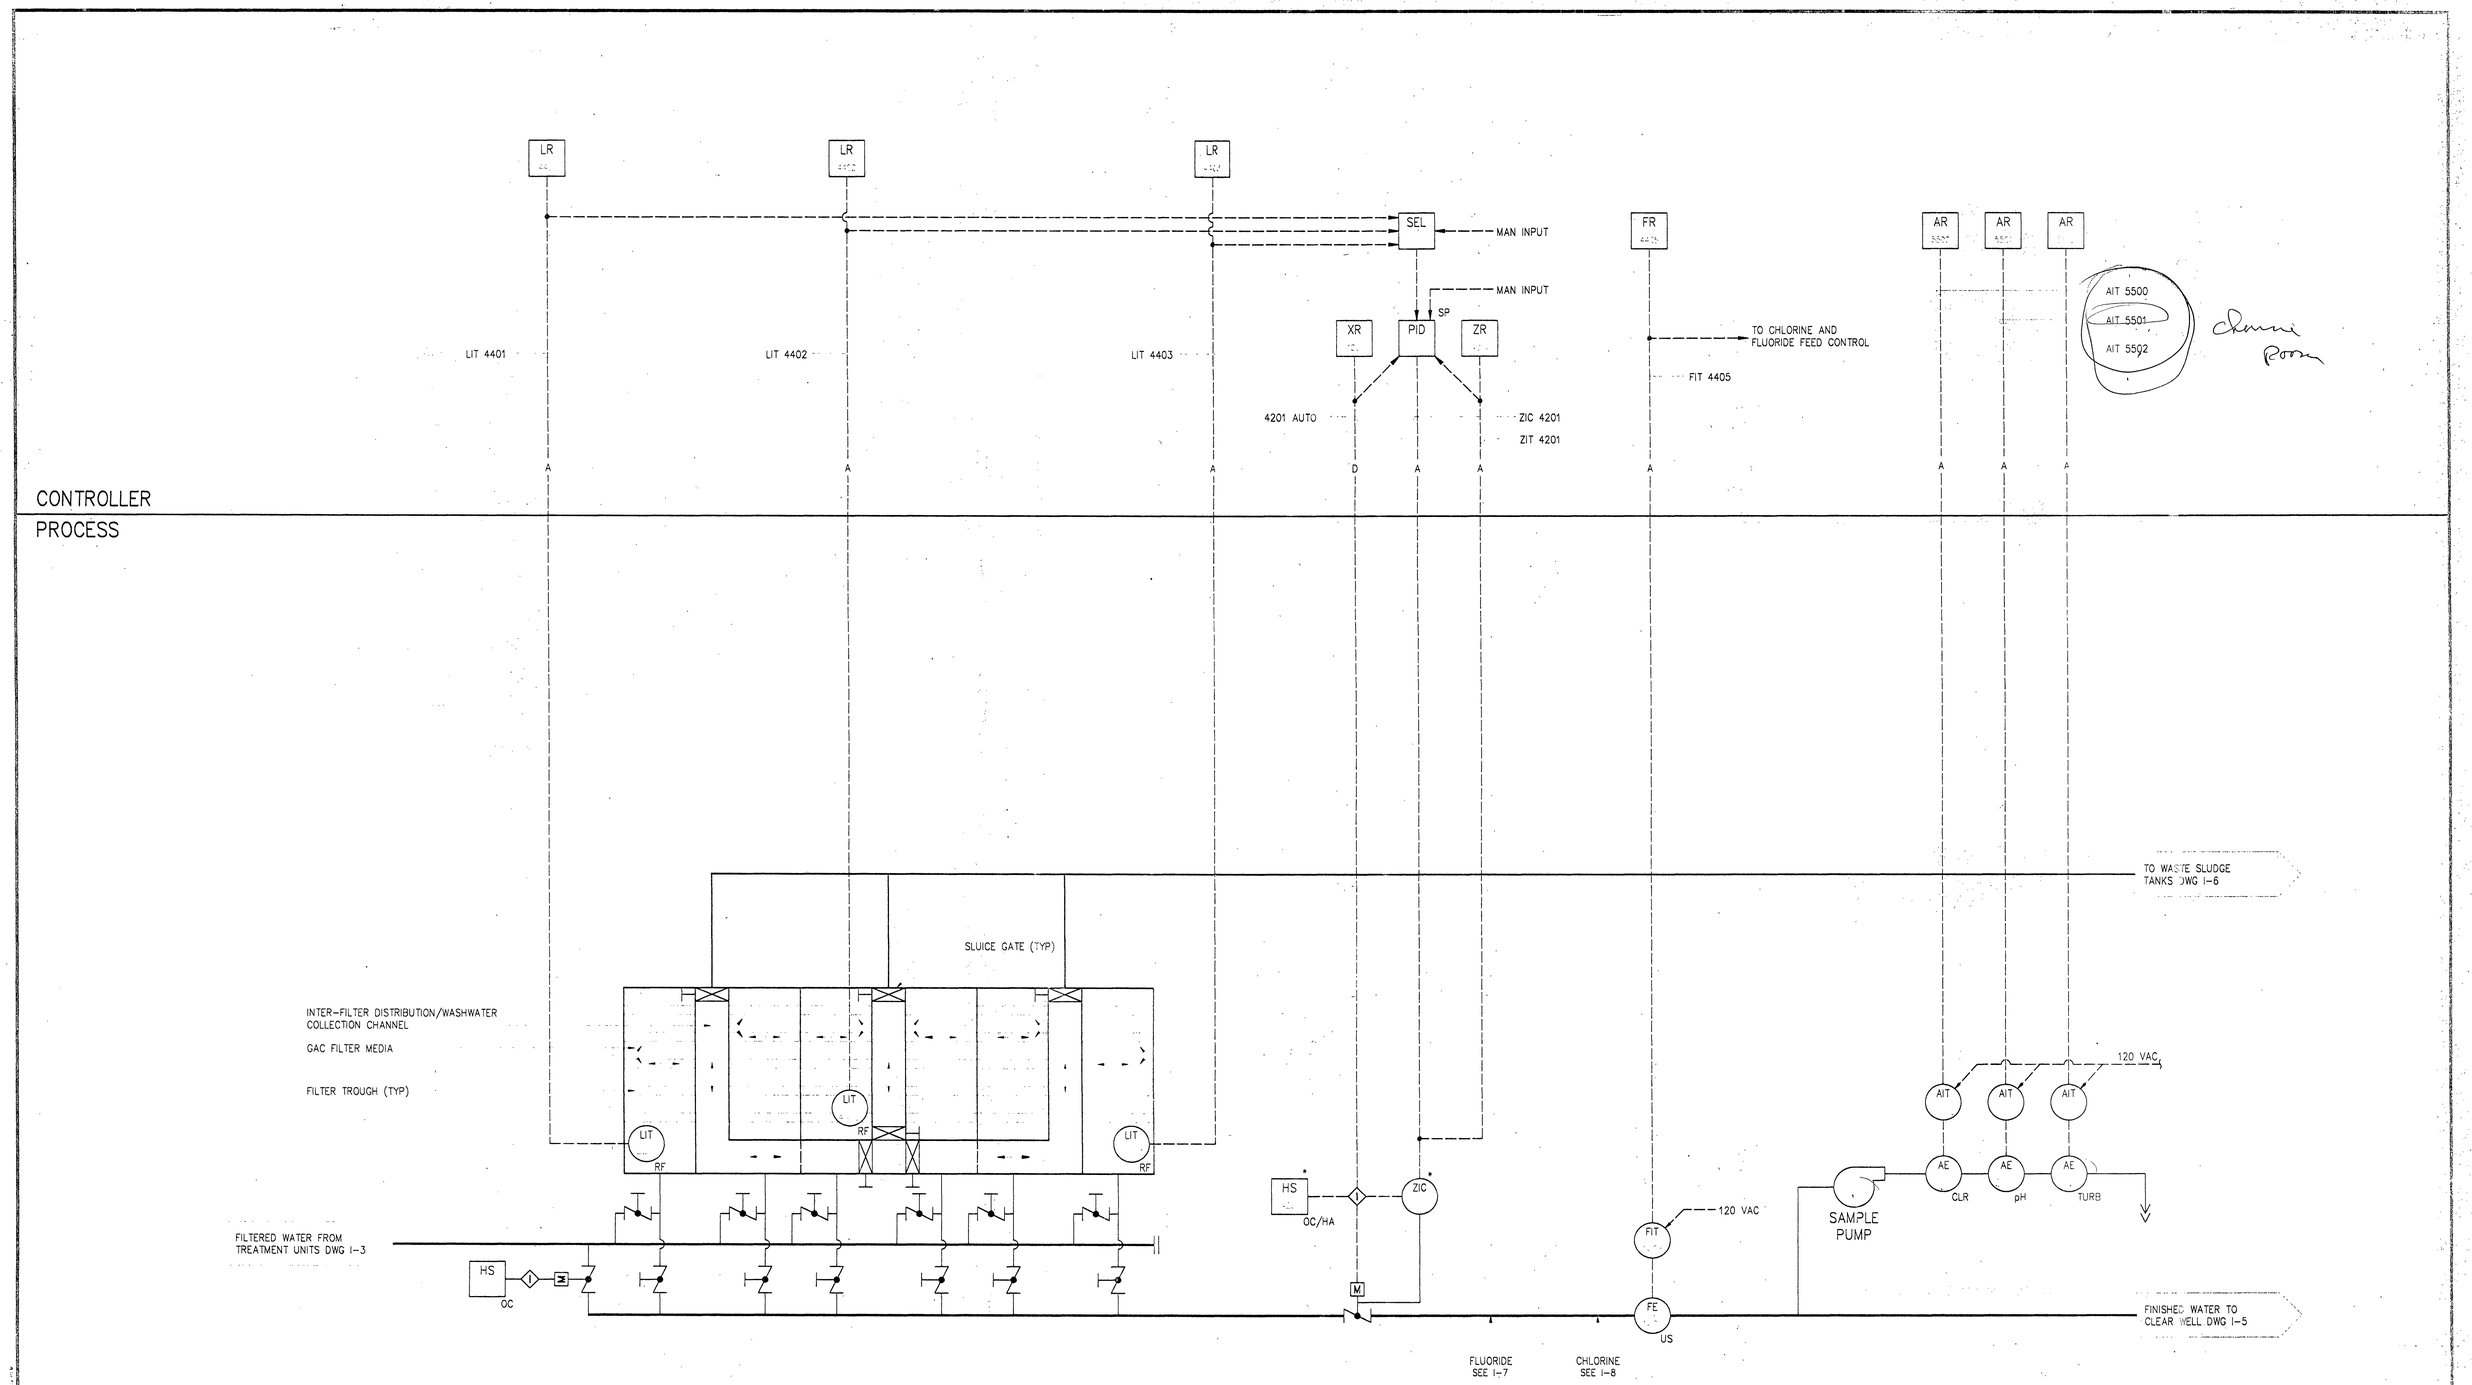

INSPECTOR'S AS-BUILTS 1995

WVWA ID# 6LDLUZ

NO.	ISSUED FOR	DATE	BY
2	CONSTRUCTION	9-23-94	DBE
1	REGULATORY APPROVAL	8-9-94	DBE

DESIGNED DBE
DRAWN AMD
CHECKED DBE
PROJ.ENGR. DBE
APPROVED

COMMONWEALTH OF VIRGINIA — PROFESSIONAL ENGINEER — 9/24/94

COMMONWEALTH OF VIRGINIA — PROFESSIONAL ENGINEER — 9/23/94

HAZEN AND SAWYER
Environmental Engineers & Scientists
RALEIGH, NC CHARLOTTE, NC RICHMOND, VA

ROANOKE COUNTY, VIRGINIA
UTILITY DEPARTMENT

WATER TREATMENT FACILITY

GAC CONTACTORS
INSTRUMENTATION
PROCESS & INSTRUMENTATION DIAGRAM

THE SCALE BAR SHOWN BELOW MEASURES ONE INCH LONG ON THE ORIGINAL DRAWING.

DATE SEPT 1994
H & S JOB NUMBER 3276
CONTRACT NUMBER
DRAWING NUMBER I-4
SHEET OF