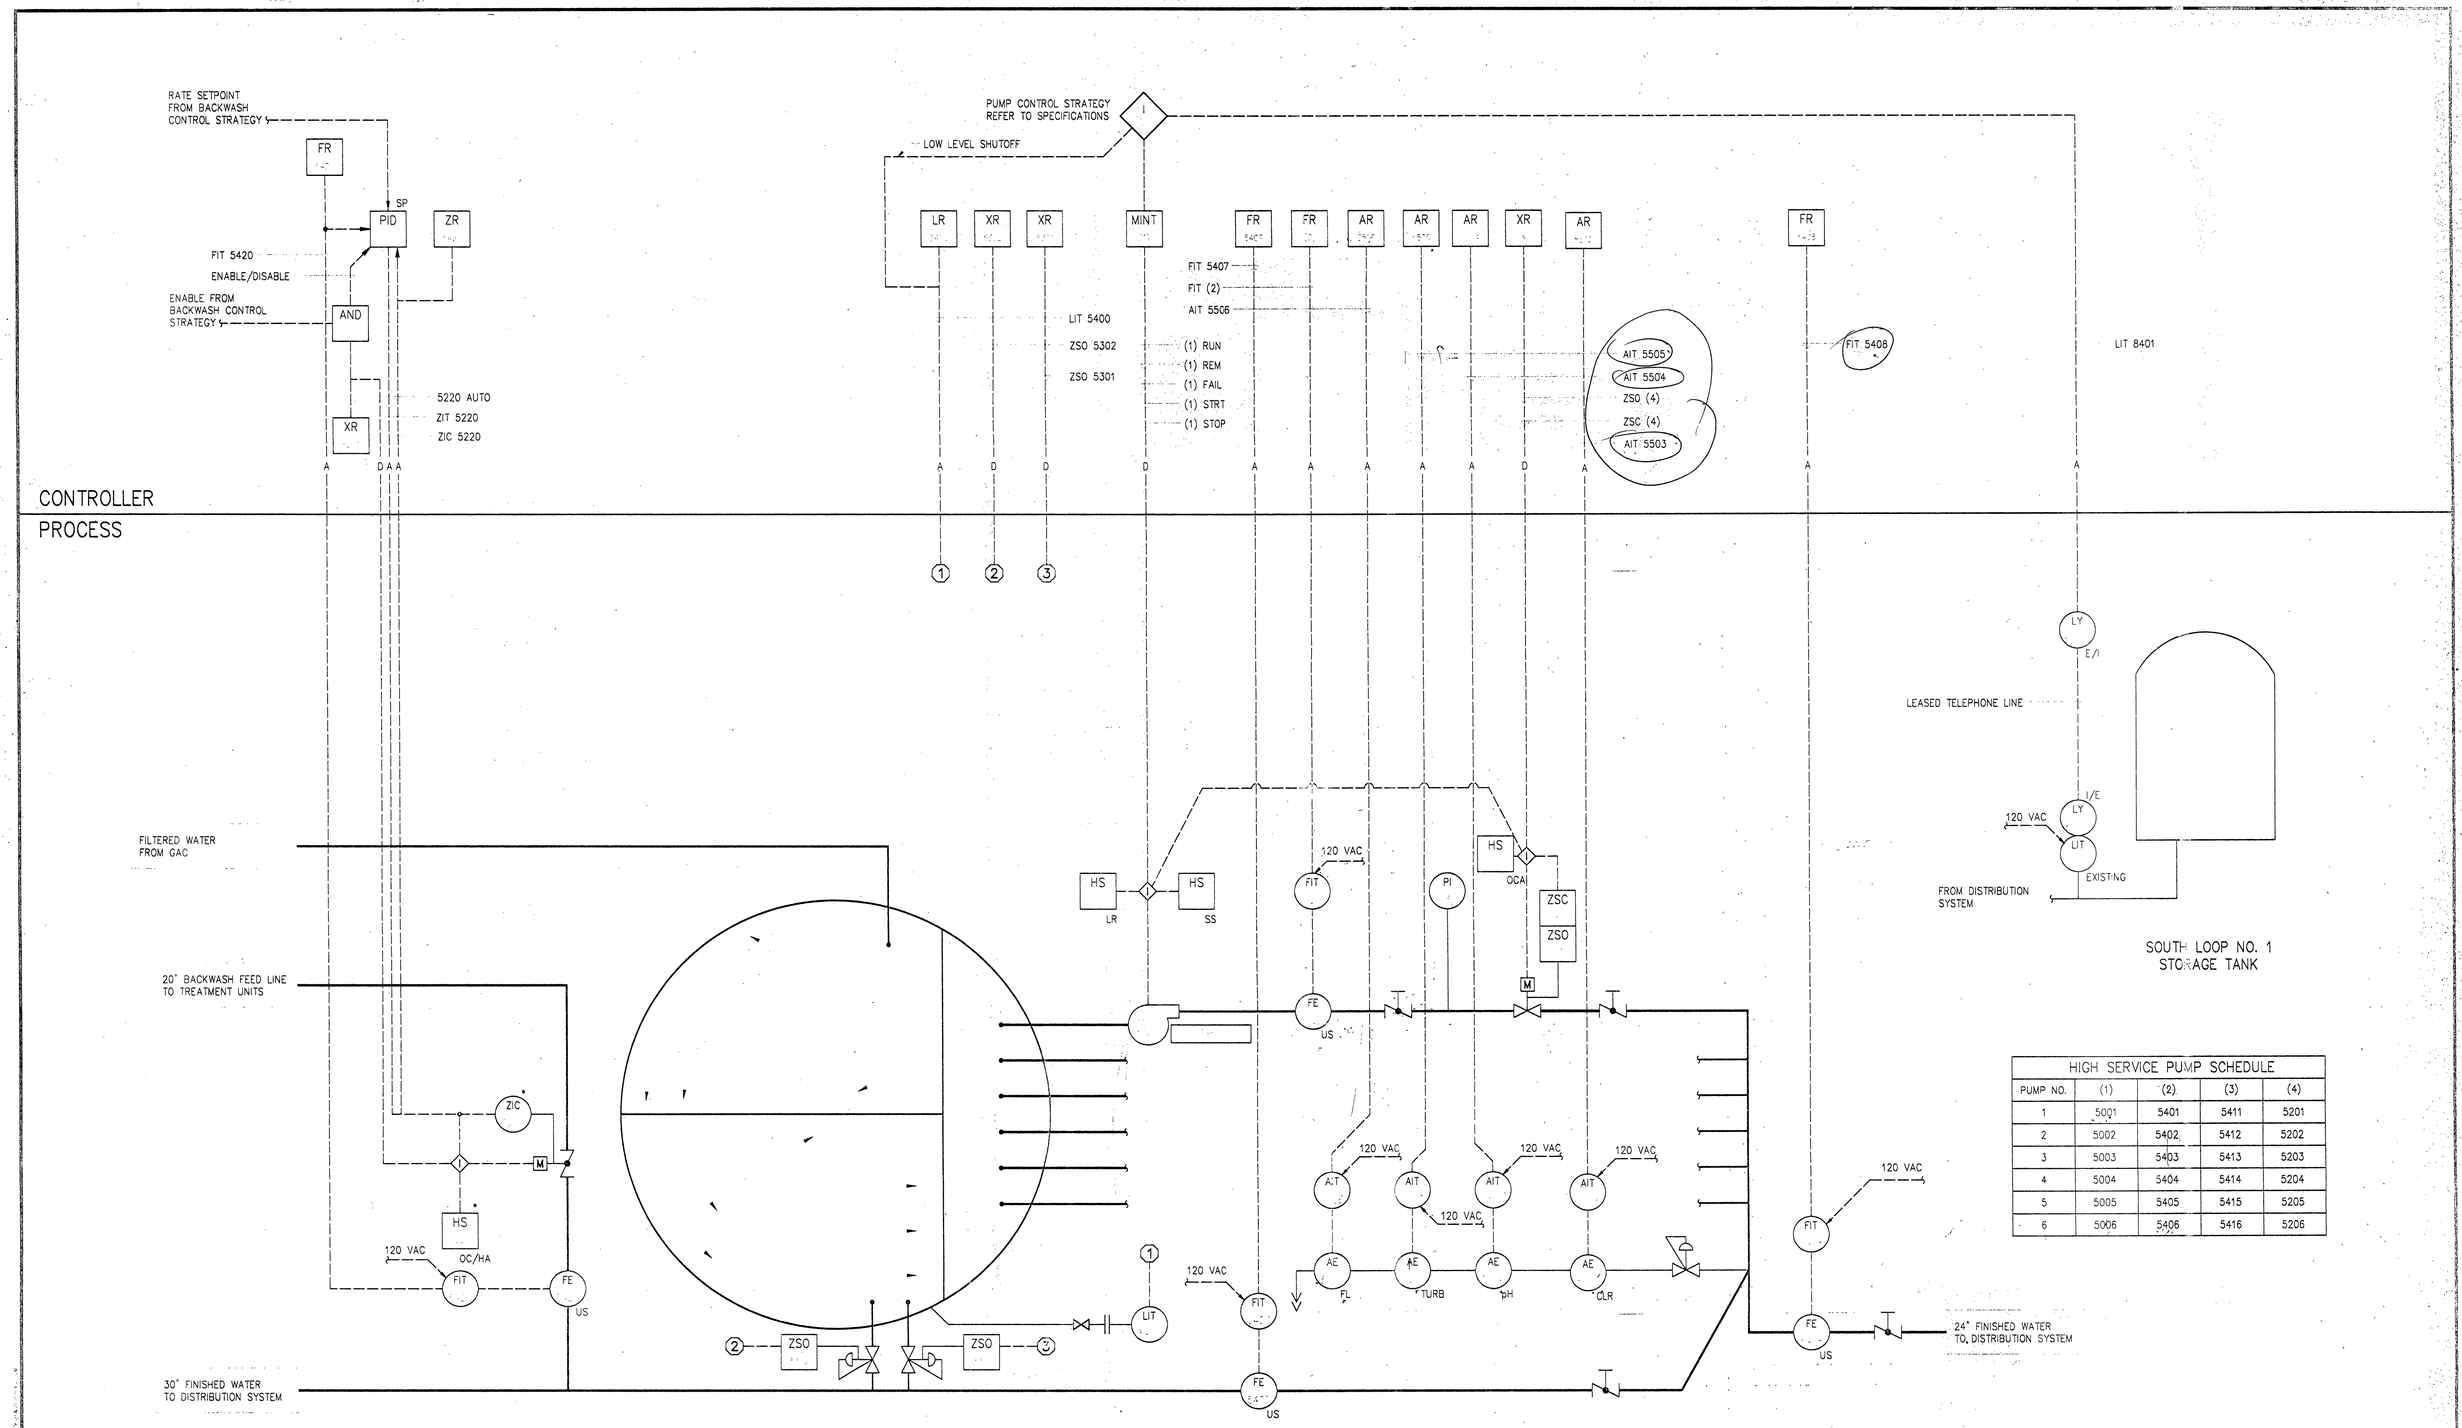

HIGH SERVICE PUMP SCHEDULE				
PUMP NO.	(1)	(2)	(3)	(4)
1	5001	5401	5411	5201
2	5002	5402	5412	5202
3	5003	5403	5413	5203
4	5004	5404	5414	5204
5	5005	5405	5415	5205
6	5006	5406	5416	5206

INSPECTOR'S AS-BUILTS 1995

WVWA ID# 8LDLUZ

NO.	ISSUED FOR	DATE	BY
2	CONSTRUCTION	9-23-94	DBE
1	REGULATORY APPROVAL	8-9-94	DBE

DESIGNED DBE
DRAWN AMD
CHECKED DBE
PROJ.ENGR. DBE
APPROVED

COMMONWEALTH OF VIRGINIA 9/23/94 PROFESSIONAL ENGINEER

COMMONWEALTH OF VIRGINIA 9/23/94 PROFESSIONAL ENGINEER

HAZEN AND SAWYER
Environmental Engineers & Scientists
RALEIGH, NC CHARLOTTE, NC RICHMOND, VA

ROANOKE COUNTY, VIRGINIA
UTILITY DEPARTMENT

WATER TREATMENT FACILITY

CLEAR WELL AND HIGH SERVICE PUMPS INSTUMENTATION
PROCESS & INSTRUMENTATION DIAGRAM

THE SCALE BAR SHOWN BELOW MEASURES ONE INCH LONG ON THE ORIGINAL DRAWING.

DATE SEPT 1994
H & S JOB NUMBER 3276
CONTRACT NUMBER
DRAWING NUMBER I-5
SHEET OF