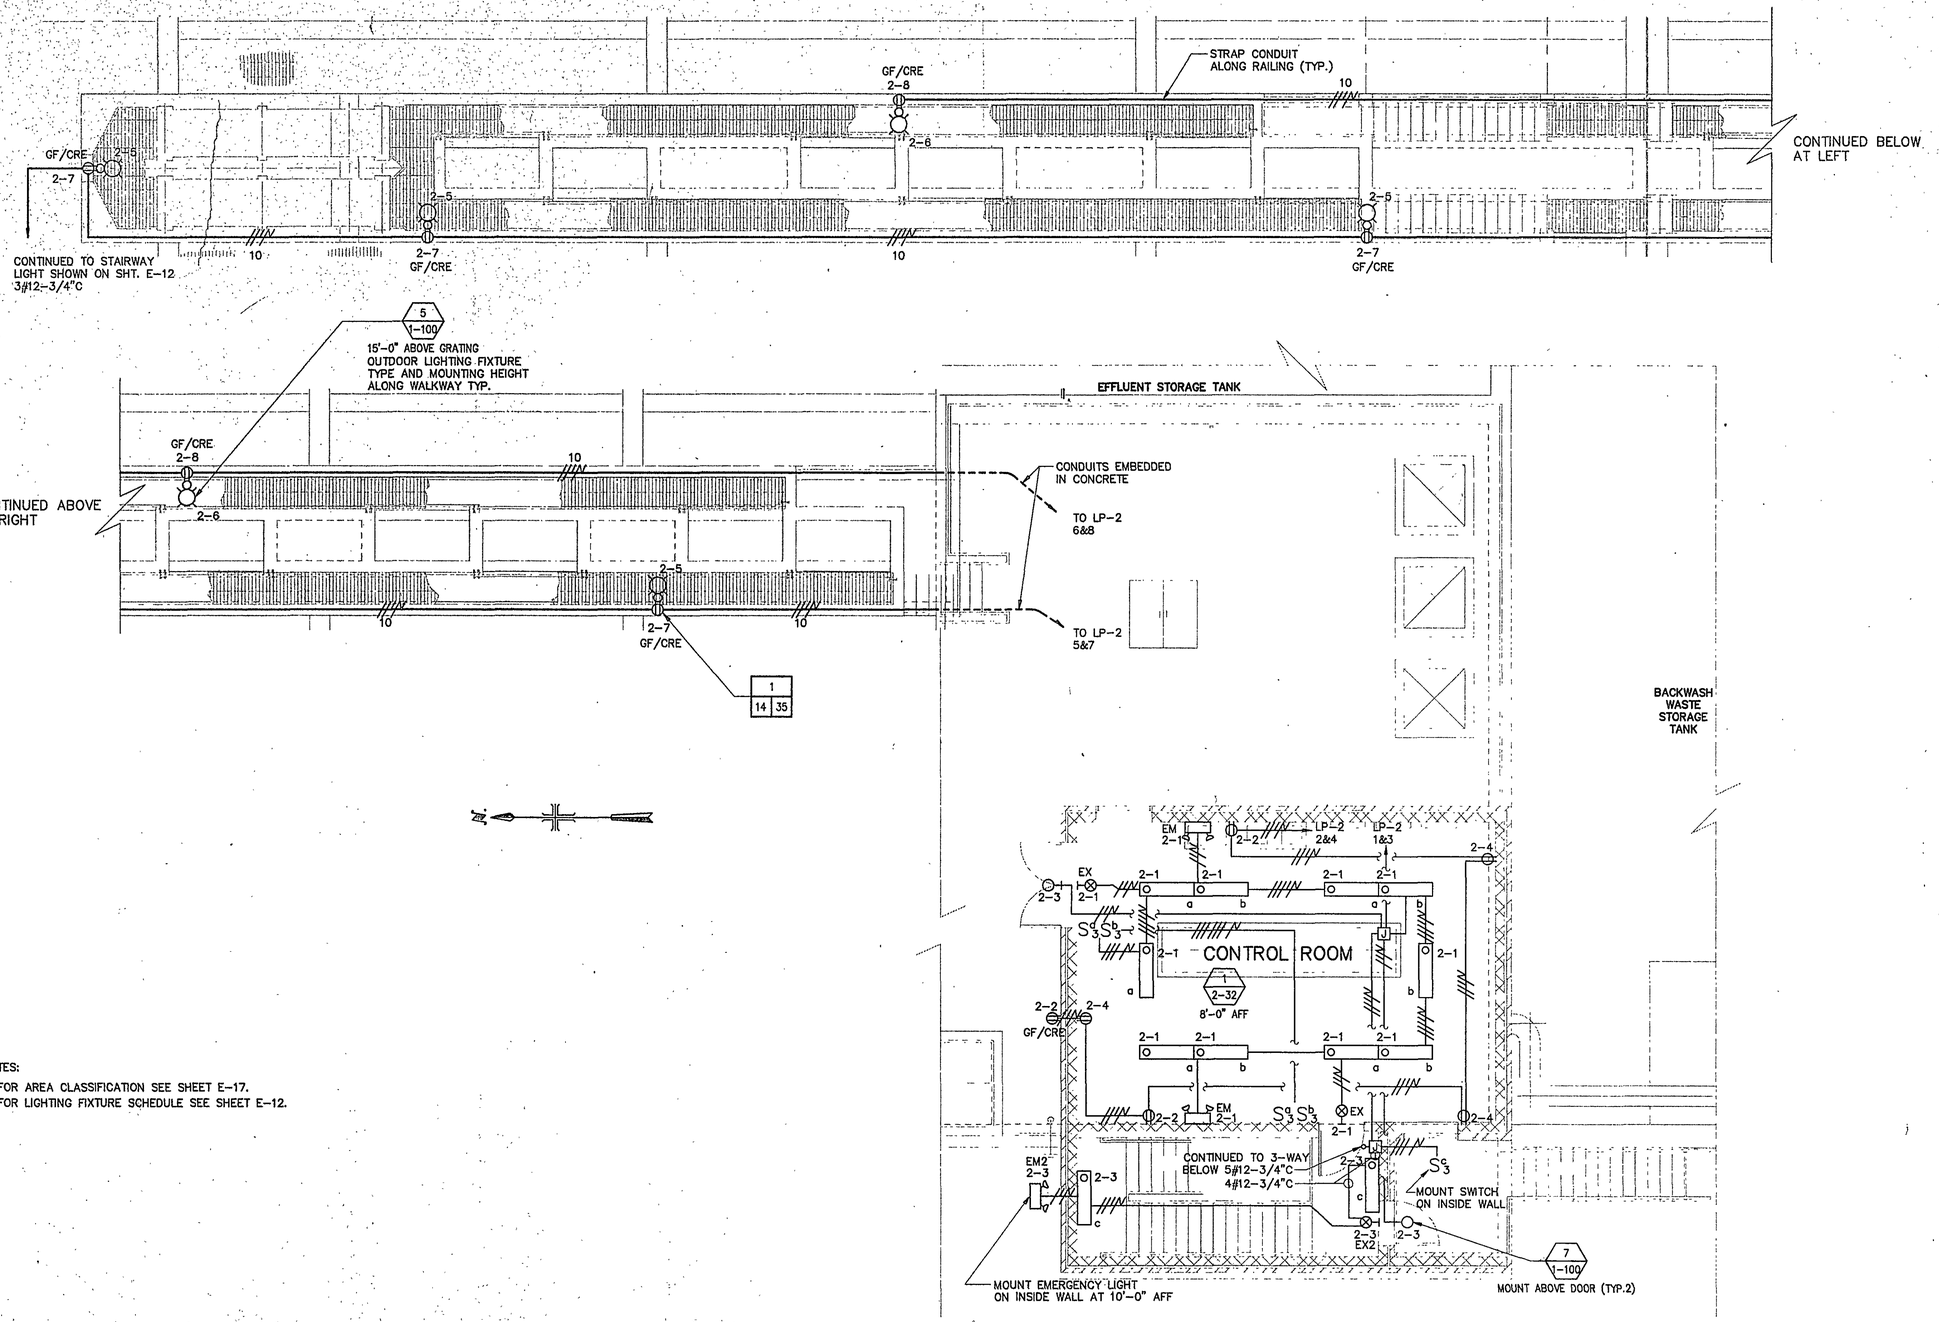

NOTES:

1. FOR AREA CLASSIFICATION SEE SHEET E-17.
2. FOR LIGHTING FIXTURE SCHEDULE SEE SHEET E-12.

RECORD DRAWINGS

COMMONWEALTH OF VIRGINIA
TADEUSZ L. KOZIOL
No. 030171
5/6/97
PROFESSIONAL ENGINEER

MALCOLM PIRNIE
11832 Rock Landing Drive, Suite 400
Newport News, Virginia 23606

REVISIONS			
NO.	BY	DATE	REMARKS

DES KLL
DWN KLL
CKD TK

ROANOKE VIRGINIA, CHARTERED 1882

CITY OF ROANOKE, VIRGINIA
WATER POLLUTION CONTROL PLANT UPGRADE AND EXPANSION

BIOLOGICAL AERATED FILTER
UPPER LEVEL LIGHTING PLAN

3/16"=1'-0"

COPYRIGHT © 1997 MALCOLM PIRNIE, INC.

DATE MAY 1997
E SHEET 14 OF 36
CAD REF. NO. 0060E689