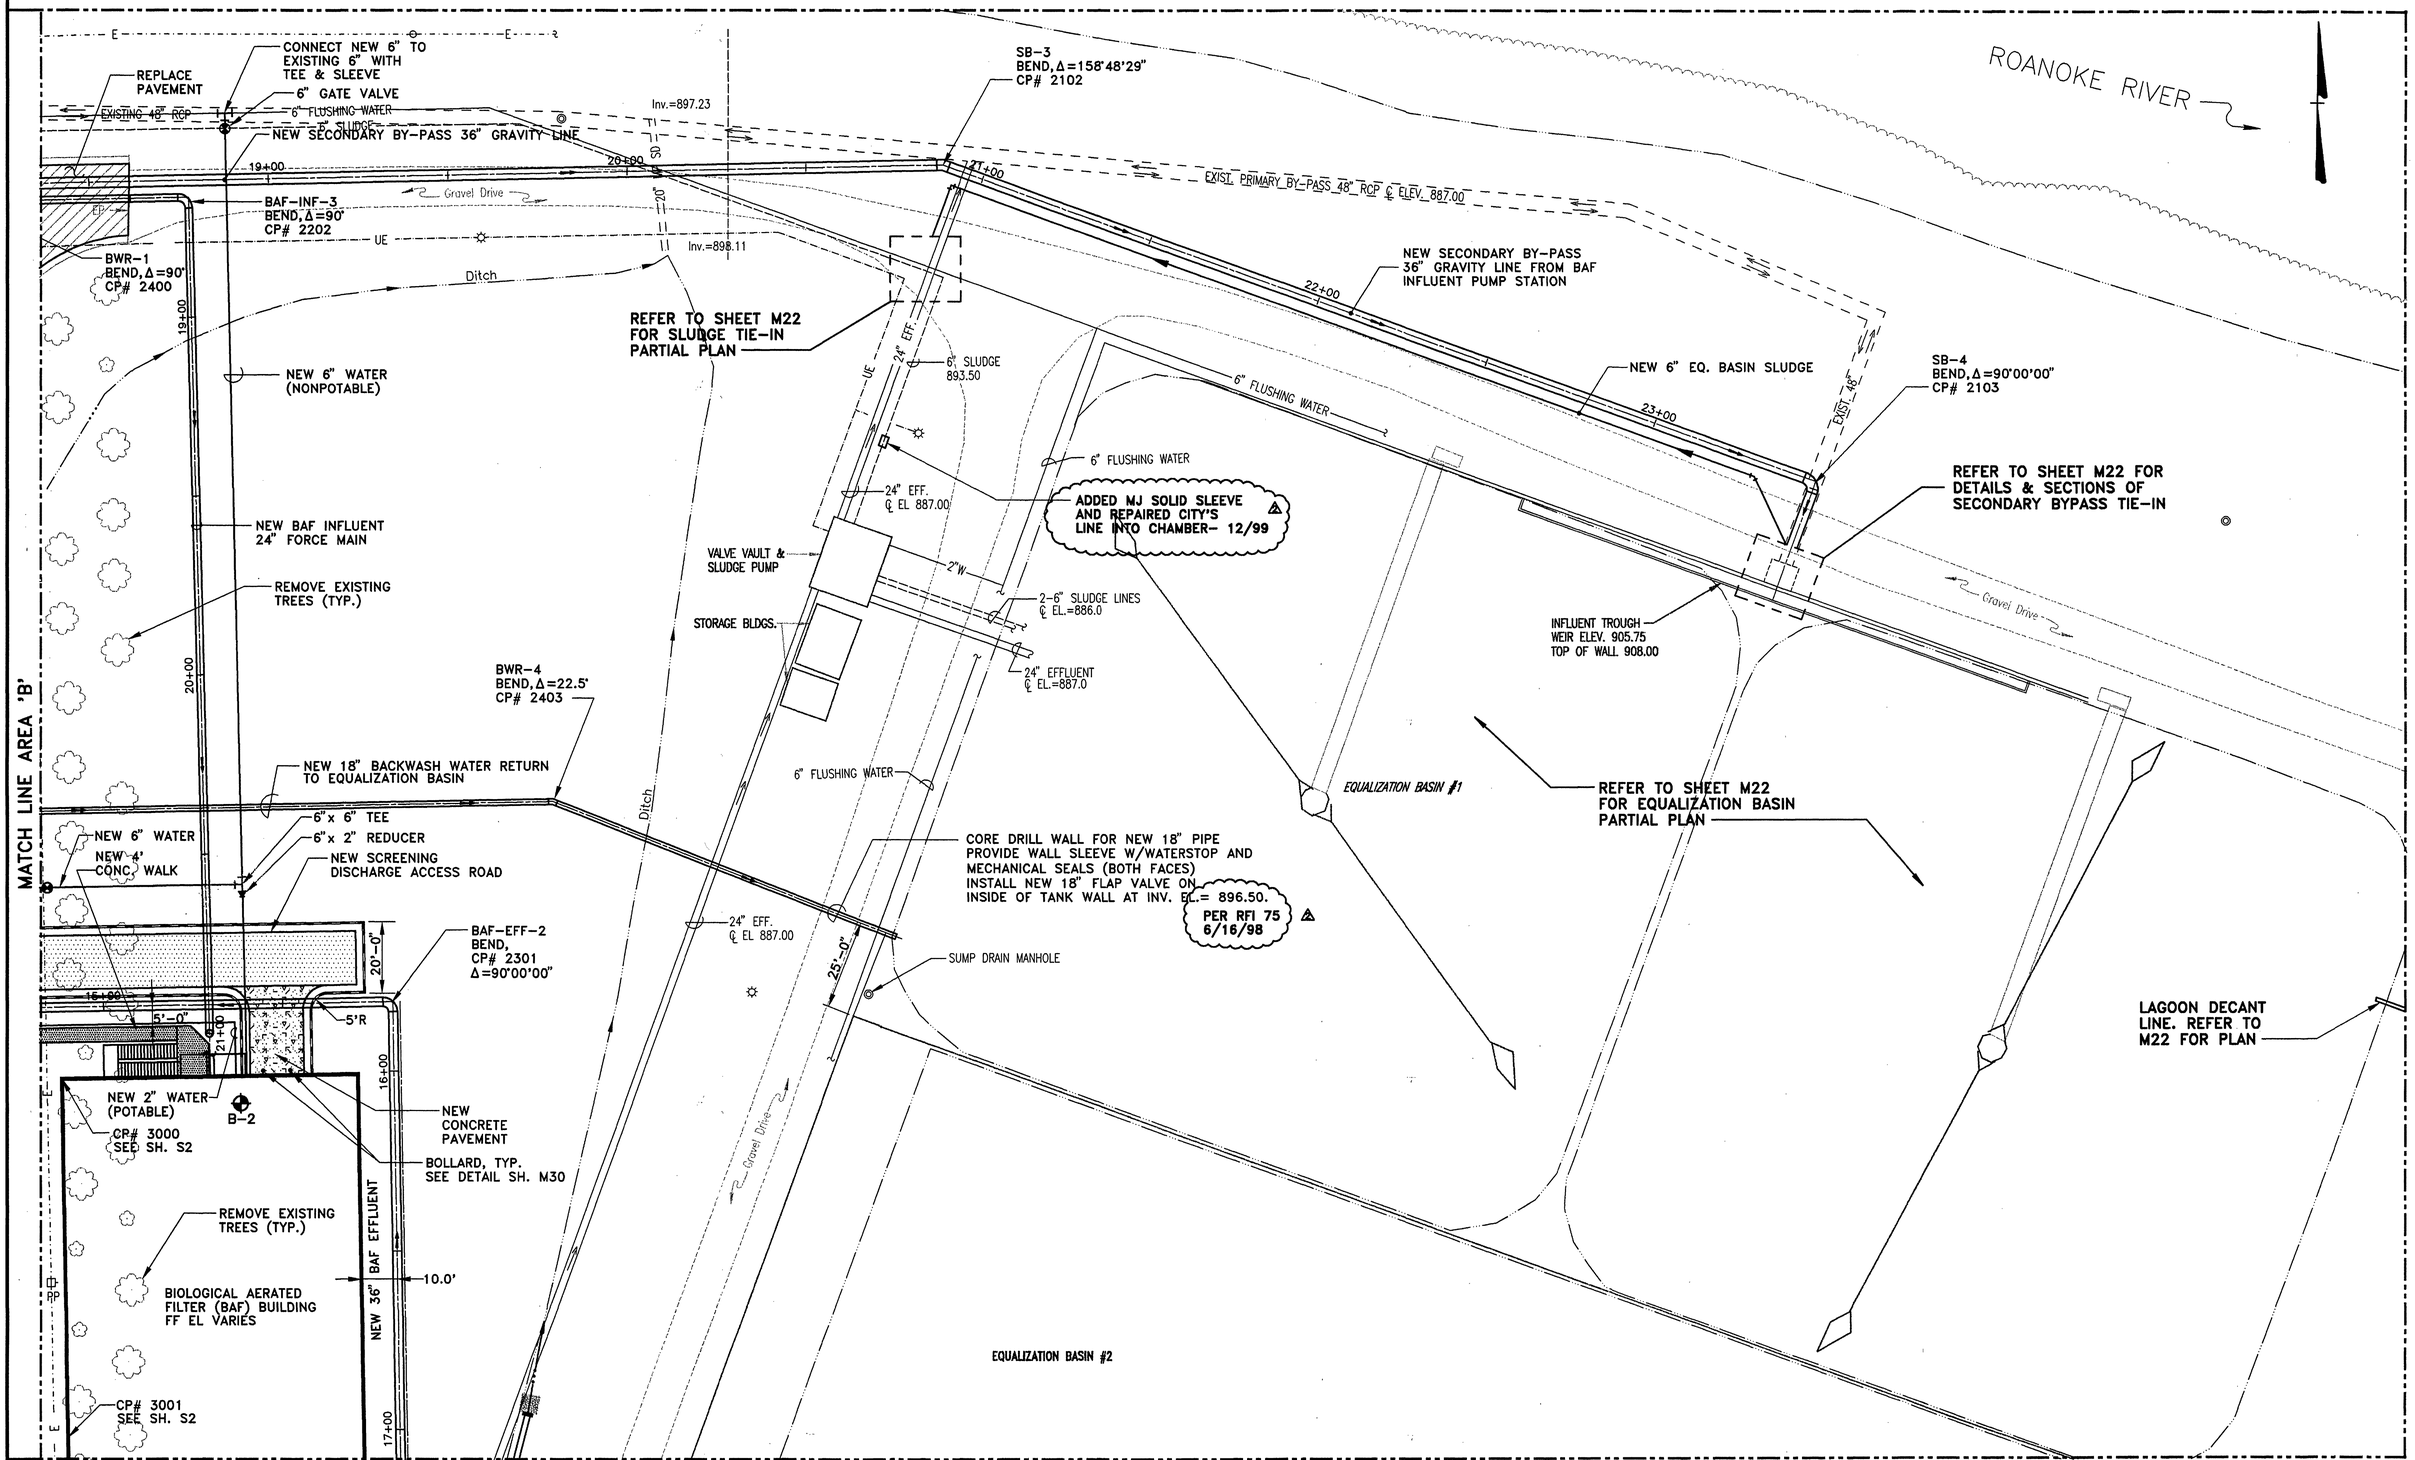

COMMONWEALTH OF VIRGINIA
STEWART W. HUBBELL
NO. 07420
PROFESSIONAL ENGINEER

Mattern & Craig, Inc.
CONSULTING ENGINEERS • SURVEYORS
701 FIRST STREET, S.W.
ROANOKE, VIRGINIA 24016
(540) 342-6945
(540) 342-7992 FAX

REVISIONS

NO.	BY	DATE	REMARKS
1	SWH	2/12/98	REVISED YARD PIPING
2	ARB	JAN. 2000	RECORD DRAWING

DES WTA
DWN LDL,ARB
CKD SWH

ROANOKE
VIRGINIA, CHARTERED 1882

CITY OF ROANOKE, VIRGINIA
WATER POLLUTION CONTROL PLANT UPGRADE AND EXPANSION

SITE PLAN
LAYOUT, YARD PIPING, AND UTILITIES
AREA 'C'
1"=20'

DATE MAY,1997
G SHEET 6 OF 23
CAD REF. NO. G6.DWG

R:\dwgs\13BB\dwg\G6.dwg Thu Feb 03 20:31:52 2000