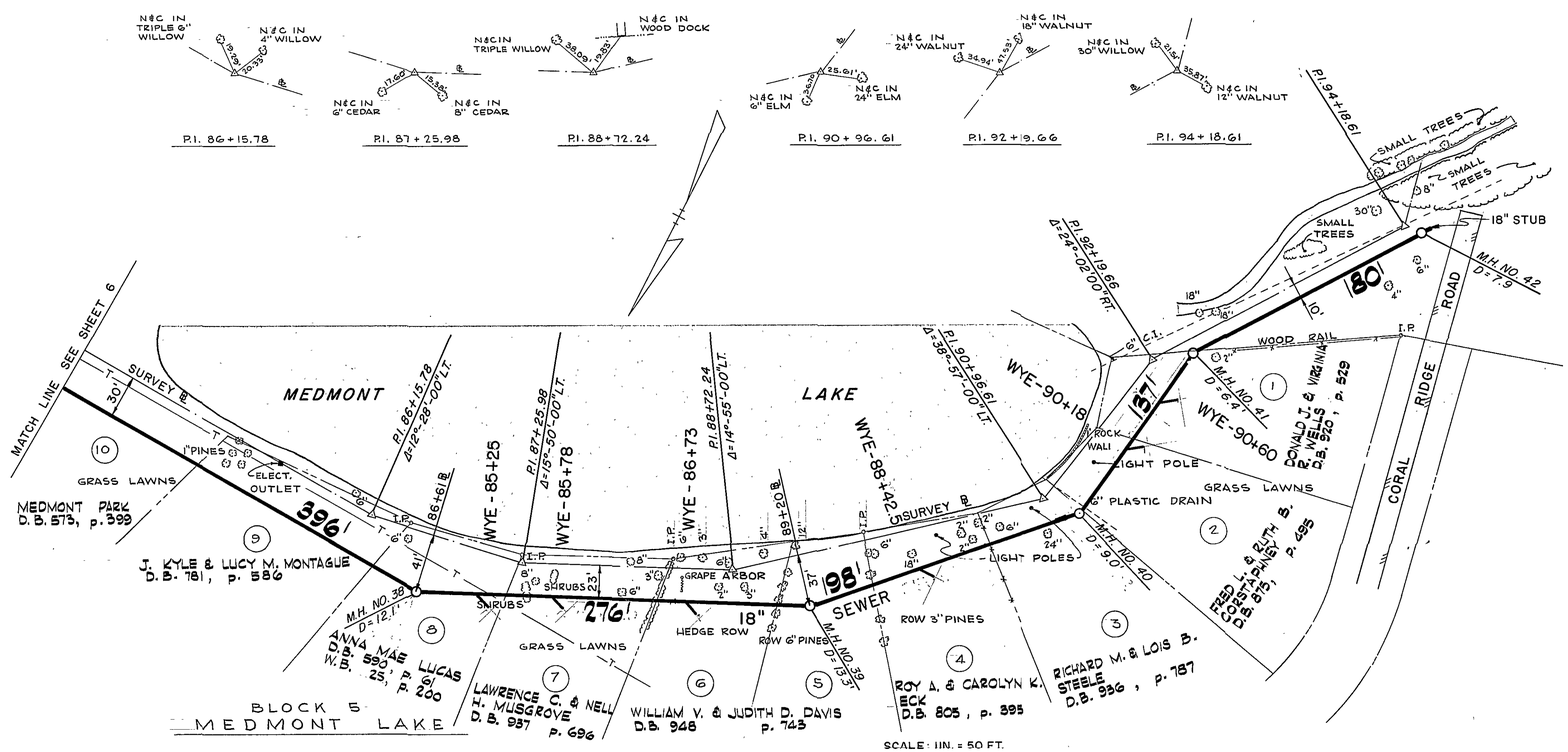

AS BUILT

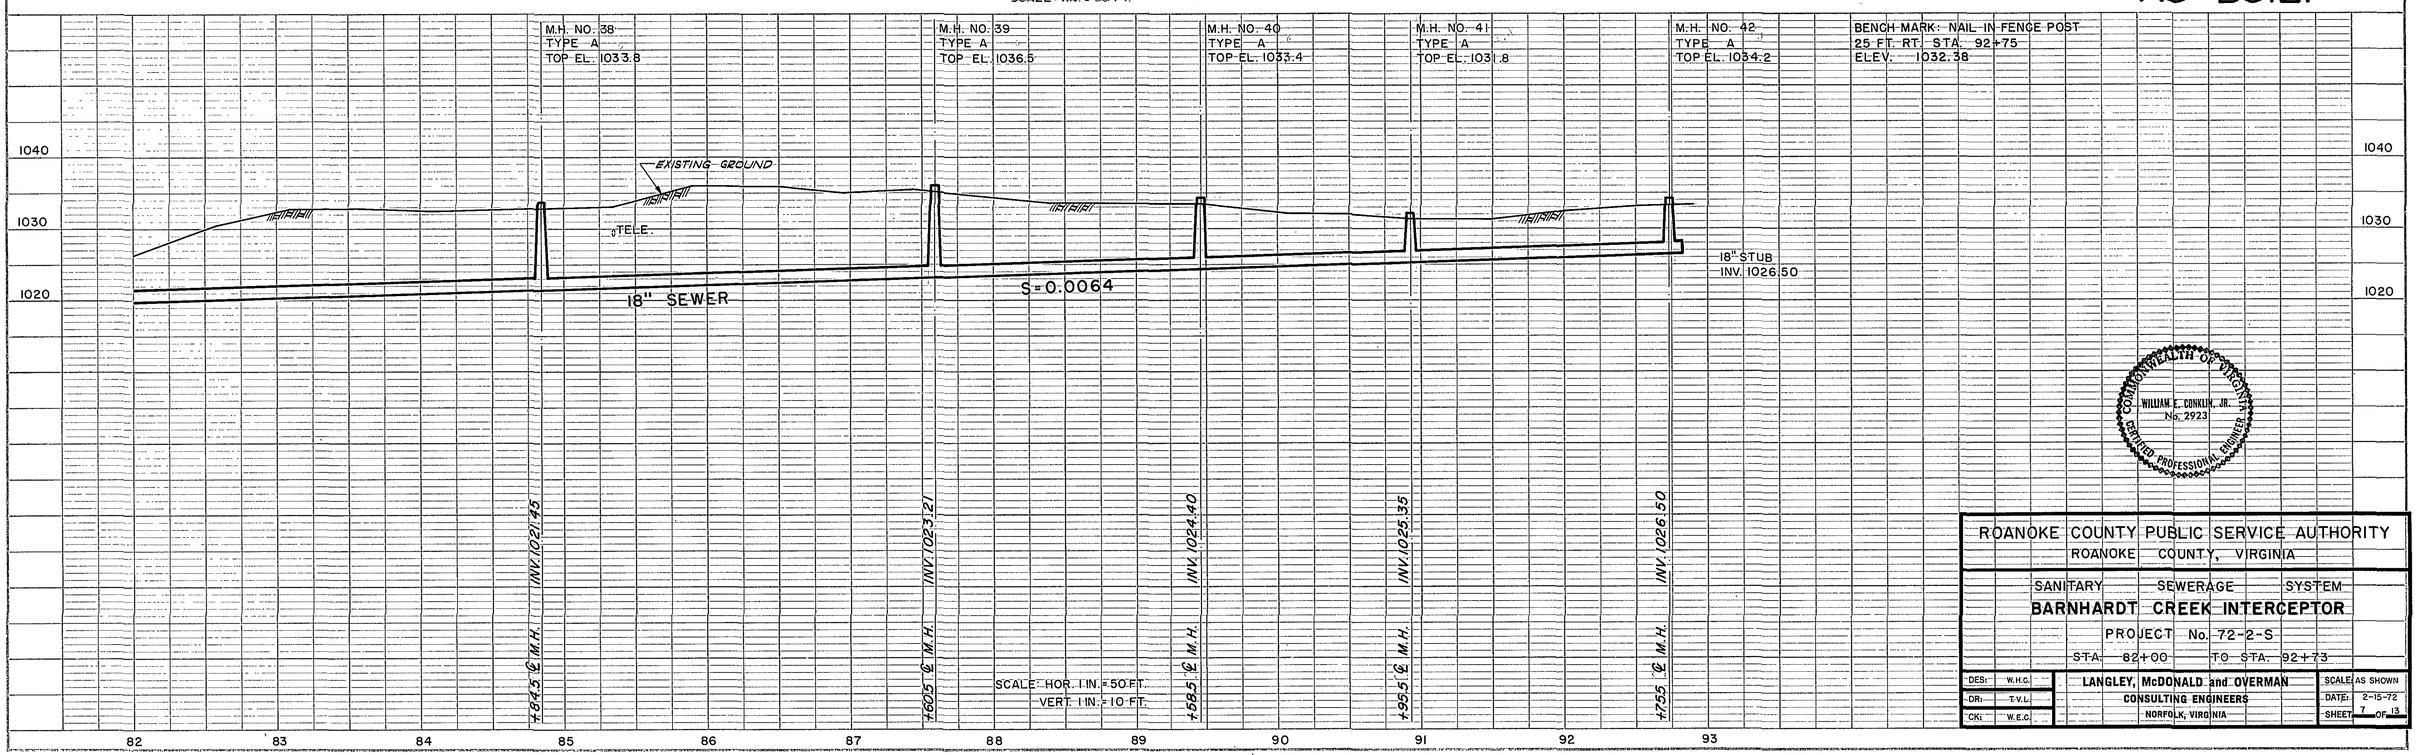

COMMONWEALTH OF VIRGINIA
WILLIAM E. CONKLIN, JR.
No. 2923
CERTIFIED PROFESSIONAL ENGINEER

ROANOKE COUNTY PUBLIC SERVICE AUTHORITY
ROANOKE COUNTY, VIRGINIA

SANITARY SEWERAGE SYSTEM
BARNHARDT CREEK INTERCEPTOR
PROJECT No. 72-2-S
STA. 82+00 TO STA. 92+73

DES: W.H.C.	LANGLEY, McDONALD and OVERMAN	SCALE:	AS SHOWN
DR: T.V.L.	CONSULTING ENGINEERS	DATE:	2-15-72
CK: W.E.C.	NORFOLK, VIRGINIA	SHEET	7 OF 13

PLATE 1, PLAN-PROFILE
KEUFFEL & ESSER CO.
48 7008 MADE IN U.S.A.

3446