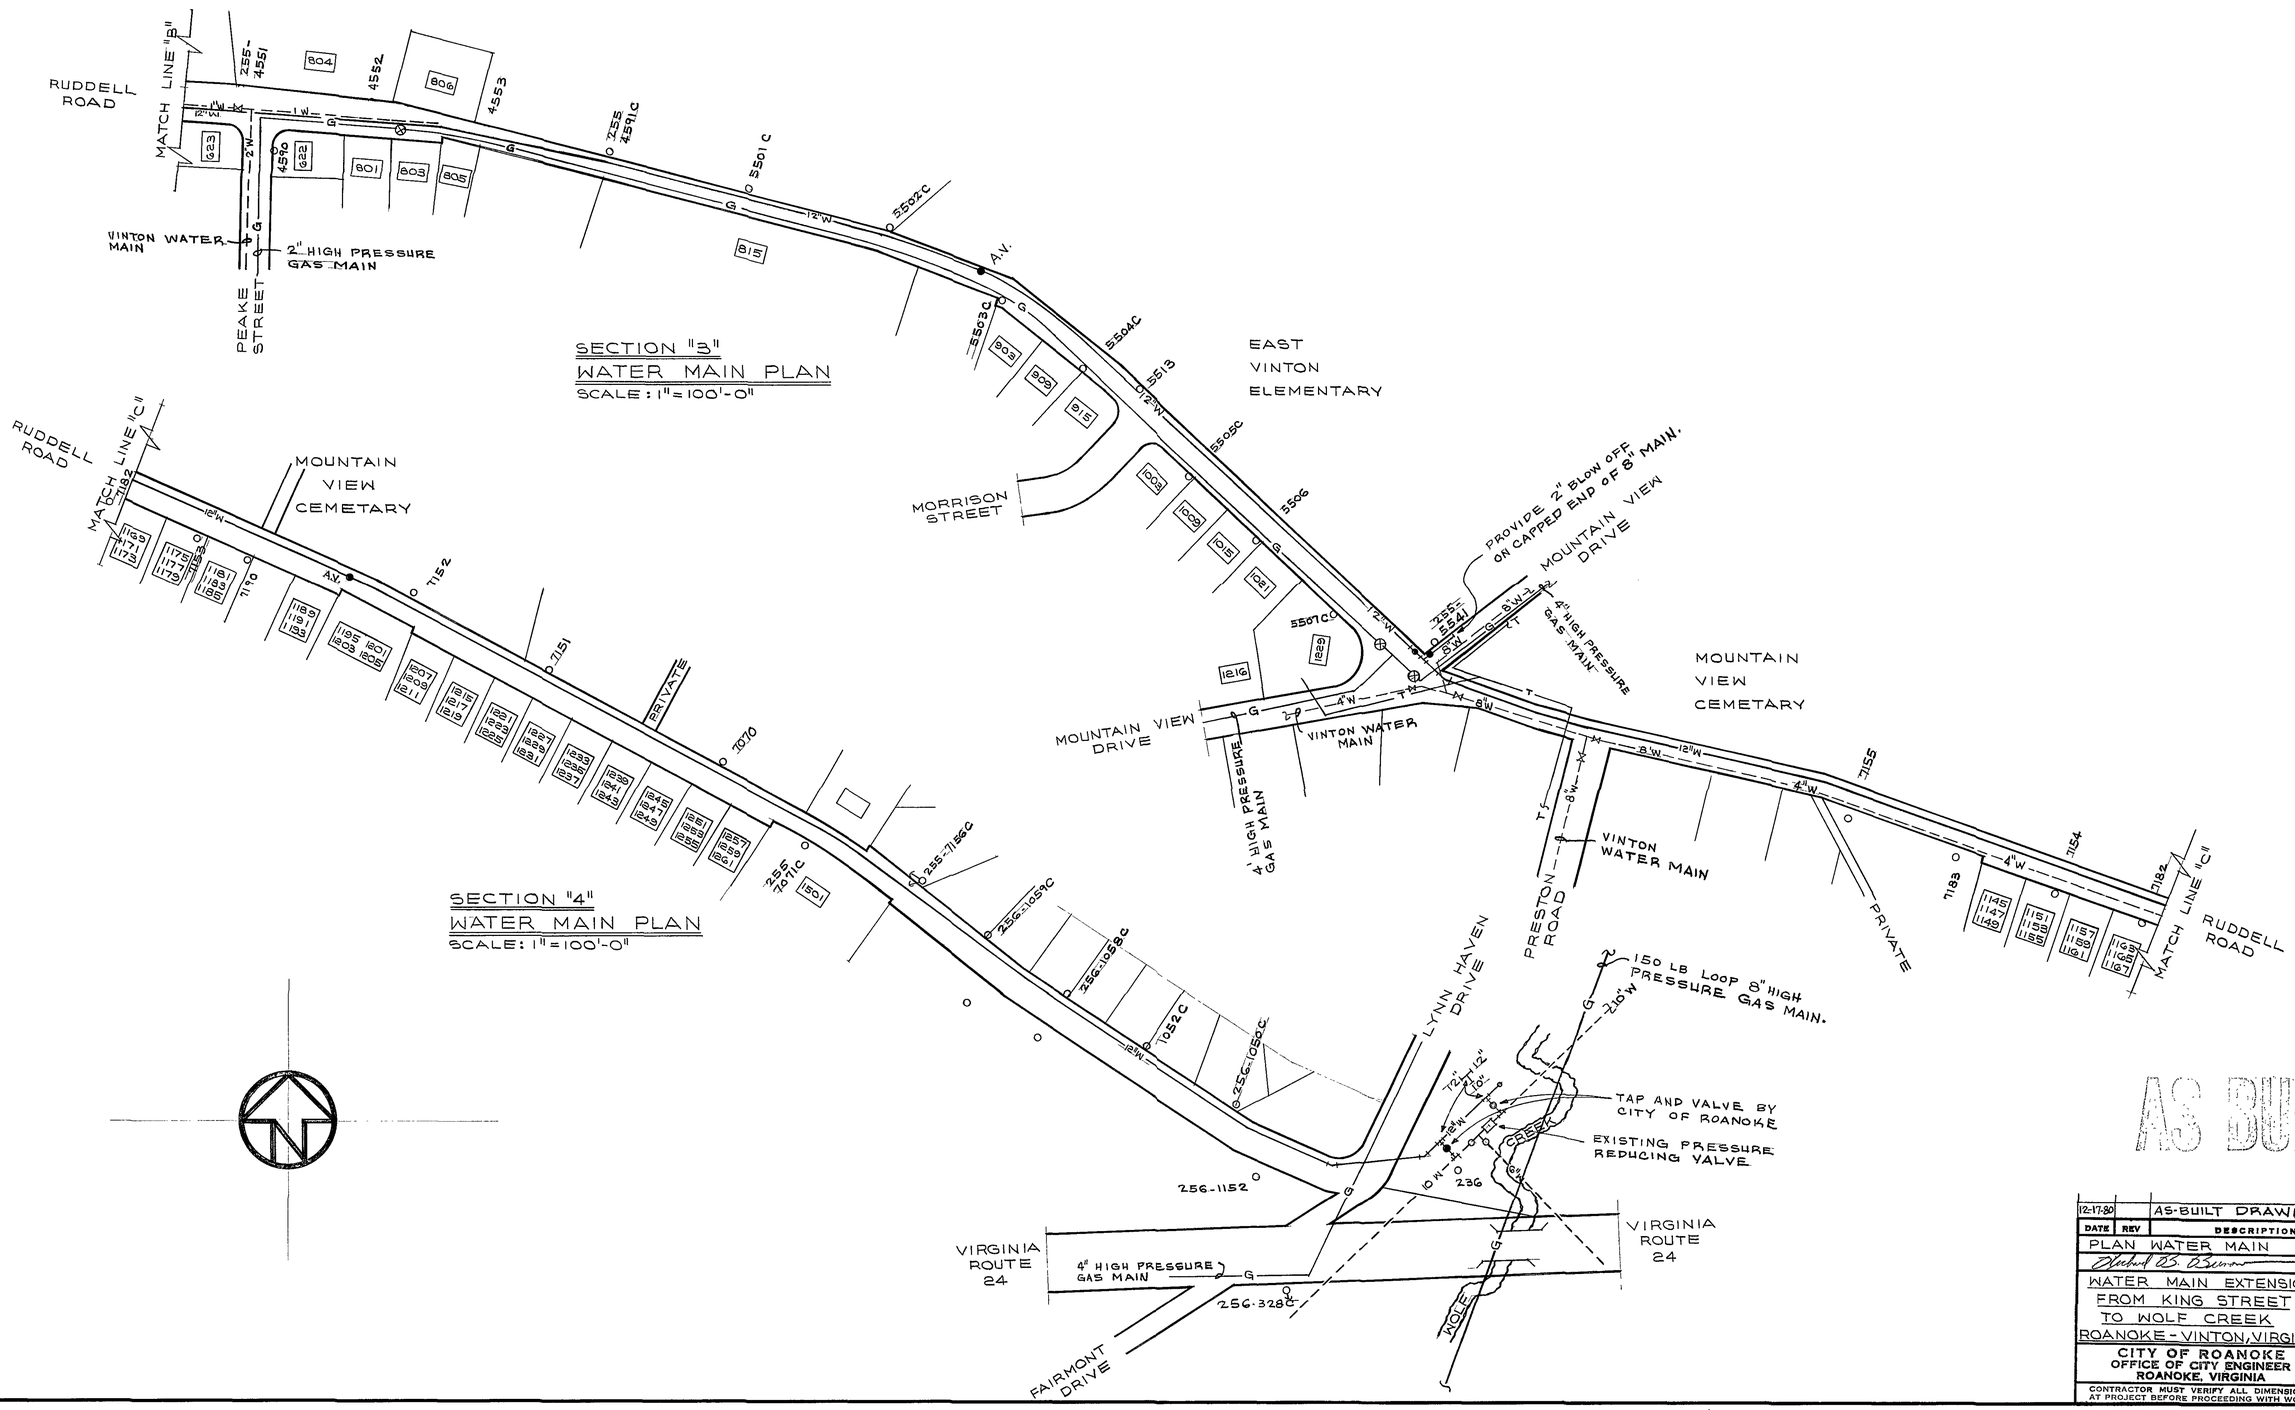

DATE	REV	DESCRIPTION	BY
12-17-80		AS-BUILT DRAWINGS	LBC

PLAN WATER MAIN

CITY ENGINEER

WATER MAIN EXTENSION
FROM KING STREET
TO WOLF CREEK
ROANOKE - VINTON, VIRGINIA

CITY OF ROANOKE
OFFICE OF CITY ENGINEER
ROANOKE, VIRGINIA

CONTRACTOR MUST VERIFY ALL DIMENSIONS AT PROJECT BEFORE PROCEEDING WITH WORK

DRAWN	LBV
CHECKED	LBC
APP'D	MCS
DATE	MAR. 80
JOB NO.	7903
SHEET	3
OF	4