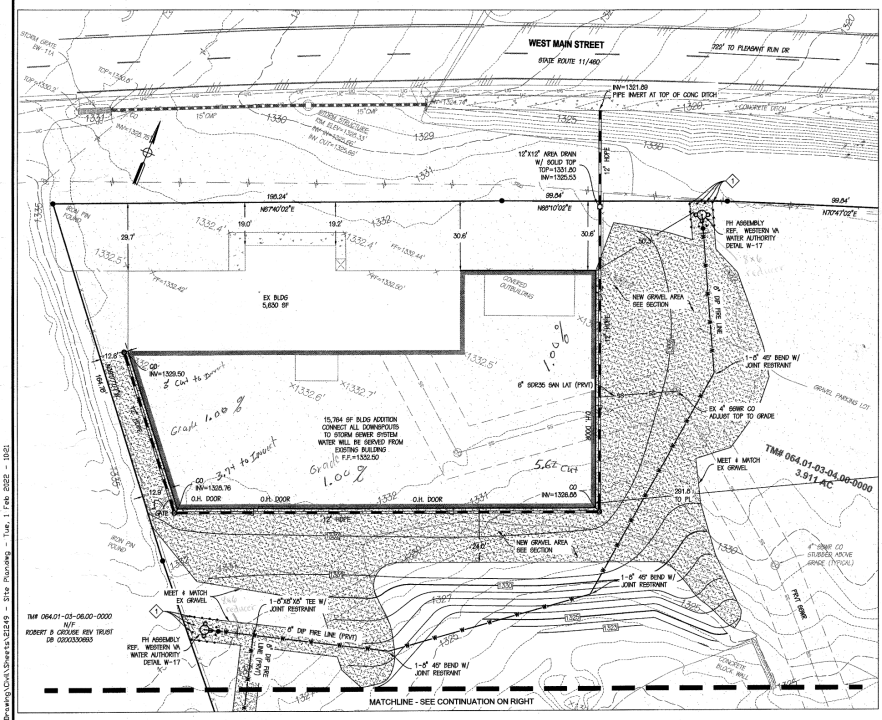

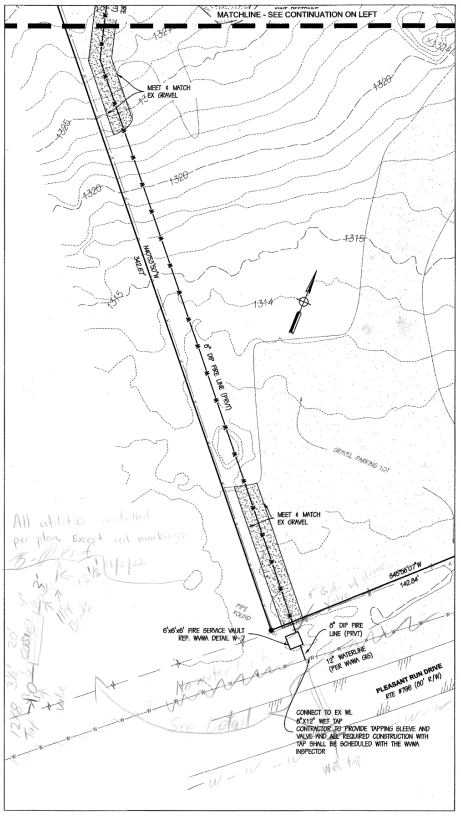

KEYNOTES

1. BOLLARD (SEE DETAIL). PER ROANOKE COUNTY REQUIREMENTS, BOLLARDS AROUND PROPOSED FIRE HYDRANTS SHALL BE AT LEAST 3' ABOVE GROUND, SPACED NO MORE THAN 4' APART, AND LOCATED AT LEAST 4' FROM THE HYDRANT.

NOTES:

1. FIRE LANES WILL BE EVALUATED ONSITE WITH THE CONTRACTOR TO DETERMINE IF NEEDED.
2. KNOX LOCKING KEY BOX SHALL BE INSTALLED. CONTRACTOR SHALL COORDINATE LOCATION WITH BRIAN SIMMONS OF ROANOKE COUNTY (540) 777-5721.
3. THE BARREL THE PROPOSED FIRE HYDRANTS SHALL BE PAINTED WHITE AND THE TOPS SHALL BE PAINTED IN ACCORDANCE WITH THE FLOW (1147 HYDRANT IS CAPABLE OF PROVIDING. CONTRACTOR SHALL COORDINATE WITH BRIAN SIMMONS OF ROANOKE COUNTY (540) 777-5721.

PERKINS & ORRISON
ENGINEERS ▲ PLANNERS ▲ SURVEYORS

317 BROOK PARK PL, FOREST, VIRGINIA 24551
PHONE: 434-525-5965 FAX: 434-525-5966
EMAIL: pvo@perkins-orrison.com

17 W. NELSON STREET LEXINGTON, VIRGINIA 24450
PHONE: 540-464-9001 FAX: 540-464-0009
EMAIL: pvo@perkins-orrison.com

CONSULTANTS

SEAL:

RUSSELL H. ORRISON
Lic. No. 031849
02/01/2022
PROFESSIONAL ENGINEER

JOB:

BOONE TRACTOR ADDITION
CATAWBA MAGISTERIAL DISTRICT
ROANOKE COUNTY, VIRGINIA

CLIENT:

BOONE TRACTOR

MARK.	DATE	DESCRIPTION
1	02/01/2022	OWNER OWNER/COUNTY COMMENT

ISSUE:	10/21/2021
CONTOUR INTERVAL:	2'
DESIGNED BY:	RHO
DRAWN BY:	BDB/PWS
CHECKED BY:	RHO

SHEET TITLE

SITE & UTILITY PLAN

GRAPHIC SCALE
0 20 40
1"=20'

SHEET C200

JOB NO. 21249

SHEET NO. 4 OF 12

ID - P:\2021\21249 - Boone Tractor\Drawing\Civil\Sheets\21249 - Site Planning - Tue, 1 Feb 2022 - 19:21