LEGEND

EXISTING	NEW	DESCRIPTION
W 12"	SS	WATER
SS		SANITARY SEWER
SSMH	SSMH	SANITARY SEWER MANHOLE
℄		PROPERTY LINE
		EASEMENT LINE
		TEMPORARY CONSTRUCTION EASEMENT
		BEAM GUARDRAIL
OHP		OVERHEAD POWER LINE
EP		EDGE OF PAVEMENT
TB		TOP OF BANK
INV.		INVERT
ELEV.		ELEVATION
00.0		SPOT ELEVATION

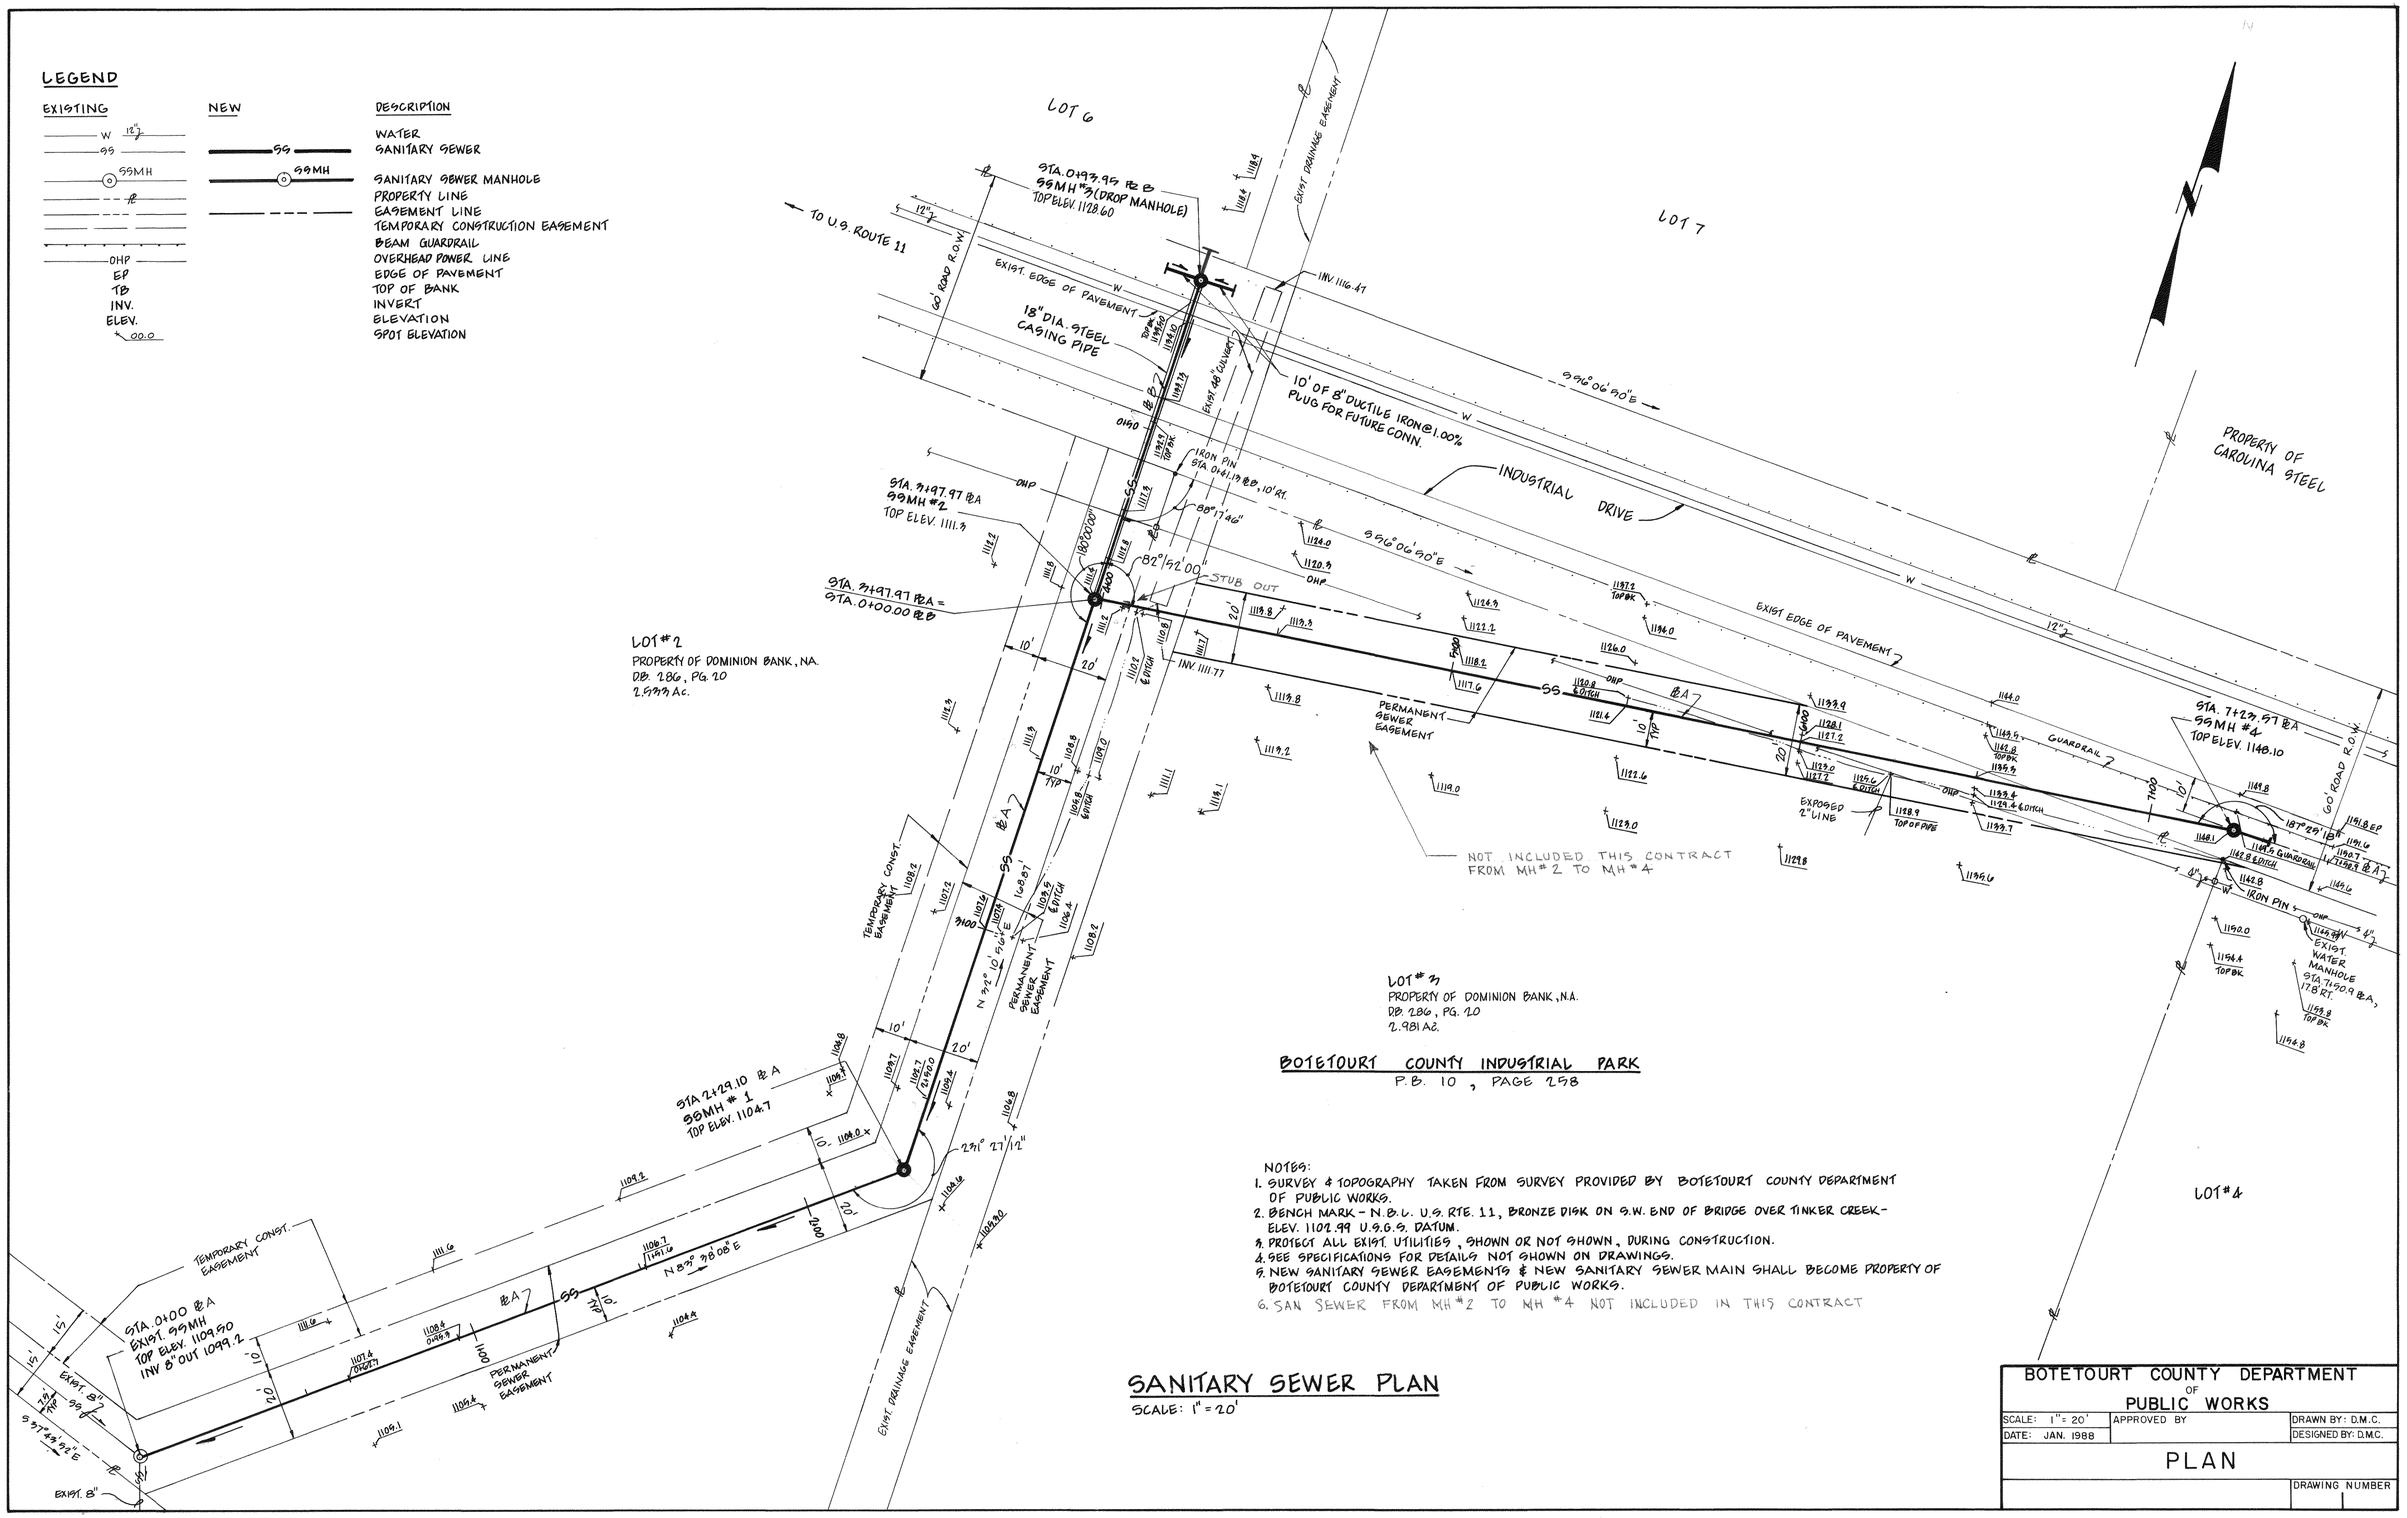

BOTETOURT COUNTY INDUSTRIAL PARK
P.B. 10, PAGE 258

NOTES:
1. SURVEY & TOPOGRAPHY TAKEN FROM SURVEY PROVIDED BY BOTETOURT COUNTY DEPARTMENT OF PUBLIC WORKS.
2. BENCH MARK - N.B.L. U.S. RTE. 11, BRONZE DISK ON S.W. END OF BRIDGE OVER TINKER CREEK - ELEV. 1102.99 U.S.G.S. DATUM.
3. PROTECT ALL EXIST. UTILITIES, SHOWN OR NOT SHOWN, DURING CONSTRUCTION.
4. SEE SPECIFICATIONS FOR DETAILS NOT SHOWN ON DRAWINGS.
5. NEW SANITARY SEWER EASEMENTS & NEW SANITARY SEWER MAIN SHALL BECOME PROPERTY OF BOTETOURT COUNTY DEPARTMENT OF PUBLIC WORKS.
6. SAN SEWER FROM MH #2 TO MH #4 NOT INCLUDED IN THIS CONTRACT

SANITARY SEWER PLAN

SCALE: 1" = 20'

BOTETOURT COUNTY DEPARTMENT OF PUBLIC WORKS		
SCALE: 1" = 20'	APPROVED BY	DRAWN BY: D.M.C.
DATE: JAN. 1988		DESIGNED BY: D.M.C.
PLAN		
		DRAWING NUMBER