
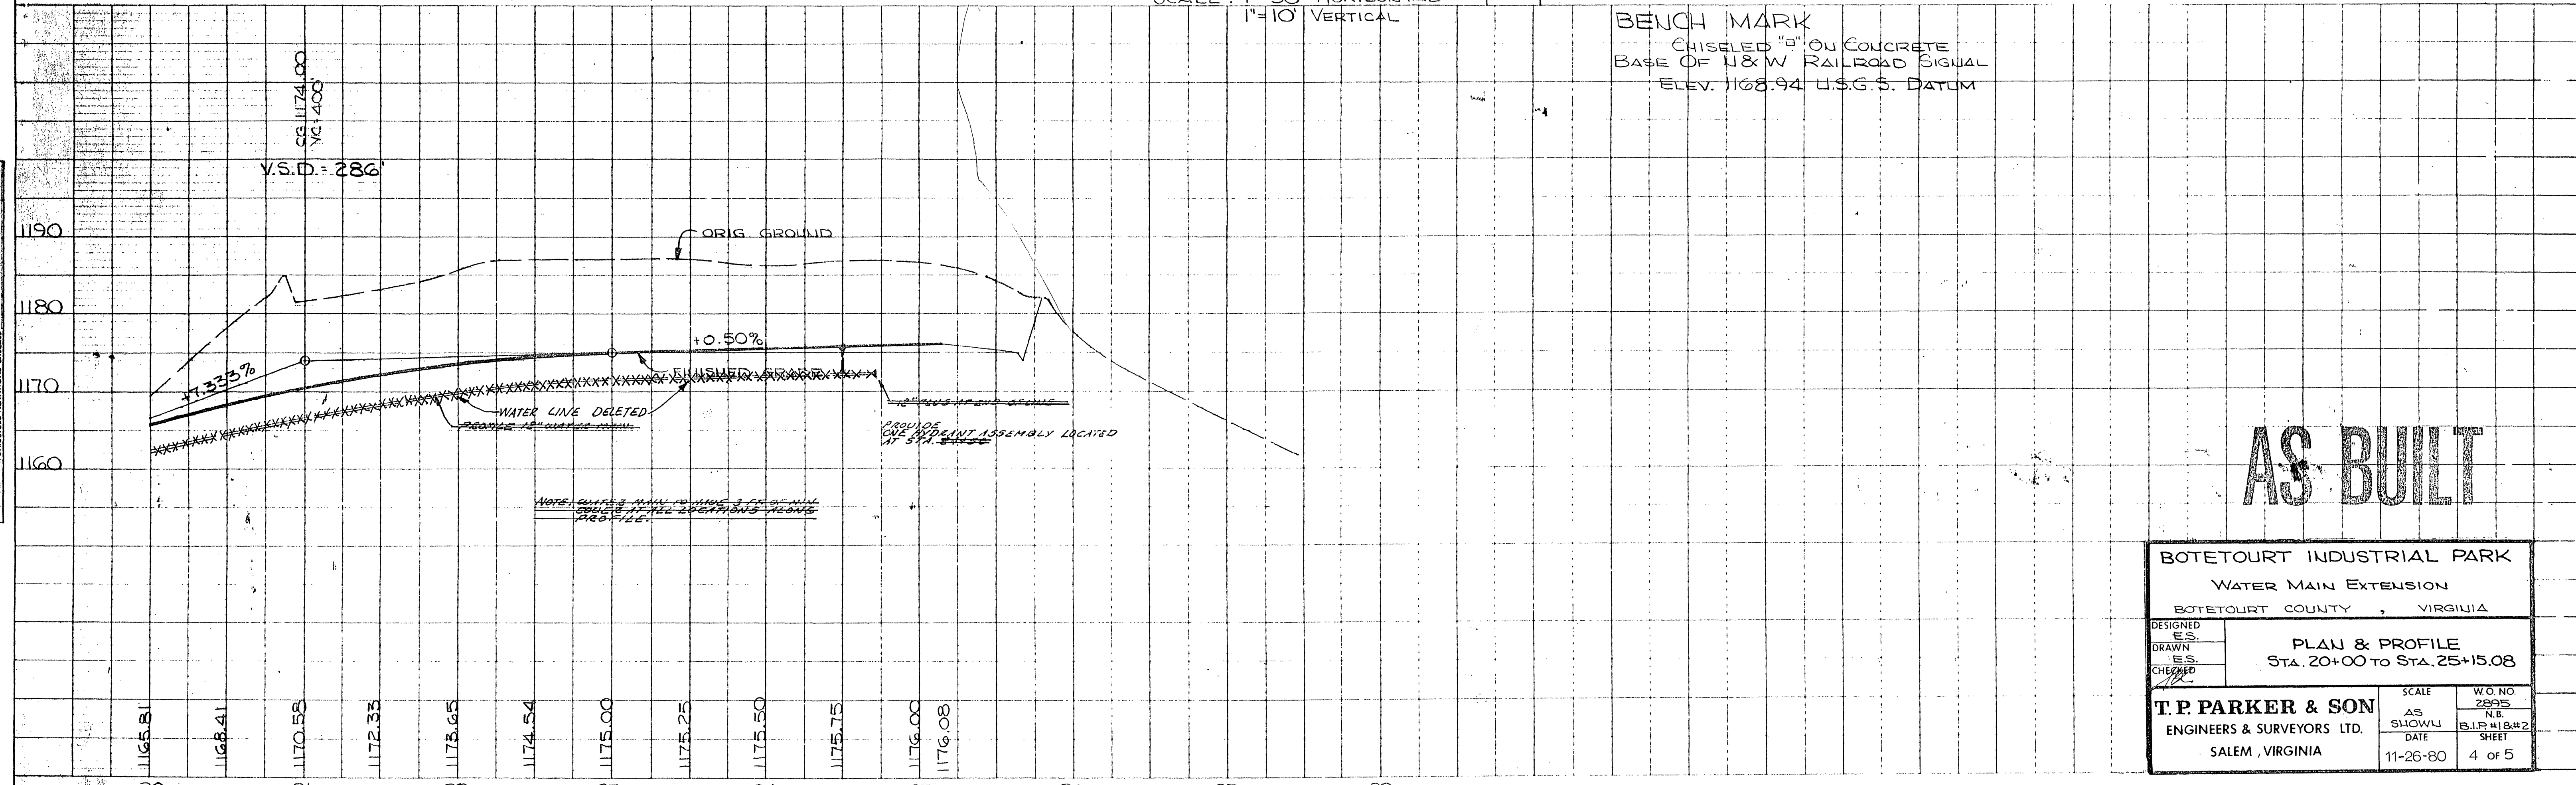


PLAN	SUPPLIED	BY	DATE
NOTE: FOR ALL CHANGES, SEE SHEET 80-23	EL. JOYNER	1-80	

PROFILE	SUPPLIED	BY	DATE
NOTE: FOR ALL CHANGES, SEE SHEET 80-23	EL. JOYNER	1-80	

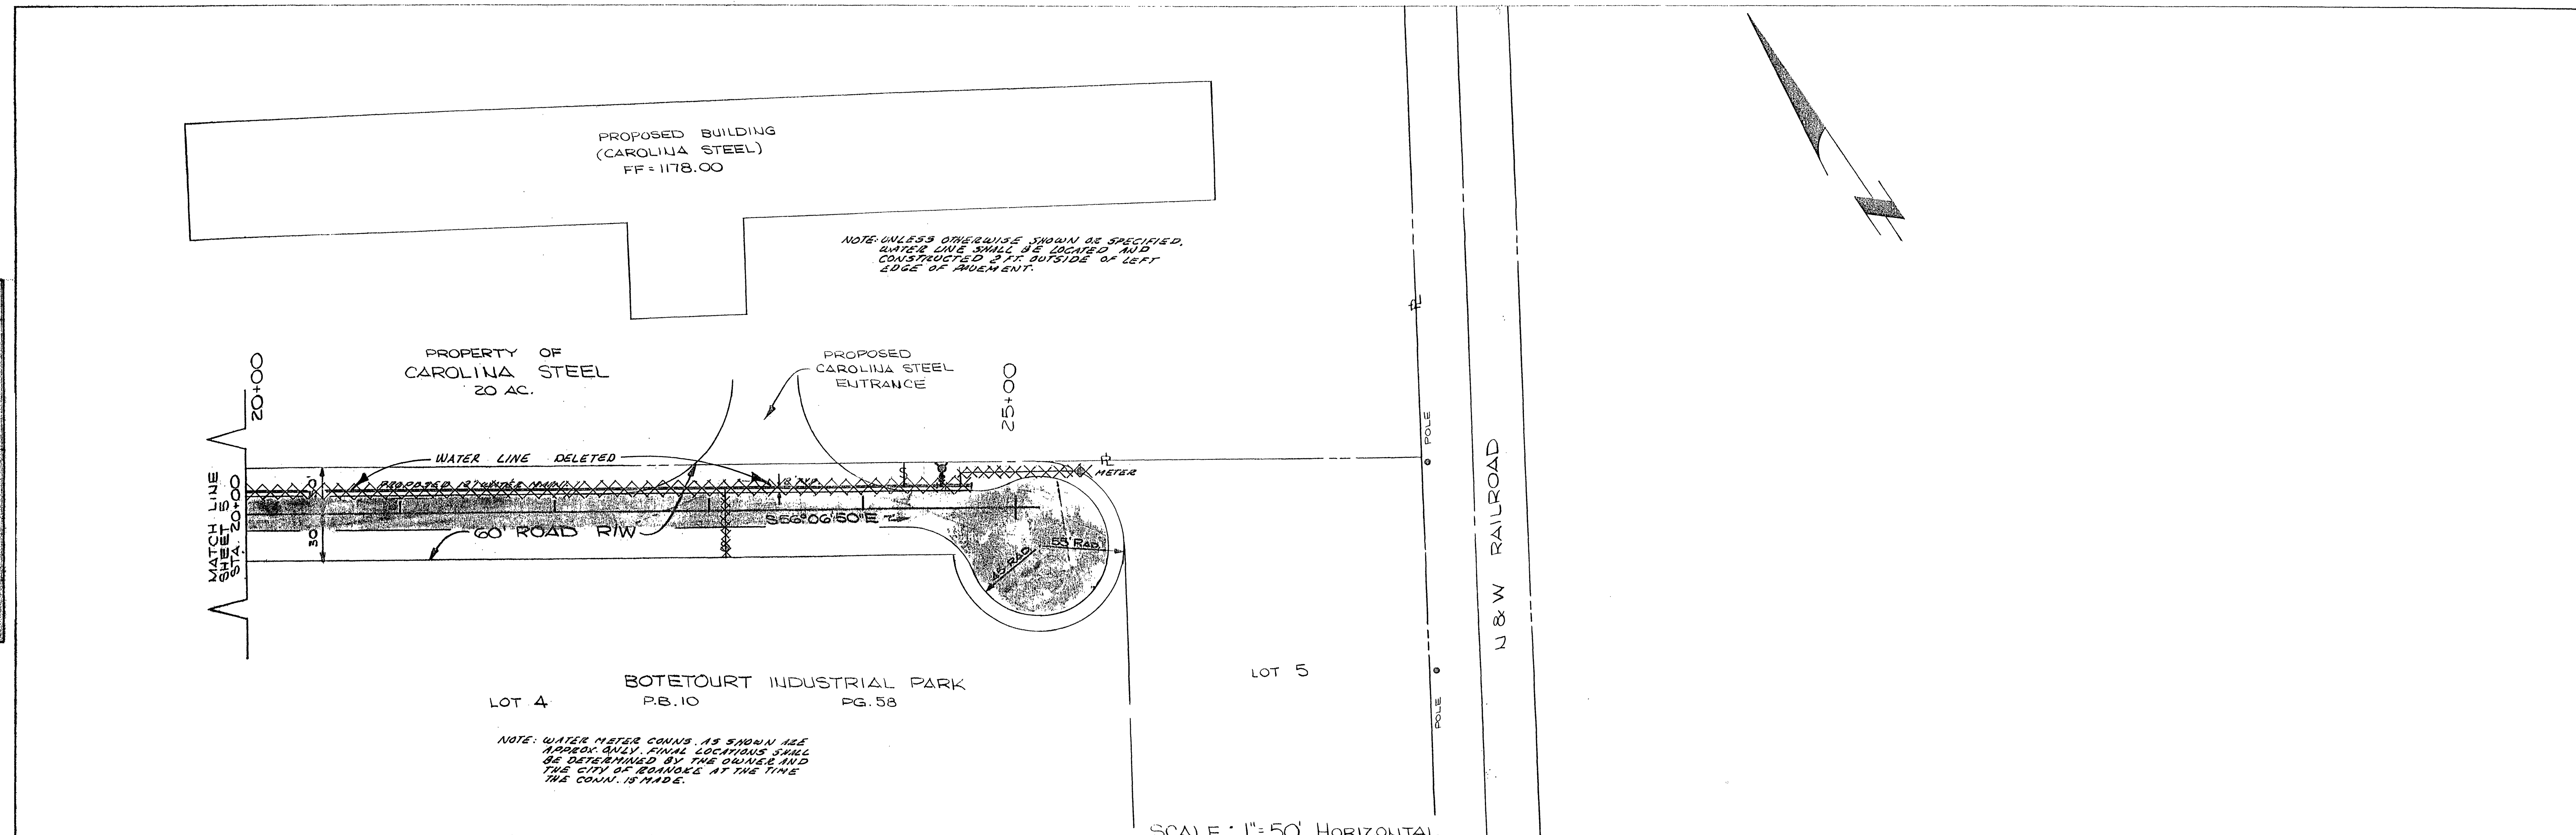

BOTETOURT INDUSTRIAL PARK			
WATER MAIN EXTENSION			
BOTETOURT COUNTY, VIRGINIA			
DESIGNED ES.	PLAN & PROFILE STA. 20+00 TO STA. 25+15.08		
DRAWN ES.			
CHECKED JPC			
T. P. PARKER & SON		SCALE AS SHOWN	W.O. NO. 2895
ENGINEERS & SURVEYORS LTD.		DATE	N.B. B.L.P. #18#2
SALEM, VIRGINIA		11-26-80	SHEET 4 OF 5