

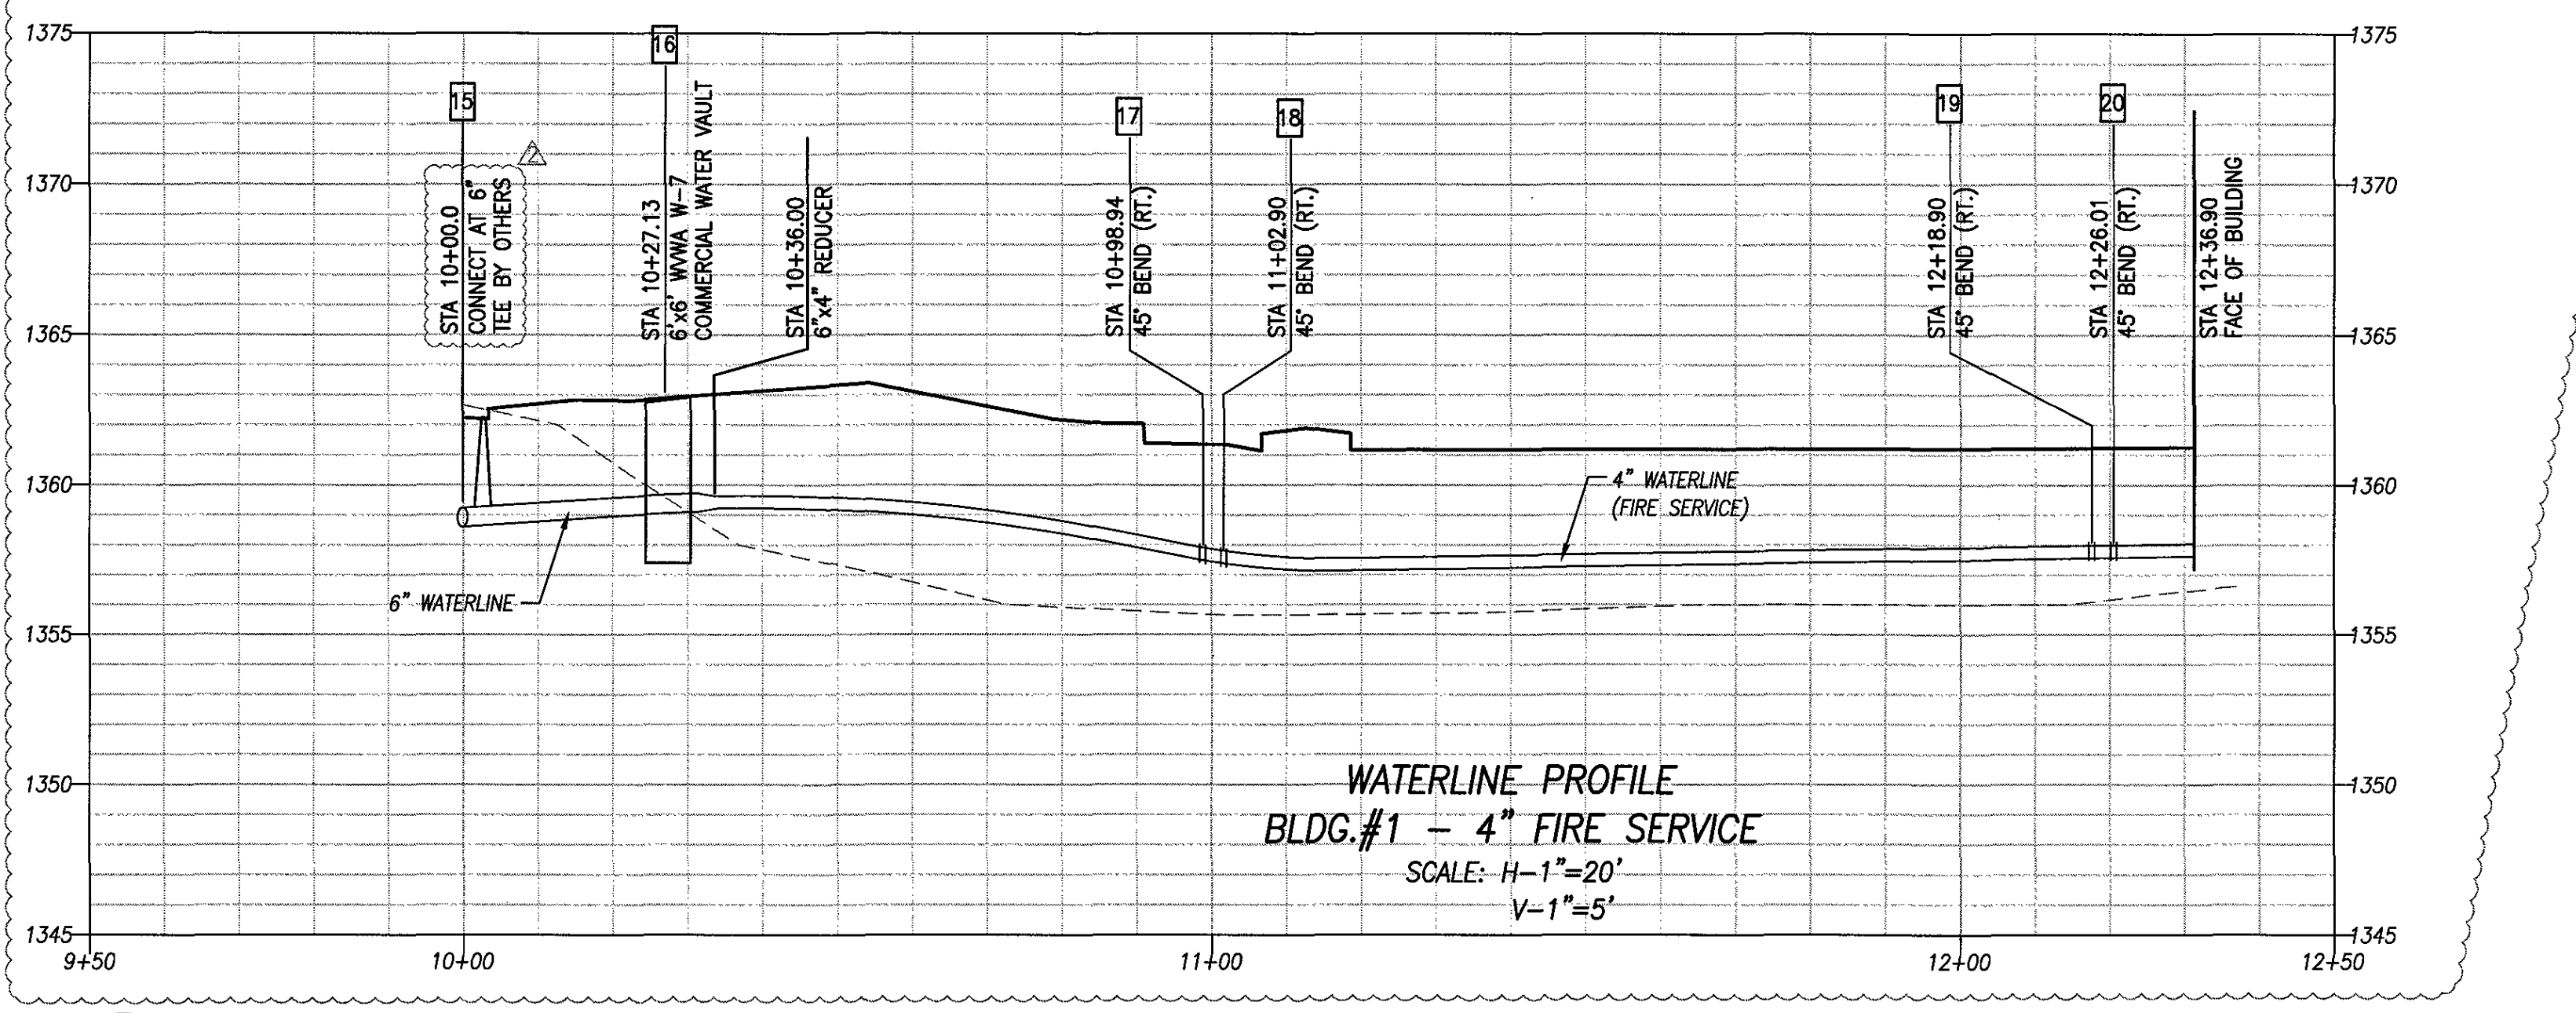
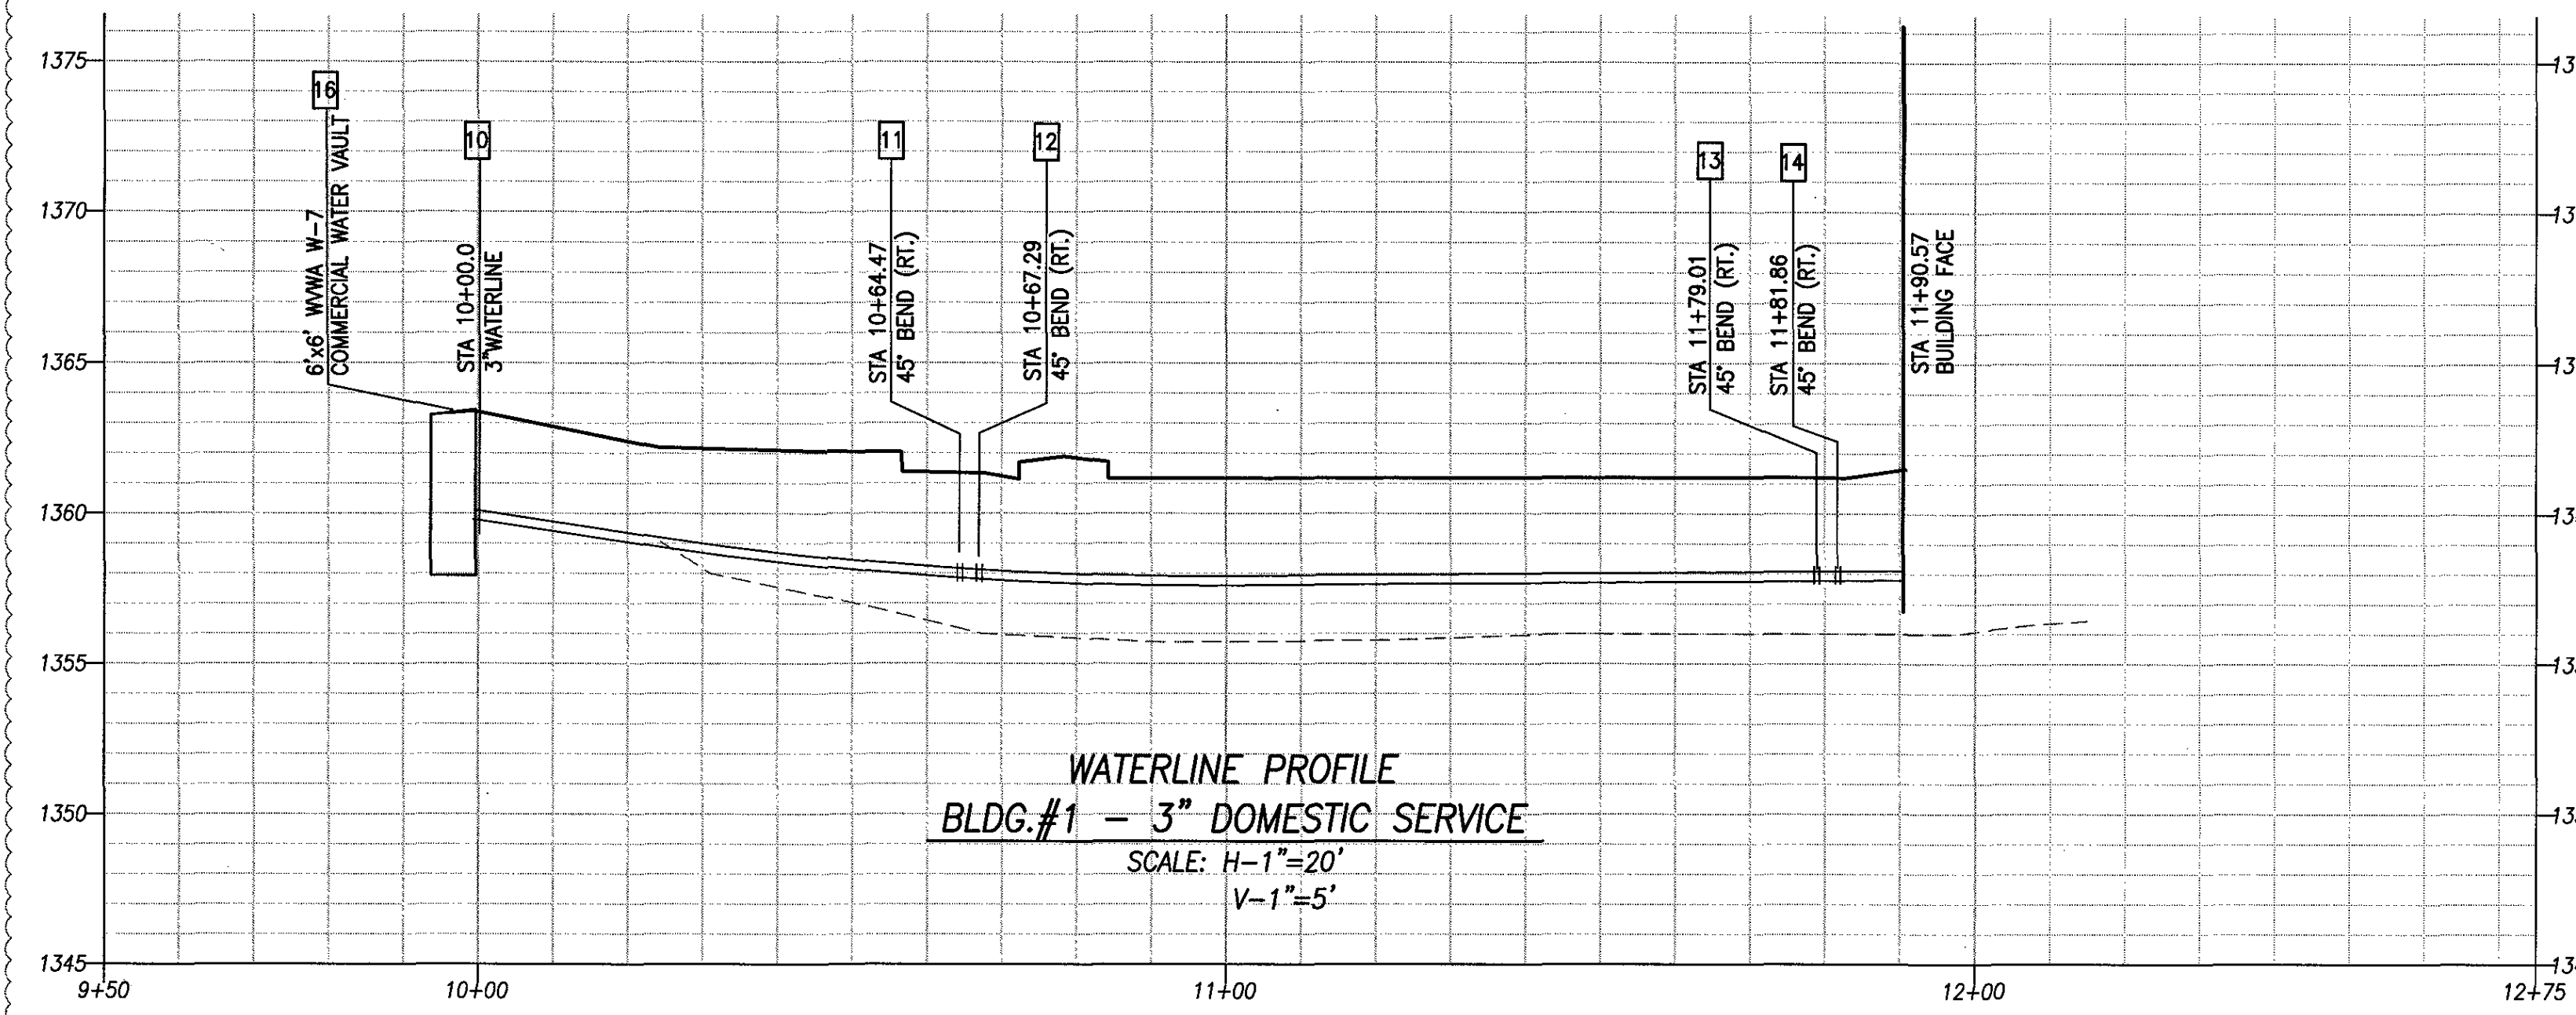


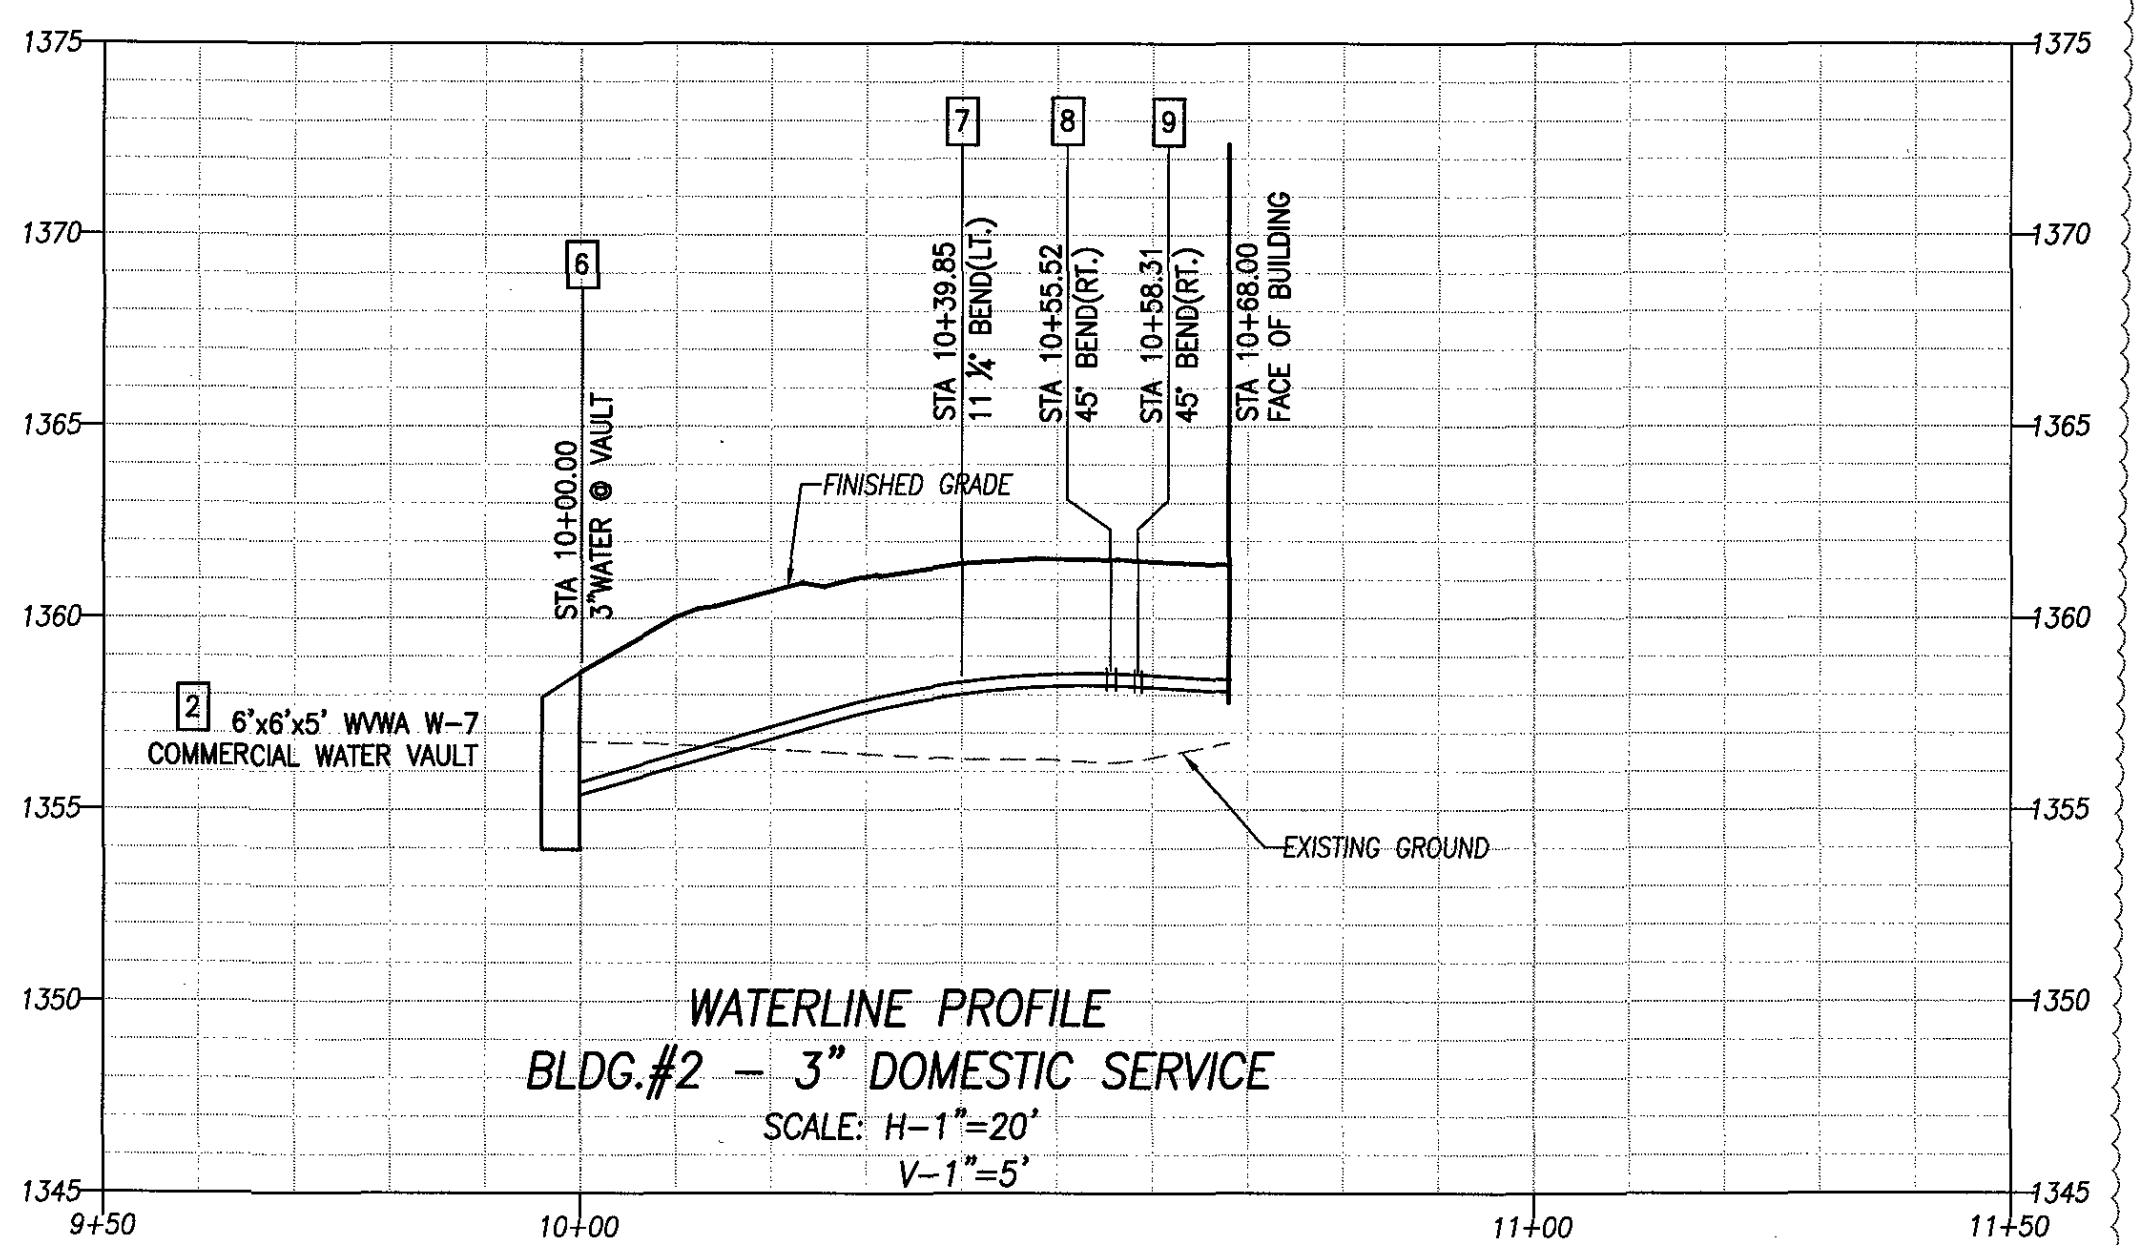

No.	Revision	By	Appd.	Date	Drawn	MsM
1	WWA COMMENTS 10/31/17	MsM	RHW	1/30/18	Designed	MsM
2	WWA COMMENTS	ECI	RHW	3/16/18	Checked	ECI
					Approved	RHW

WATERLINE PROFILES
DTC MULTIFAMILY - PHASE 2
DALEVILLE TOWN CENTER
BOTETOURT COUNTY, VIRGINIA

SCALE: AS SHOWN
 DATE: MAR 16, 2018
 PROJECT: 17055
C13

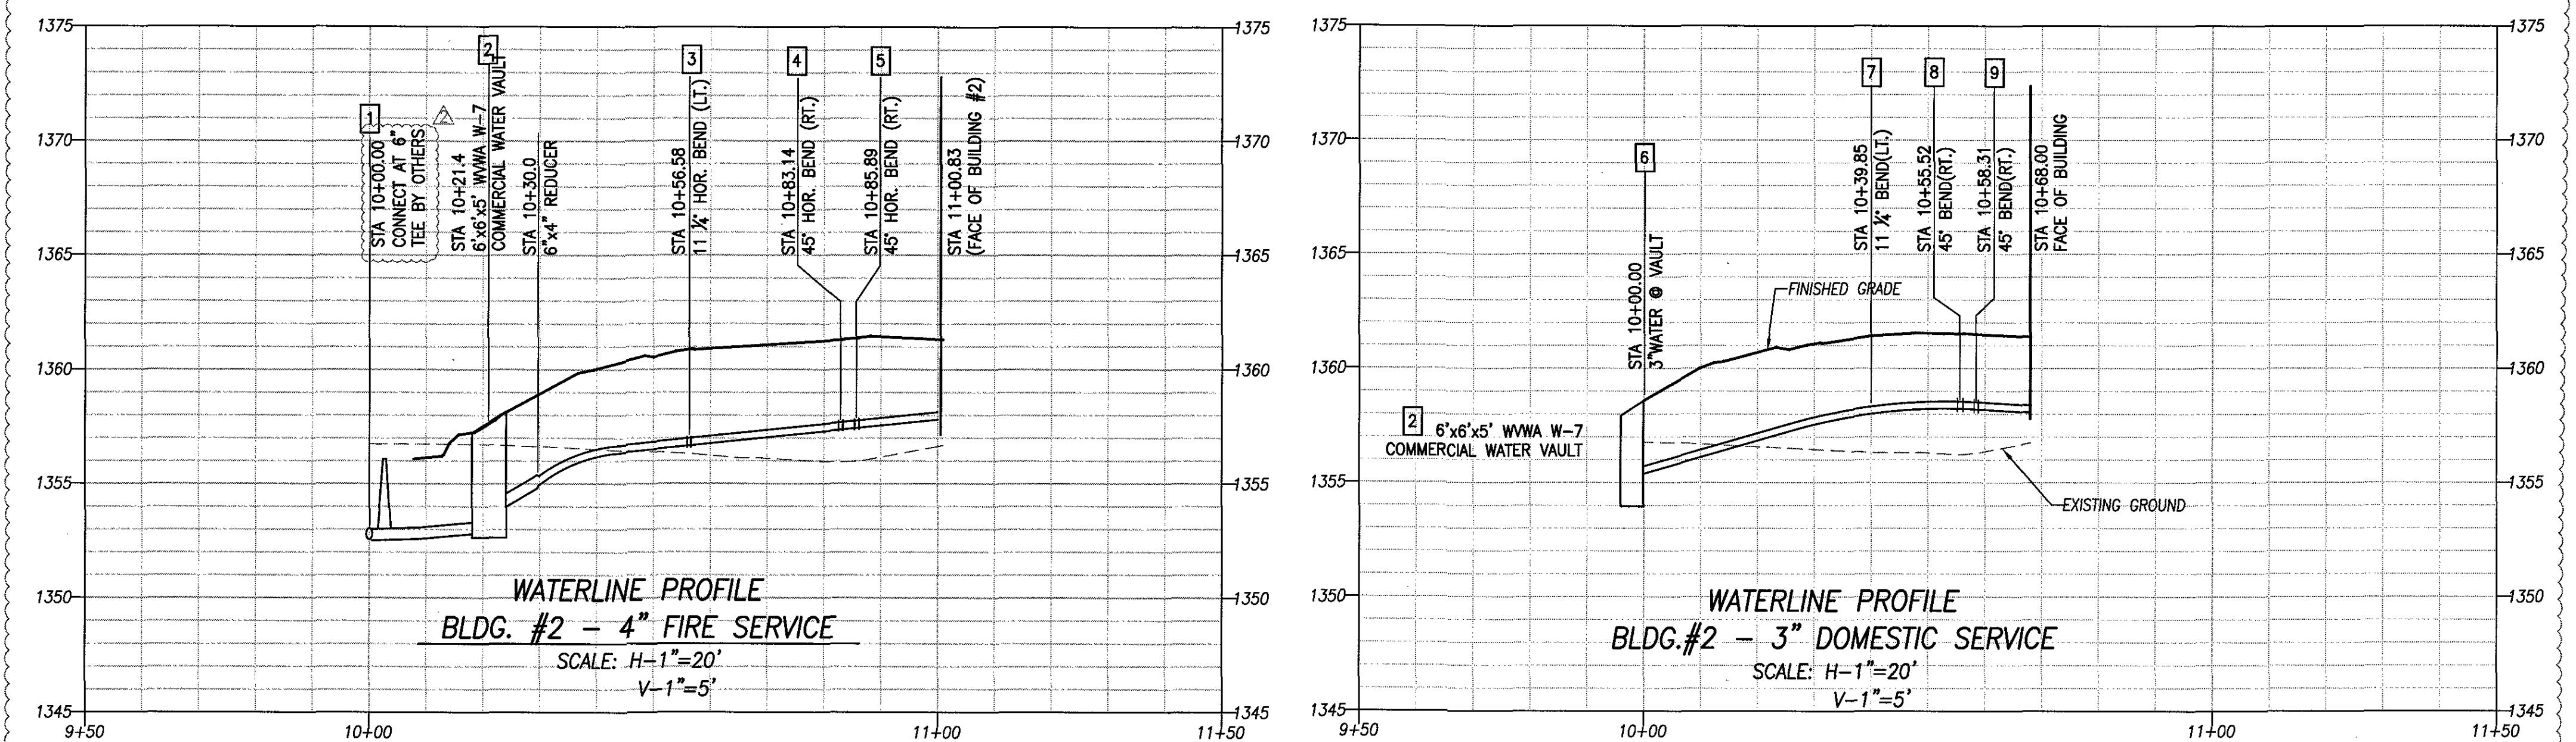