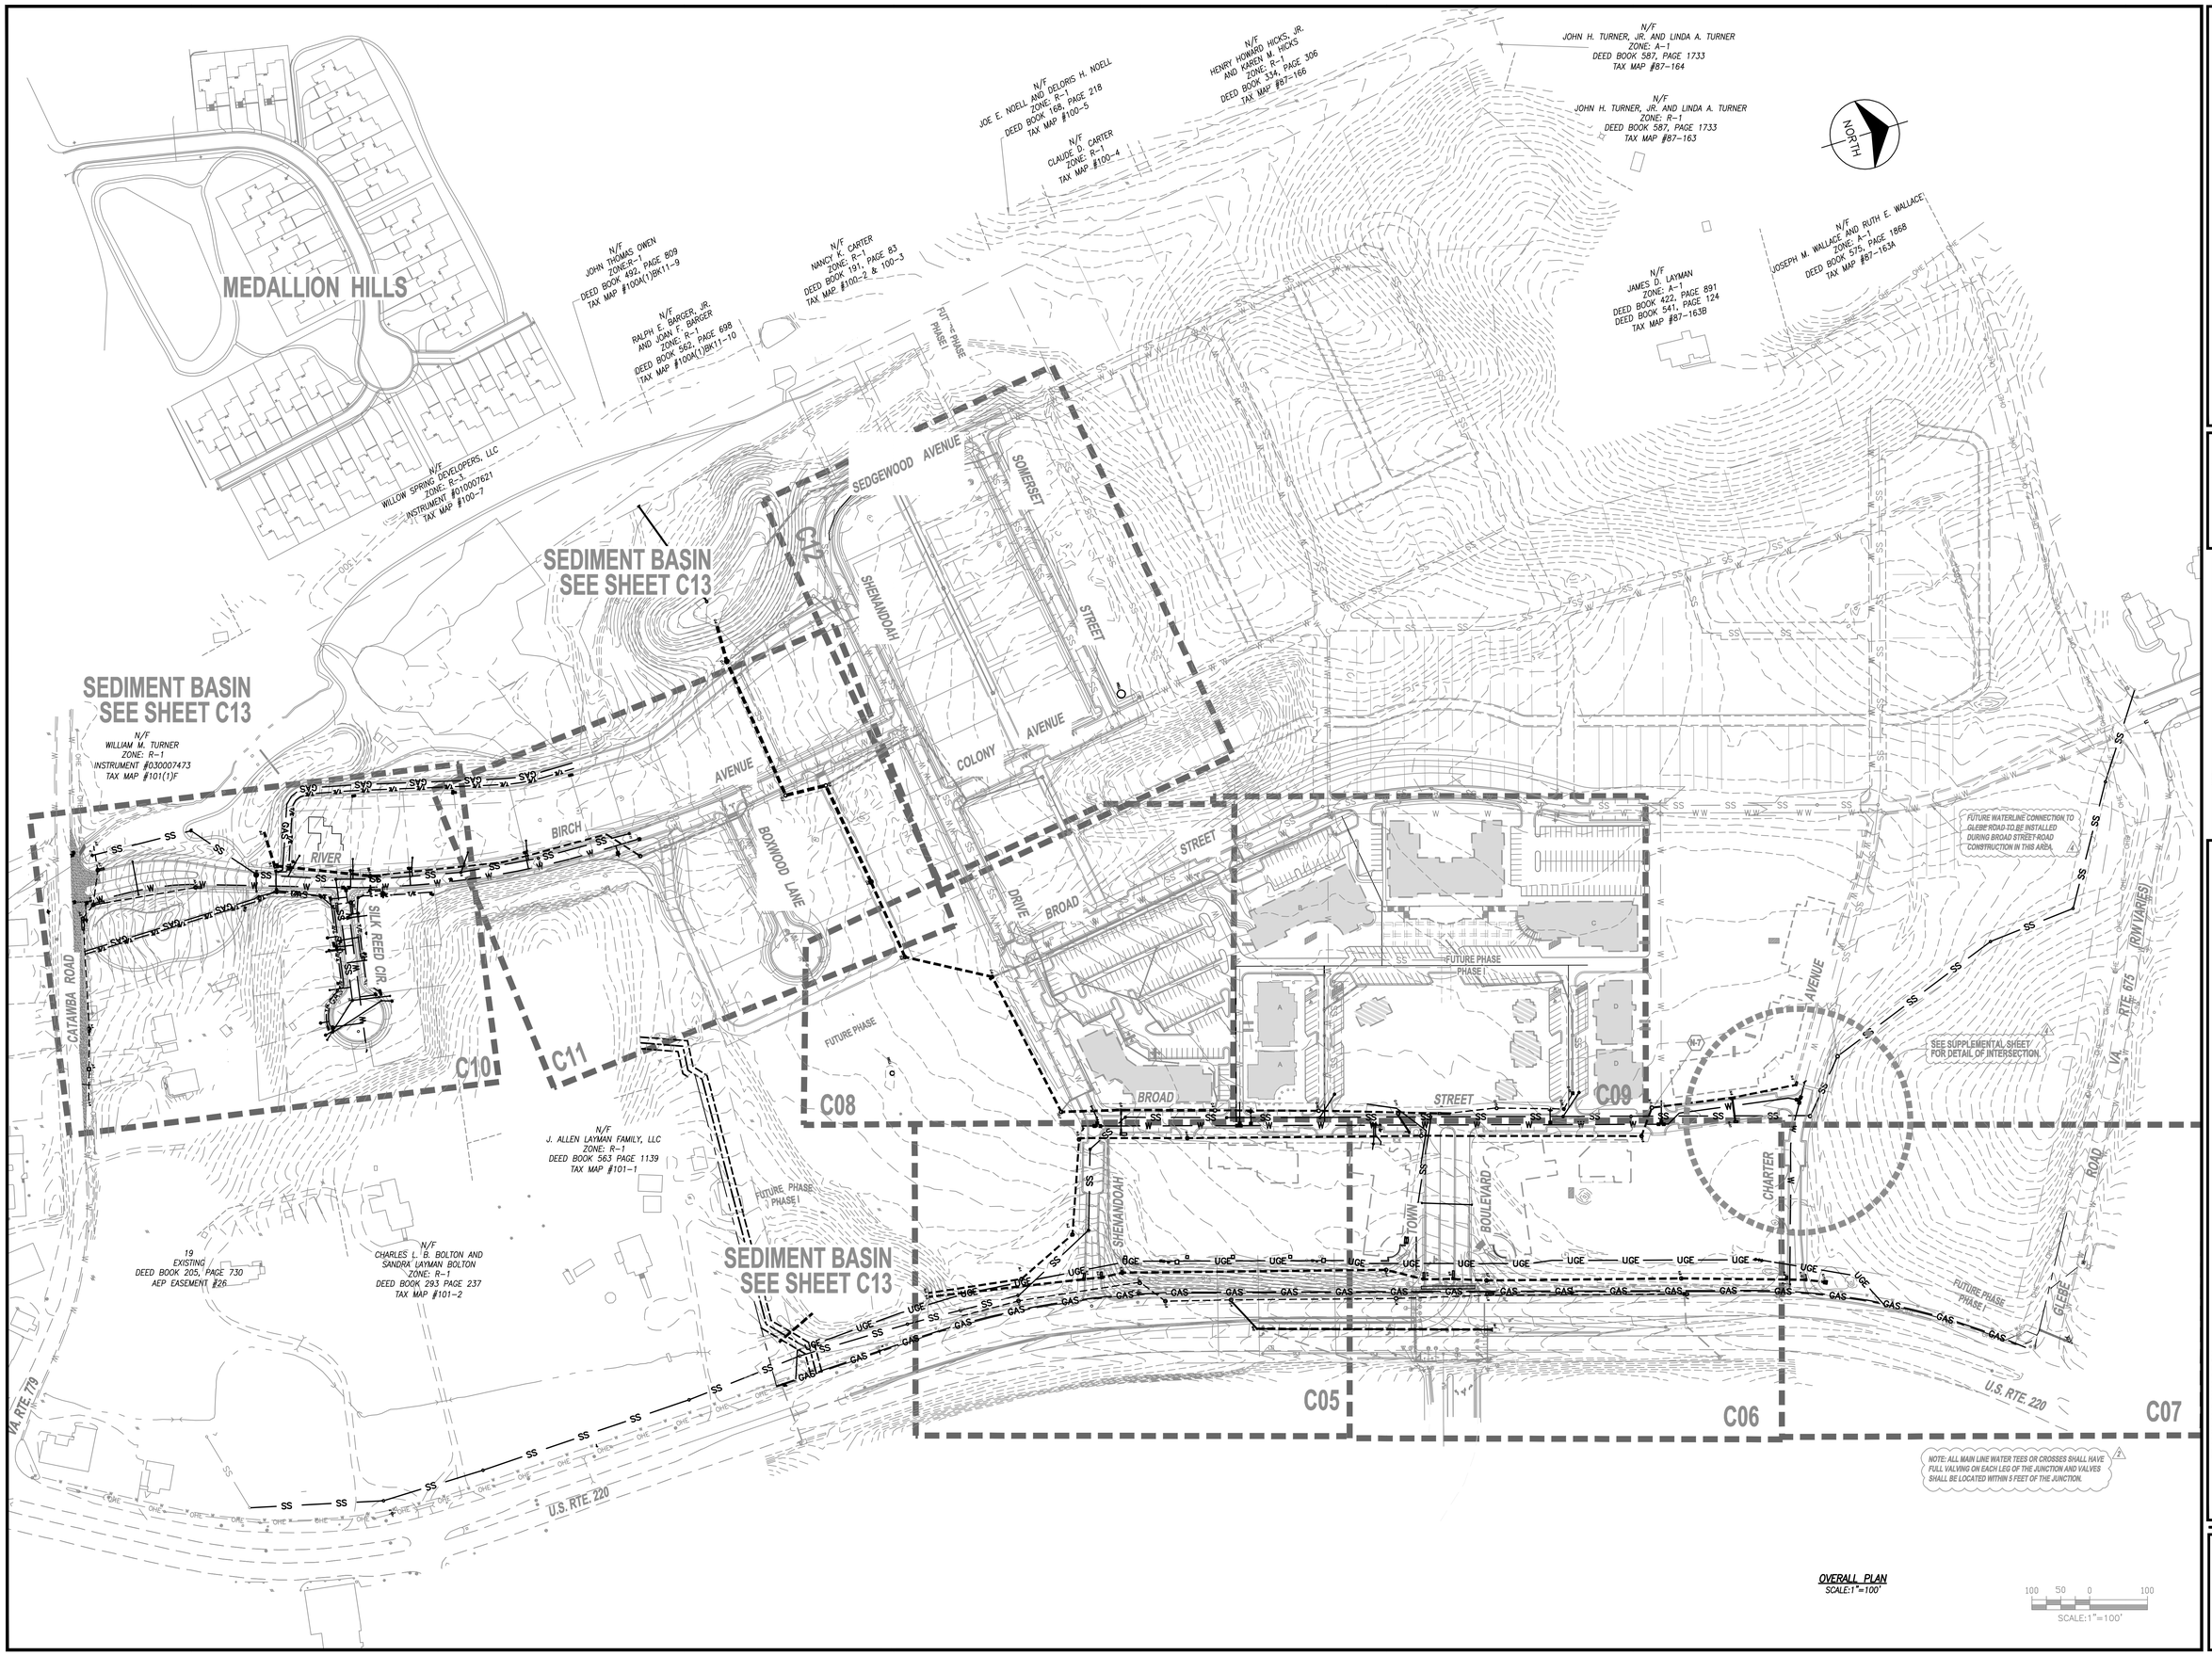

MARK	DATE	BY	DESCRIPTION
3	5/29/09	MSMJ	VARIOUS DESIGN DEVELOPMENT REVISIONS
2	5/8/09	RHW	BOTETOURT, VDH, DEQ COMMENTS

REVISIONS

DATE	5/8/08
PROJECT	03083
DESIGNED	RHW
DRAWN	MSMJ
CHECKED	RHW

ENGINEERING CONCEPTS, INC.
"Creating Success"
20 S Roanoke Street, P.O Box 619
Christiansburg, Va 24068
540.473.1253 fax 540.473.1254

AS-BUILT

PROJECT FRALIN AND WALDRON
DALEVILLE TOWN CENTER

DRAWING OVERALL PLAN

SHEET

C-04