NOTE: PROPOSED WATERLINE SHALL BE 6" UNLESS NOTED OTHERWISE.

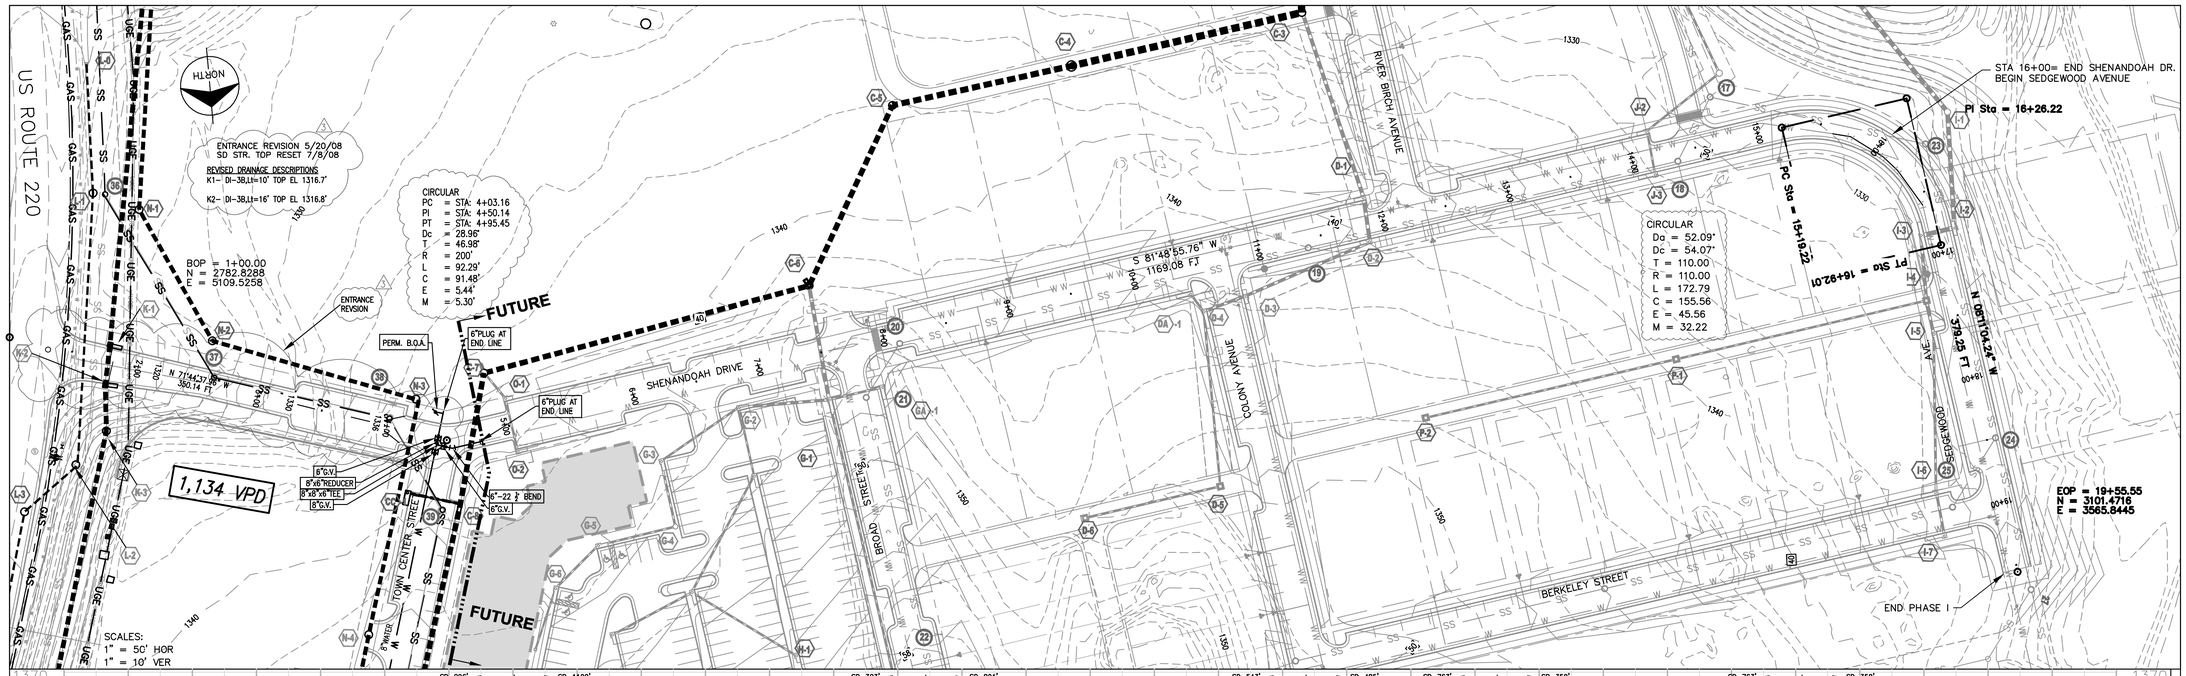

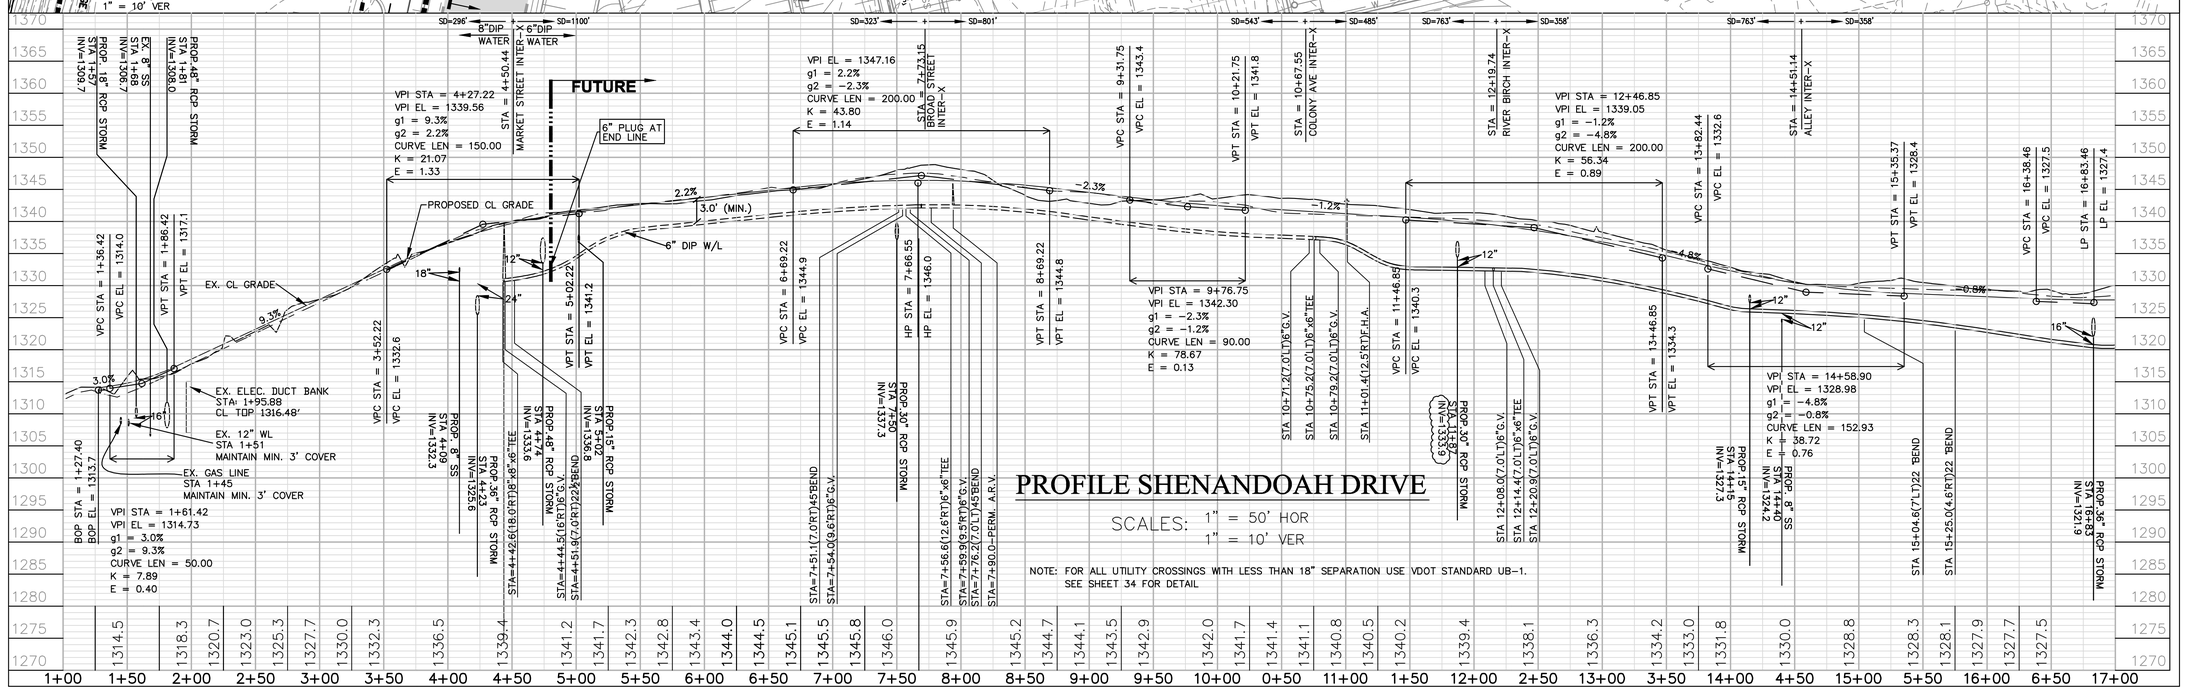

MARK	DATE	BY	REVISIONS DESCRIPTION
1	07/08/08	MSMJ	VARIOUS DEVELOPMENT REVISIONS
2	5/20/08	MWL	DUCT BANK CONFLICT
3	3/10/08	MSMJ	VARIOUS COUNTY REVIEW COMMENTS

DATE	5/8/08
PROJECT	03083
DESIGNED	RHW
DRAWN	MSMJ
CHECKED	RHW

ENGINEERING CONCEPTS, INC.
"Creating Success"
20 S Roanoke Street, PO Box 619
Christiansburg, Virginia 24073
540.473.1253 fax 540.473.1254

COMMONWEALTH OF VIRGINIA
ROBERT H. VAMPLER, JR.
No. 34713
PROFESSIONAL ENGINEER

AS-BUILT

PROJECT FRALIN AND WALDRON
DALEVILLE TOWN CENTER

DRAWING SHENANDOAH AVE. & SEDGEWOOD AVE. PLAN / PROFILE

SHEET
C-24