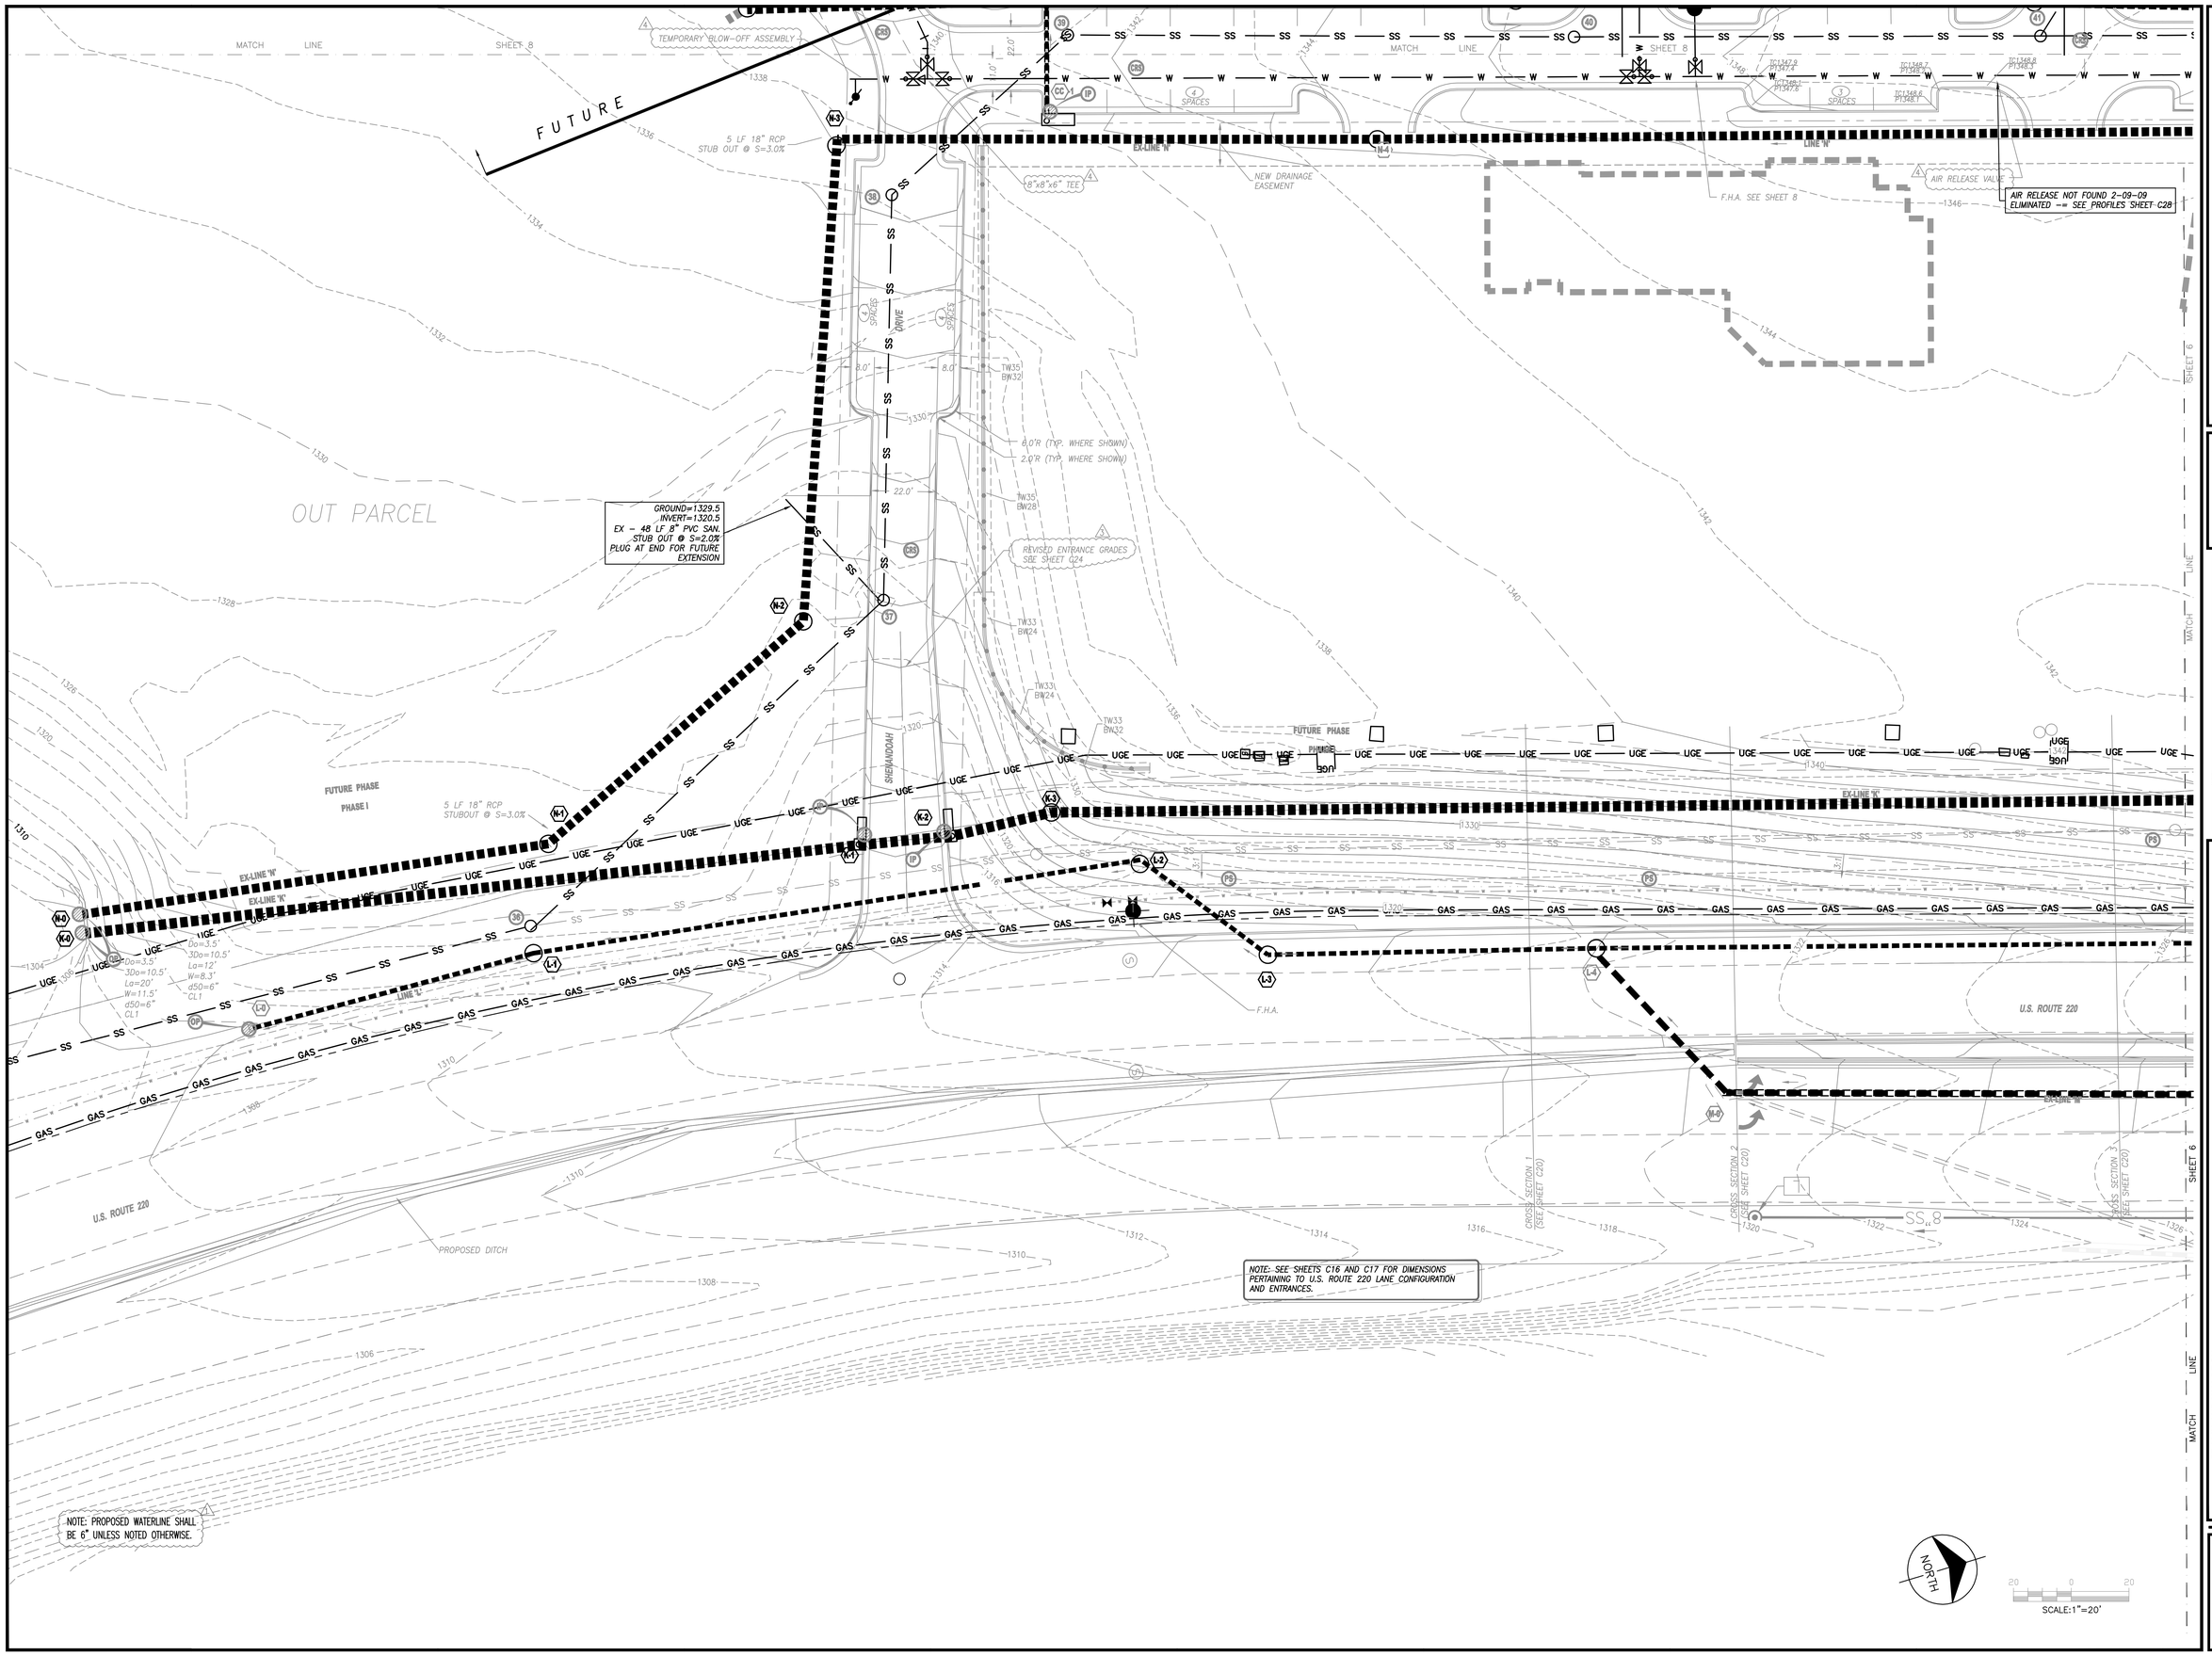

MARK	DATE	BY	DESCRIPTION
4	09/29/08	MSMJ	VARIOUS DESIGN DEVELOPMENT REVISIONS
3	6/26/08	MSMJ	VARIOUS DEVELOPMENT REVISIONS
2	5/8/08	RHW	BOTETOURT COUNTY, VDH, DEQ COMMENTS
1	03/08/08	MSMJ	VARIOUS COUNTY REVIEW COMMENTS

REVISIONS

DATE	12/05/07
PROJECT	03083
DESIGNED	RHW
DRAWN	MSMJ
CHECKED	RHW

ENGINEERING CONCEPTS, INC.
"Creating Success"
20 S Roanoke Street, P.O Box 619
Christiansburg, Virginia 24068
540.473.1253 fax 540.473.1254

AS-BUILT

PROJECT FRALIN AND WALDRON
DALEVILLE TOWN CENTER

DRAWING COMPREHENSIVE DEVELOPMENT PLAN

SHEET

C-05