


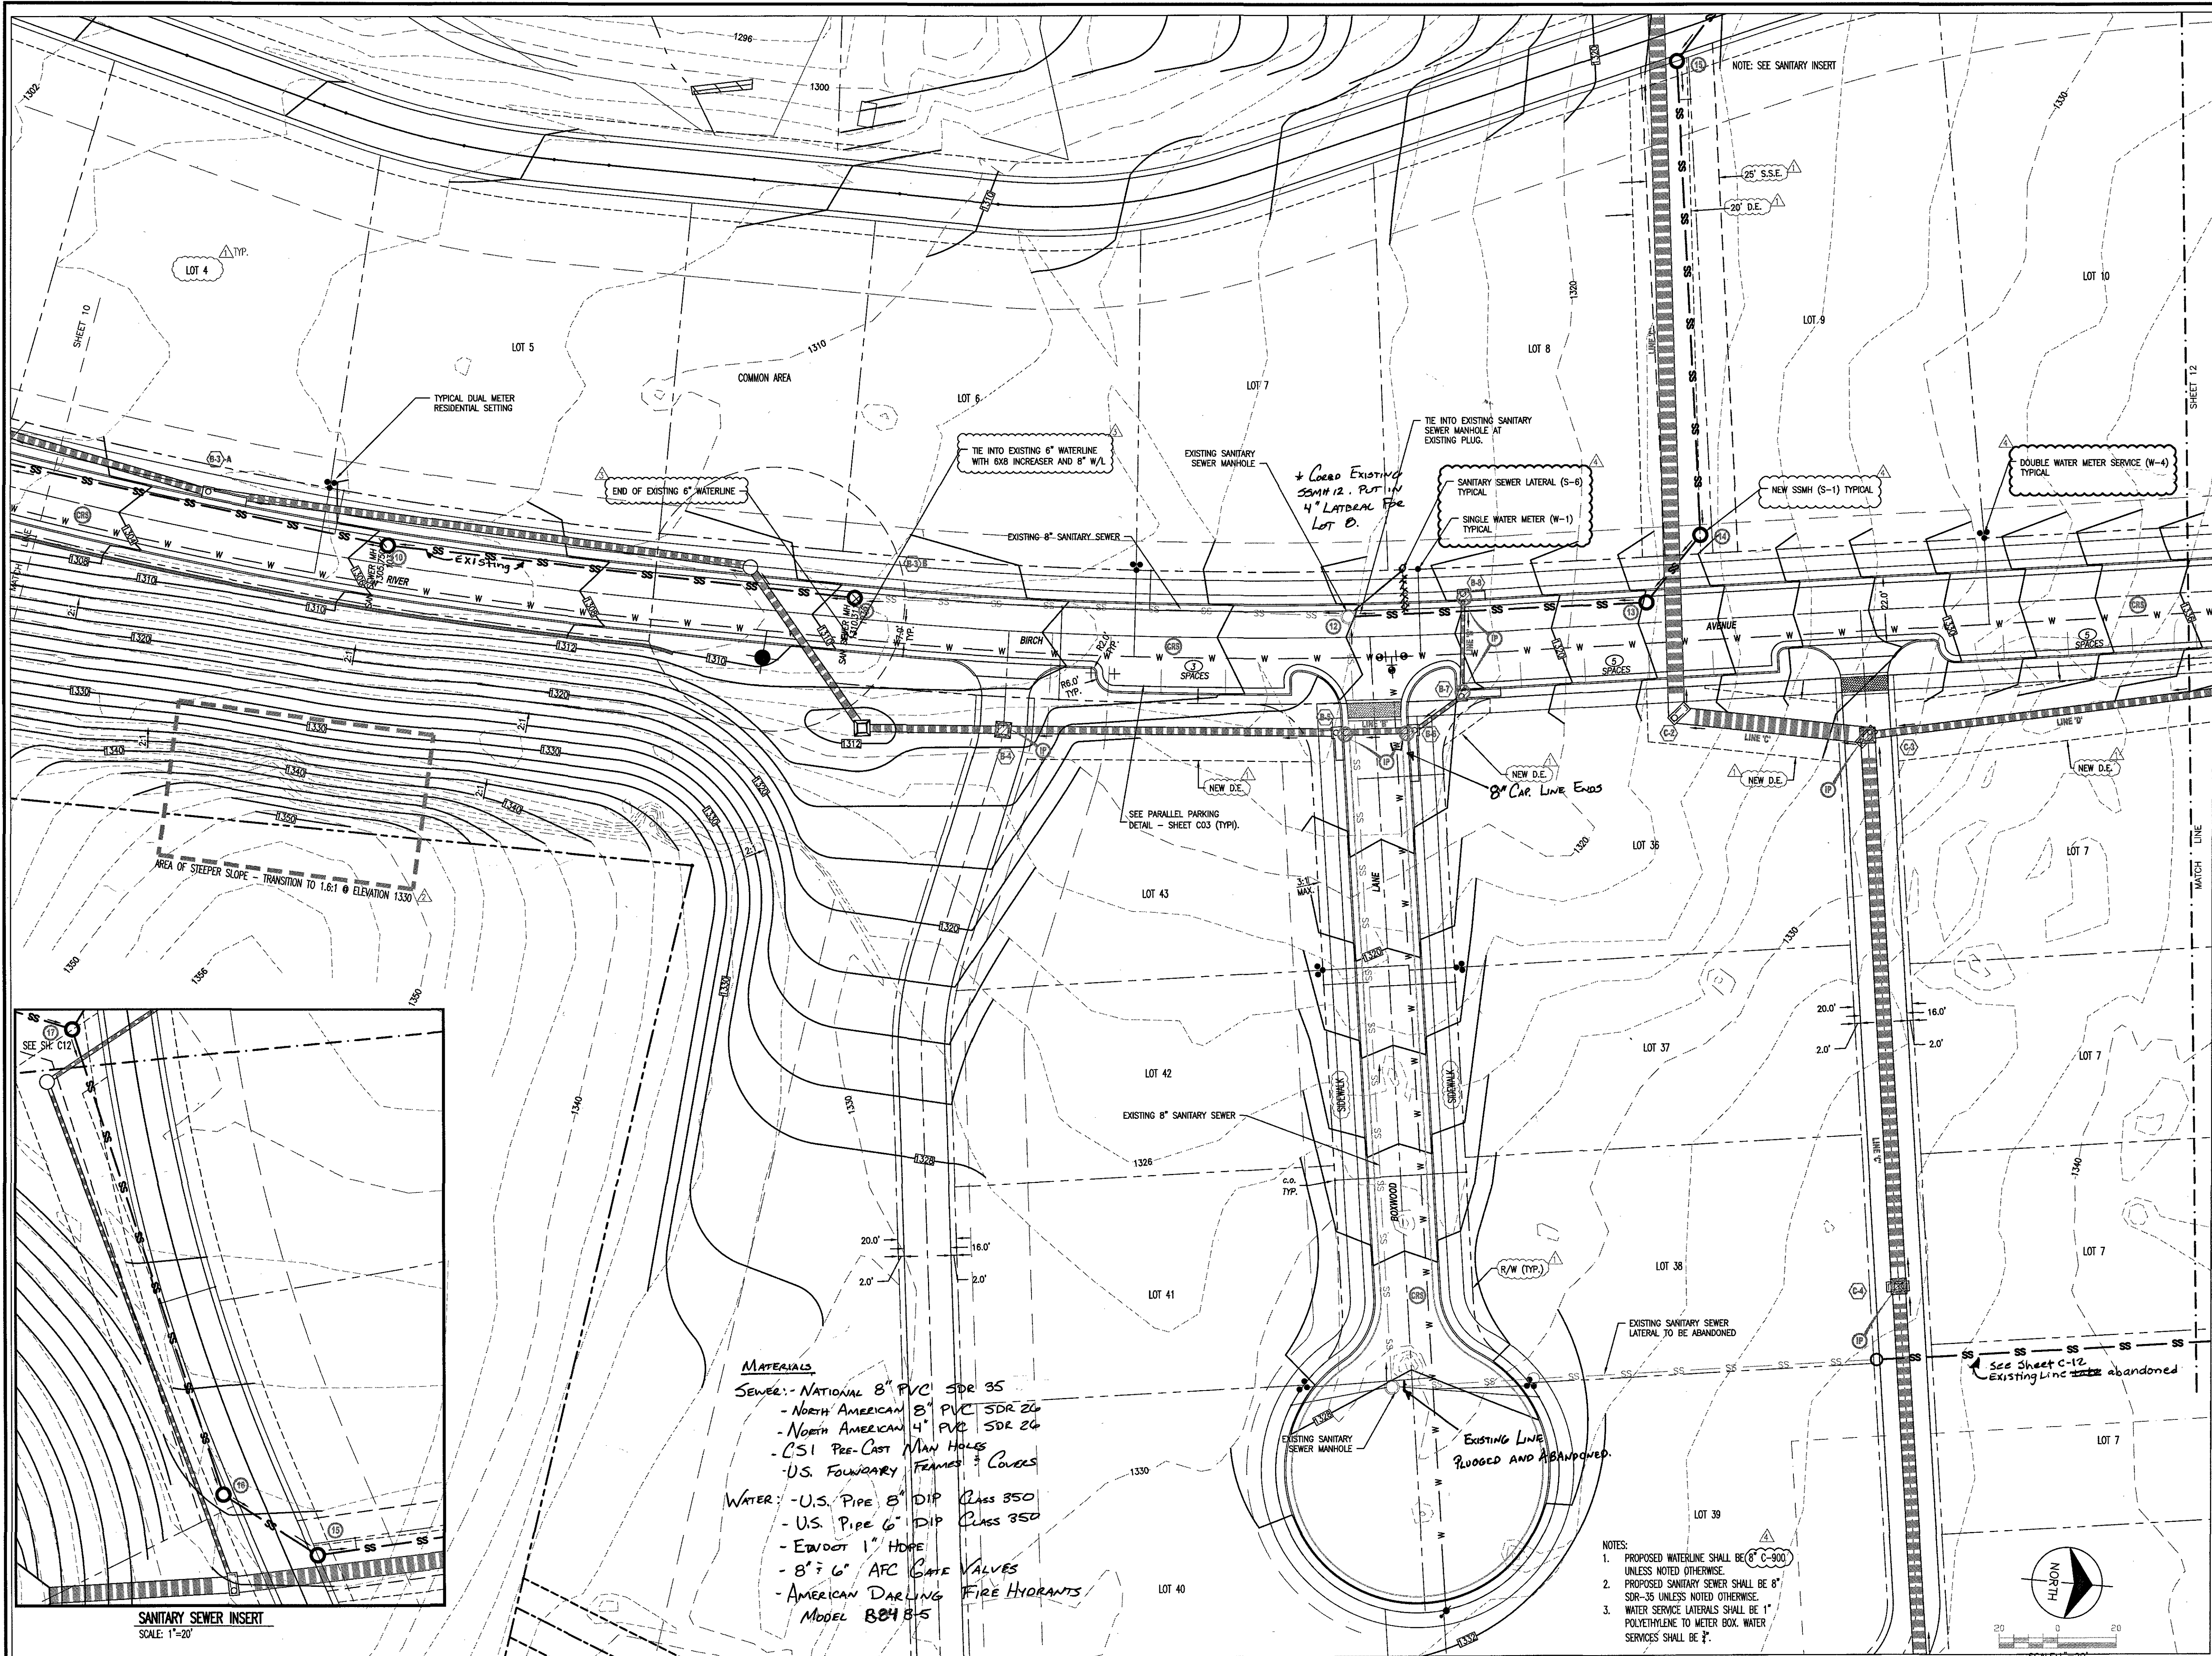

ENGINEERING CONCEPTS, INC.
"Creating Success"
50 GREENWOOD STREET
DALEVILLE, VIRGINIA 22643
540.473.1253

PROJECT: FRALIN AND WALDRON
DALEVILLE TOWN CENTER
DRAWING: COMPREHENSIVE DEVELOPMENT PLAN
SHEET: C-11

DATE	BY	DESCRIPTION
7/21/17	RHW	WMA COMMENTS
7/16/17	RHW	CHANGE WATERLINE TO 8"
3/19/09	MSMJ	REVISED RIVER BRCH REMAINING WALL GRADING
3/9/08	MSMJ	VARIOUS DESIGN DEVELOPMENT REVISIONS

REVISIONS
 MARK DATE
 CHECKED RHW
 DESIGNED RHW
 DRAWN MSMJ
 PROJECT 16089
 DATE 2/14/17