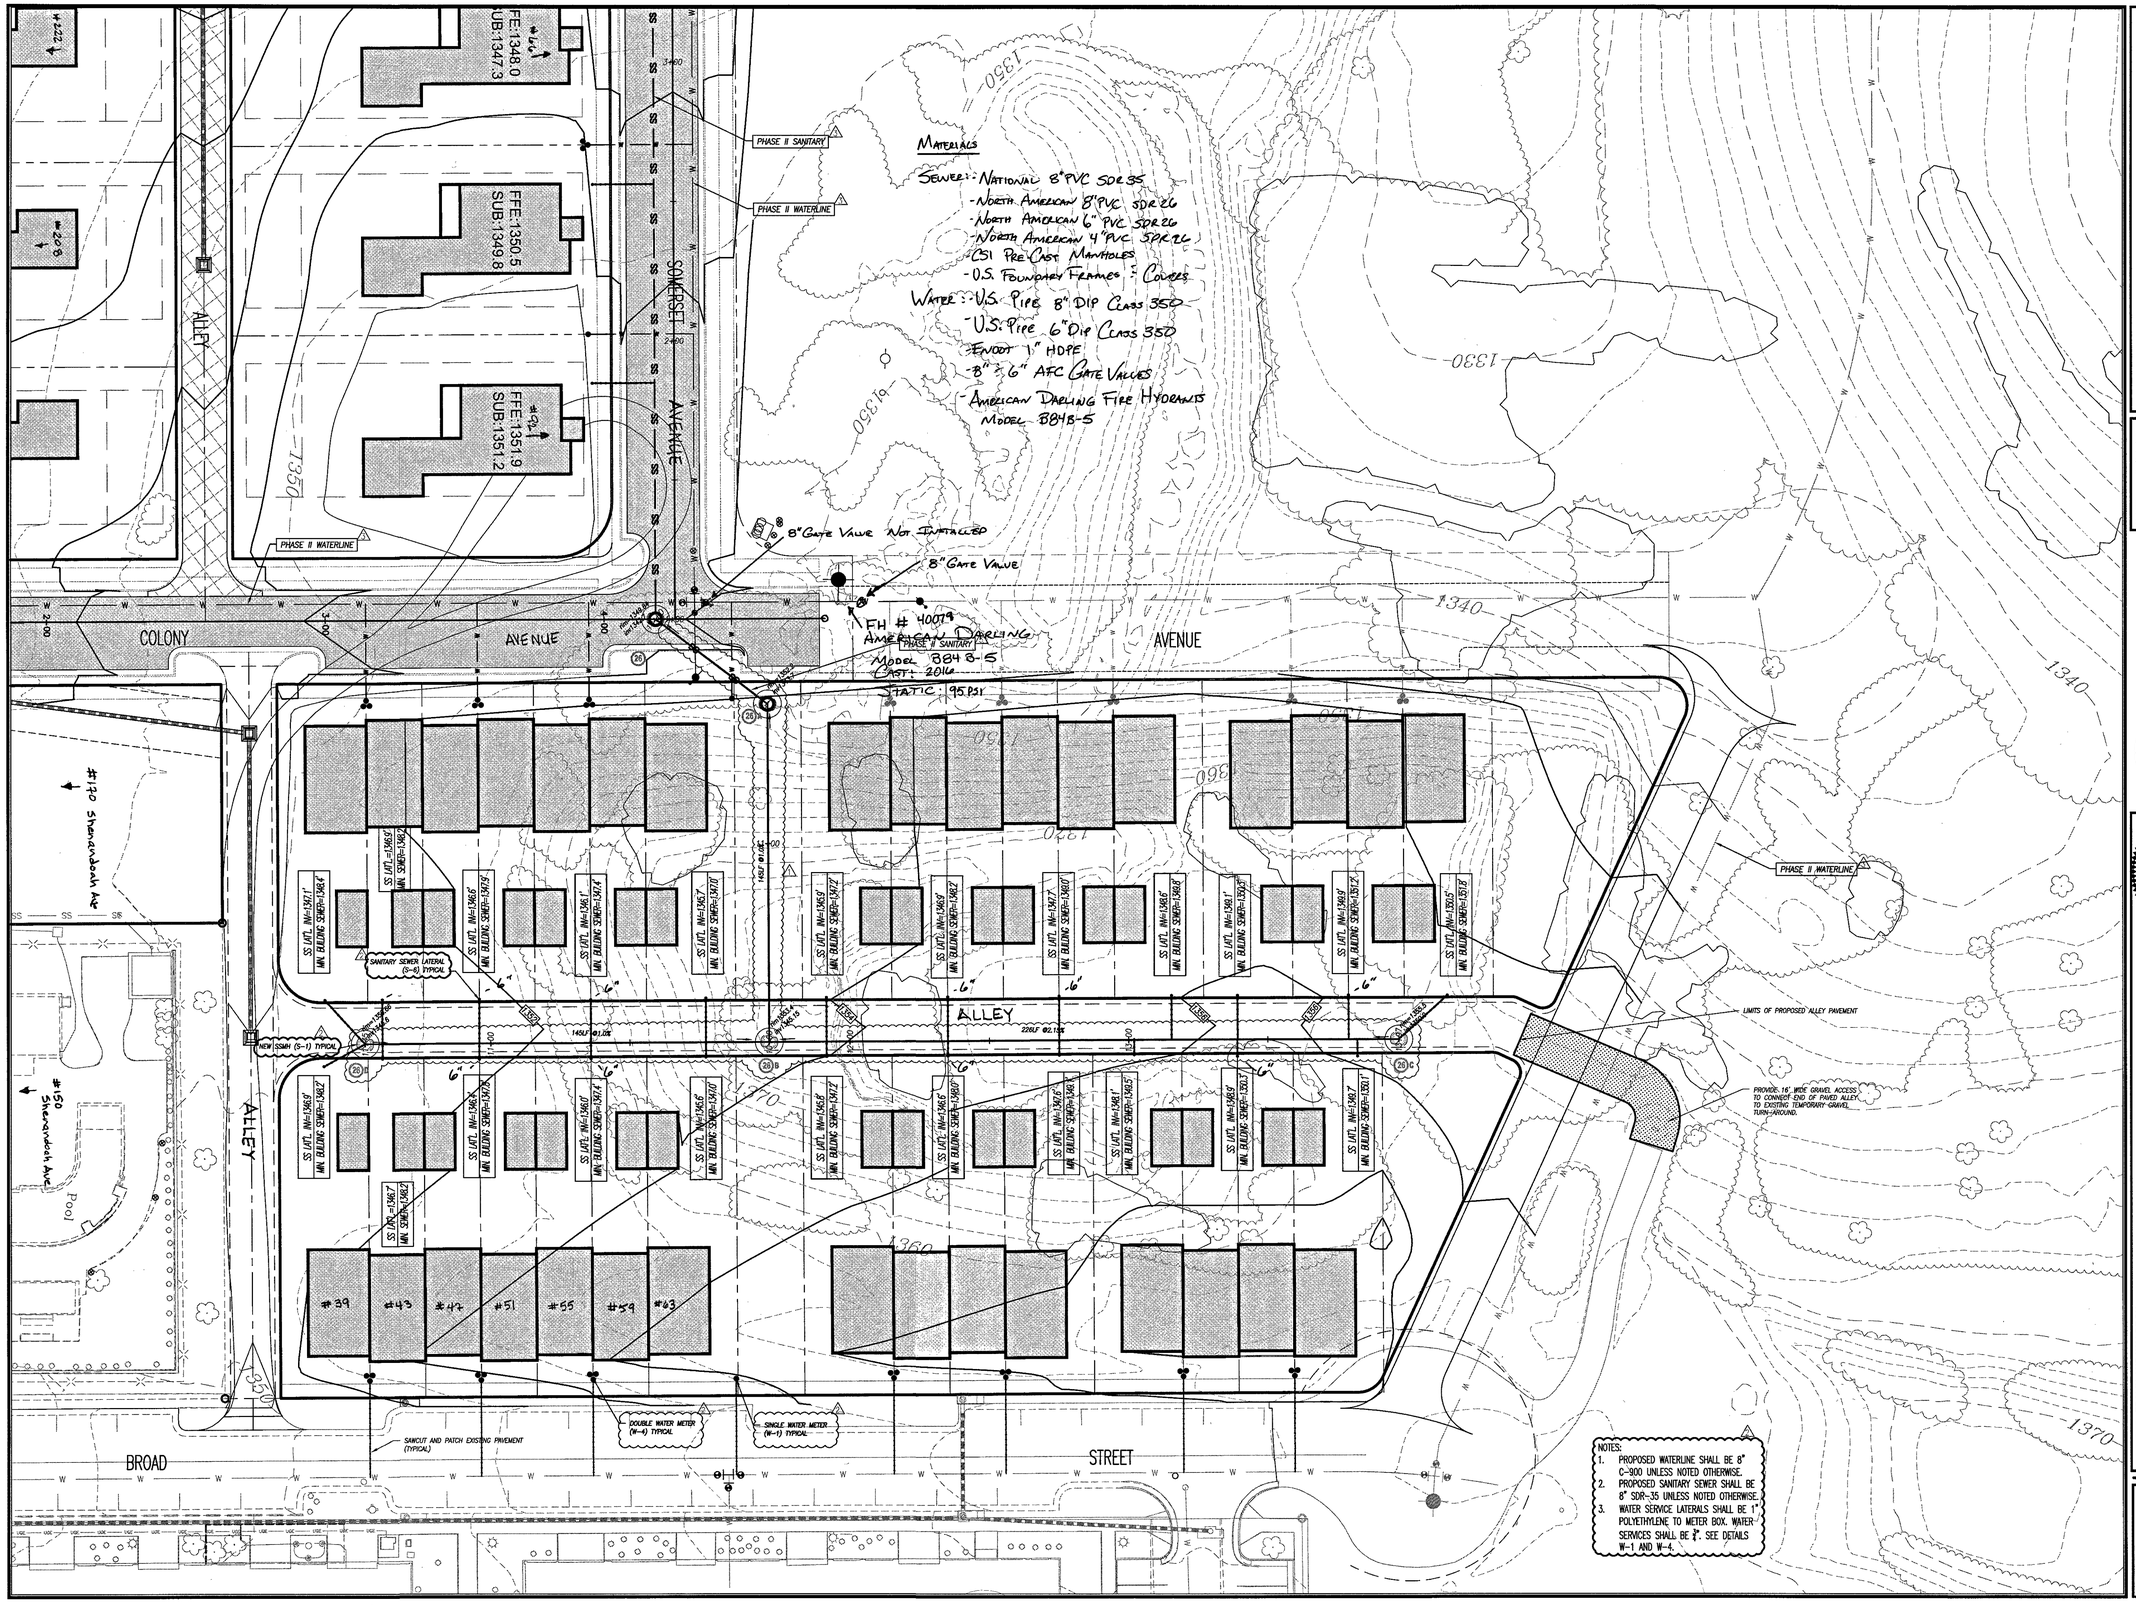


NOTES:
1. PROPOSED WATERLINE SHALL BE 8" C-900 UNLESS NOTED OTHERWISE.
2. PROPOSED SANITARY SEWER SHALL BE 8" SDR-35 UNLESS NOTED OTHERWISE.
3. WATER SERVICE LATERALS SHALL BE 1" POLYETHYLENE TO METER BOX. WATER SERVICES SHALL BE ¾". SEE DETAILS W-1 AND W-4.

| MARK | DATE | BY | DESCRIPTION |
|---|---|---|---|
| 4 | 12/11/17 | MSM | WWA - WATER/SAN. PHASING |
| 3 | 7/21/17 | RHW | WWA COMMENTS |
| 2 | 7/6/17 | RHW | CHANGE WATERLINE SIZE TO 8" |

REVISIONS

DATE 2/14/17
PROJECT 16089
DESIGNED RHW
DRAWN MSMJ
CHECKED RHW

ENGINEERING CONCEPTS, INC.
"Creating Success"
04 Greenfields Street
Daleville, Virginia 24083
540.473.1283

COMMONWEALTH OF VIRGINIA
ROBERT H. WAMPLER, JR.
No. 34713
12/11/17
PROFESSIONAL ENGINEER

PROJECT FRALIN AND WALDRON
DALEVILLE TOWN CENTER

DRAWING PROPOSED TOWNHOME LOT AREA

SHEET
C-15